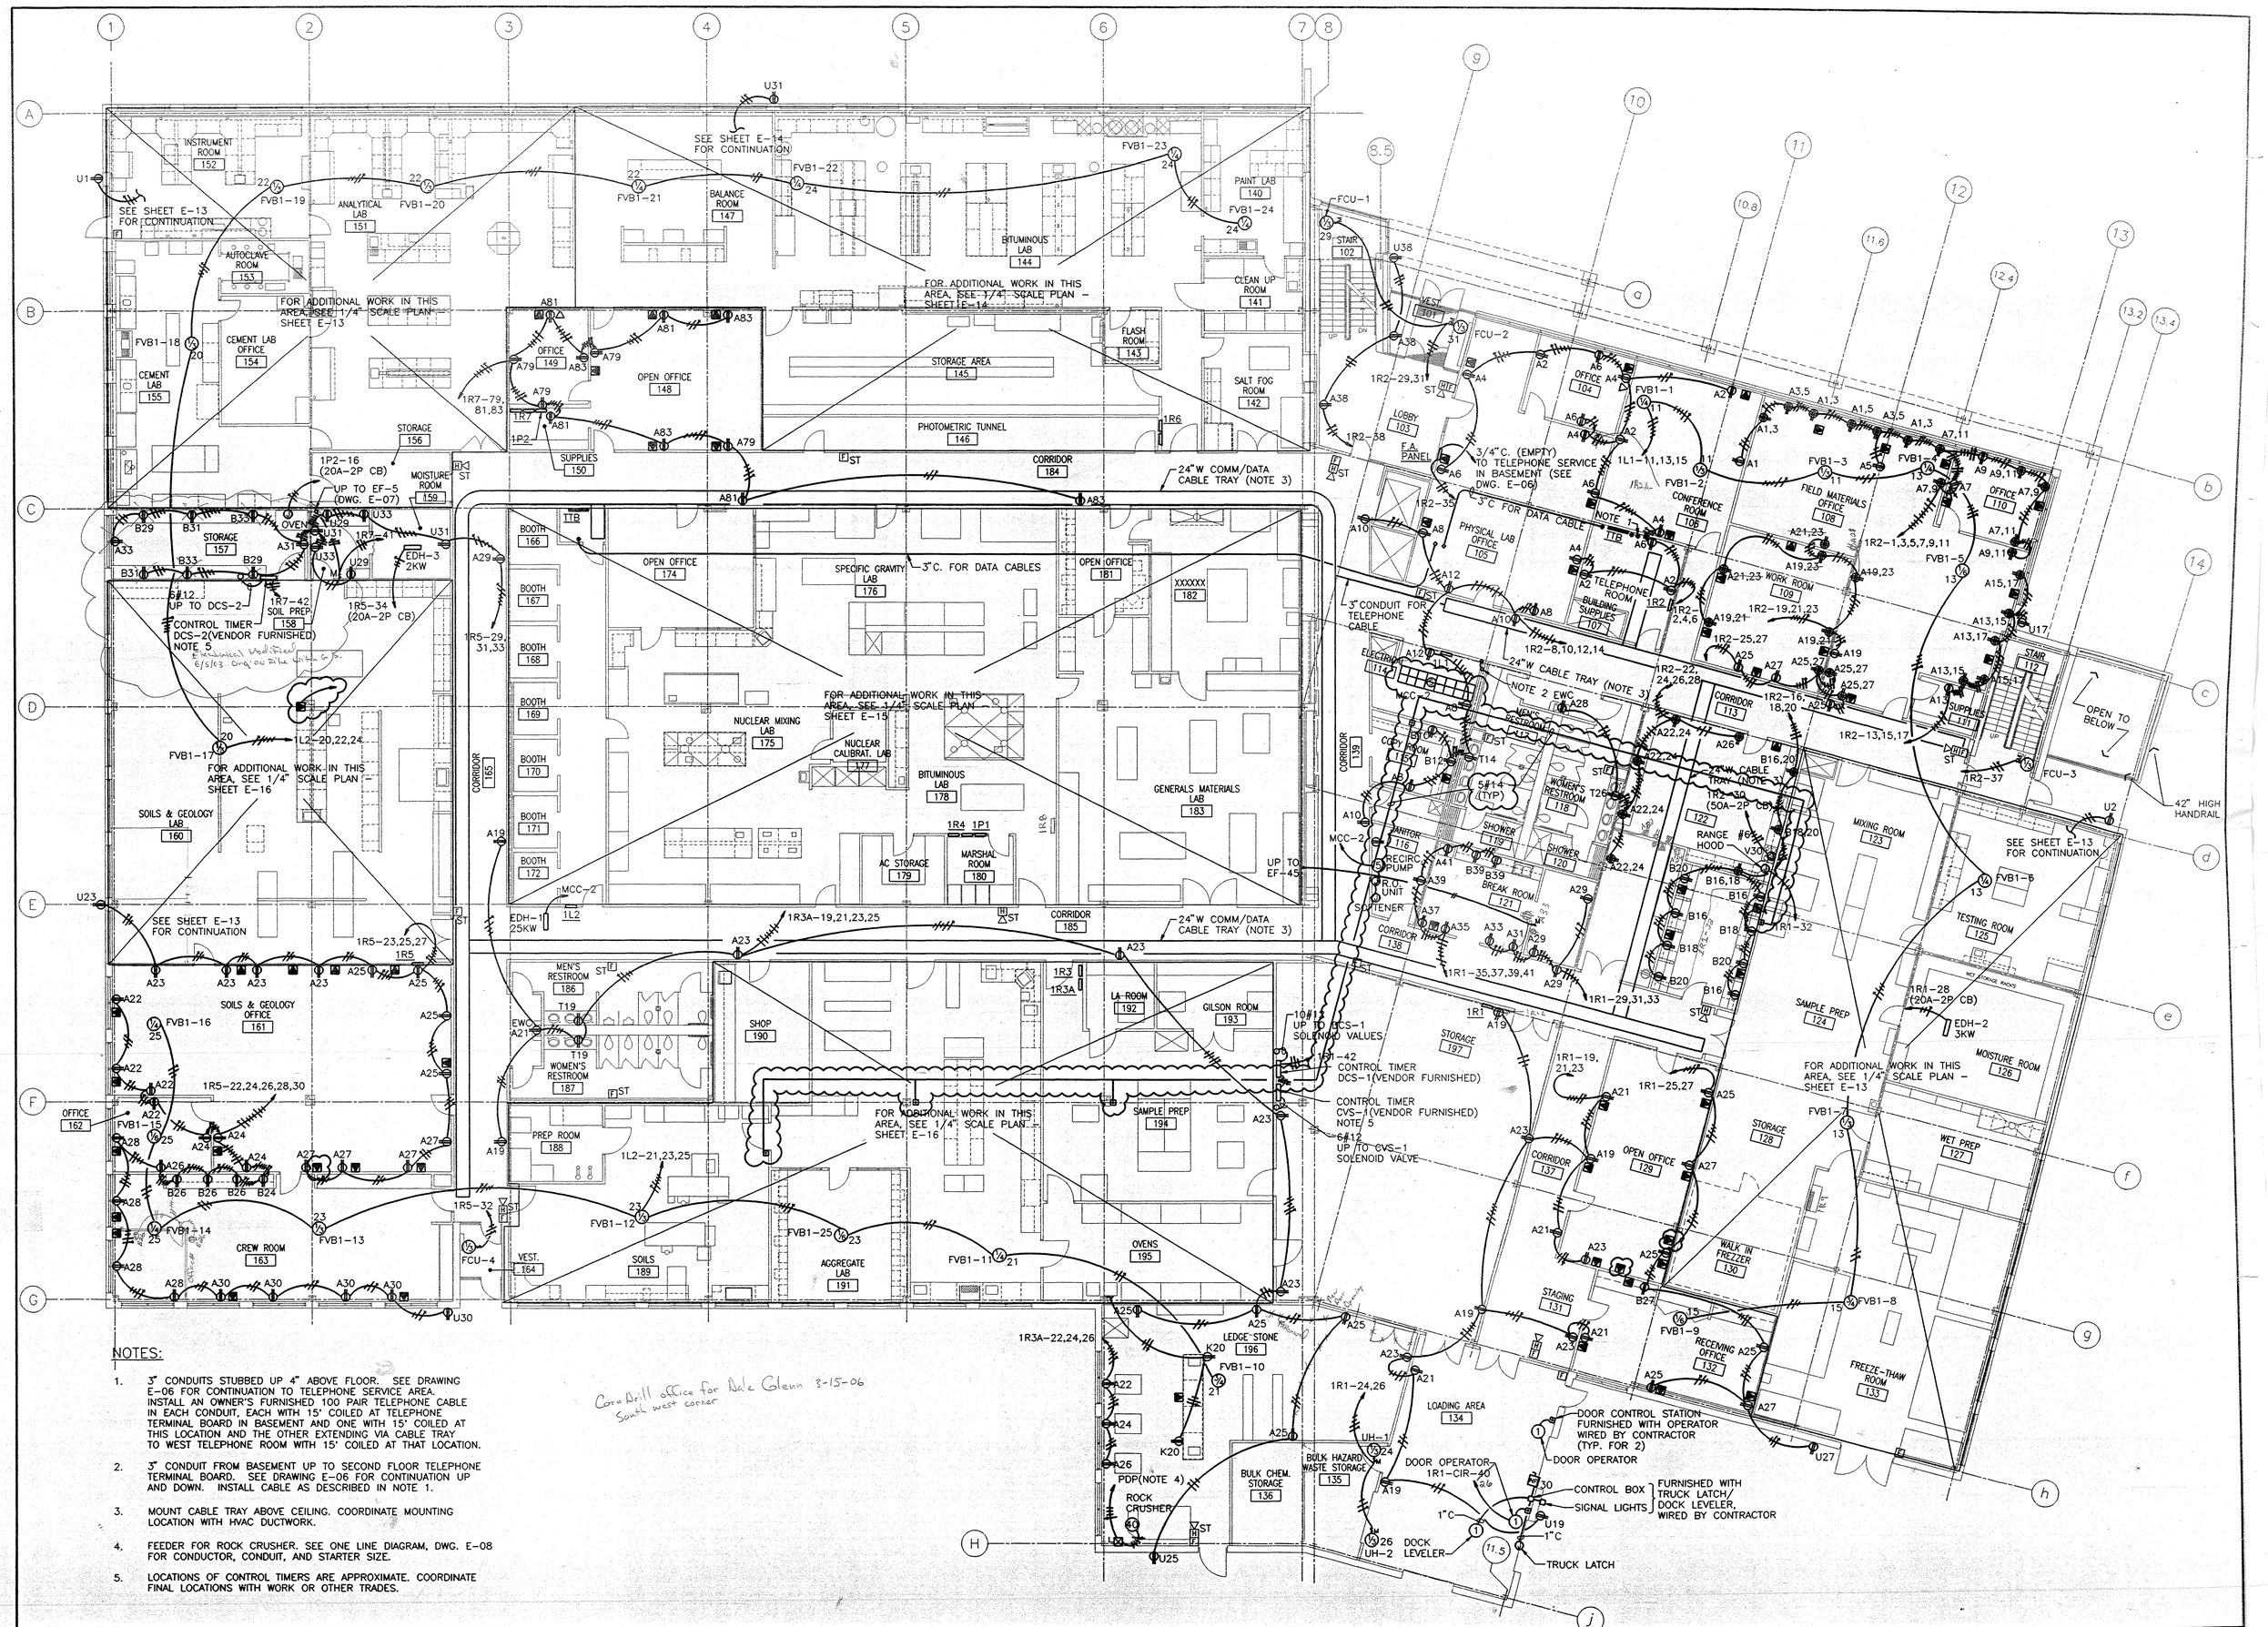

NOTES:

1. 3" CONDUITS STUBBED UP 4" ABOVE FLOOR. SEE DRAWING E-06 FOR CONTINUATION TO TELEPHONE SERVICE AREA. INSTALL AN OWNER'S FURNISHED 100 PAIR TELEPHONE CABLE IN EACH CONDUIT, EACH WITH 15' COILED AT TELEPHONE TERMINAL BOARD IN BASEMENT AND ONE WITH 15' COILED AT THIS LOCATION AND THE OTHER EXTENDING VIA CABLE TRAY TO WEST TELEPHONE ROOM WITH 15' COILED AT THAT LOCATION.
2. 3" CONDUIT FROM BASEMENT UP TO SECOND FLOOR TELEPHONE TERMINAL BOARD. SEE DRAWING E-06 FOR CONTINUATION UP AND DOWN. INSTALL CABLE AS DESCRIBED IN NOTE 1.
3. MOUNT CABLE TRAY ABOVE CEILING. COORDINATE MOUNTING LOCATION WITH HVAC DUCTWORK.
4. FEEDER FOR ROCK CRUSHER. SEE ONE LINE DIAGRAM, DWG. E-08 FOR CONDUCTOR, CONDUIT, AND STARTER SIZE.
5. LOCATIONS OF CONTROL TIMERS ARE APPROXIMATE. COORDINATE FINAL LOCATIONS WITH WORK OR OTHER TRADES.

NO.	DATE	DESCRIPTION OF REVISION OR ISSUE	BY	CK.
	4/25/97	AS BUILT	JDB	JTK

STATE OF MISSOURI
MEL CARNAHAN
GOVERNOR

OFFICE OF ADMINISTRATION
DIVISION OF DESIGN AND CONSTRUCTION
ROBERT W. WHITEHEAD P.E. ACTING DIRECTOR

MISSOURI HIGHWAYS AND TRANSPORTATION DEPARTMENT
WAYNE MURI CHIEF ENGINEER

The Benham Group
Architects Engineers Planners Consultants
1716 Hidden Creek Court
Suite 200
St. Louis, Mo. 63131-1826
(314) 821-7017

DATE 5/12/92
REVISED
DESIGNED BY JTK
DRAWN BY WJB
CHECKED BY SSV

SHEET TITLE
ELECTRICAL
FIRST FLOOR PLAN - POWER

MATERIALS TESTING AND RESEARCH LABORATORY
JEFFERSON CITY, MISSOURI
FOR THE
MISSOURI HIGHWAYS AND TRANSPORTATION DEPARTMENT

PROJECT NO.: 07-605-91-0001(B) ACCOUNT NO.: 605-69187-9551, 605-06729-0672

229004501
E-05
SHEET 70 OF 81
DATE ISSUED JULY 14, 1993

Drawing: L:\79004500\OLD\0045E005 Saved: 04/29/1997 17:02 By: JCC DimScale: 96.00 (TM=1)

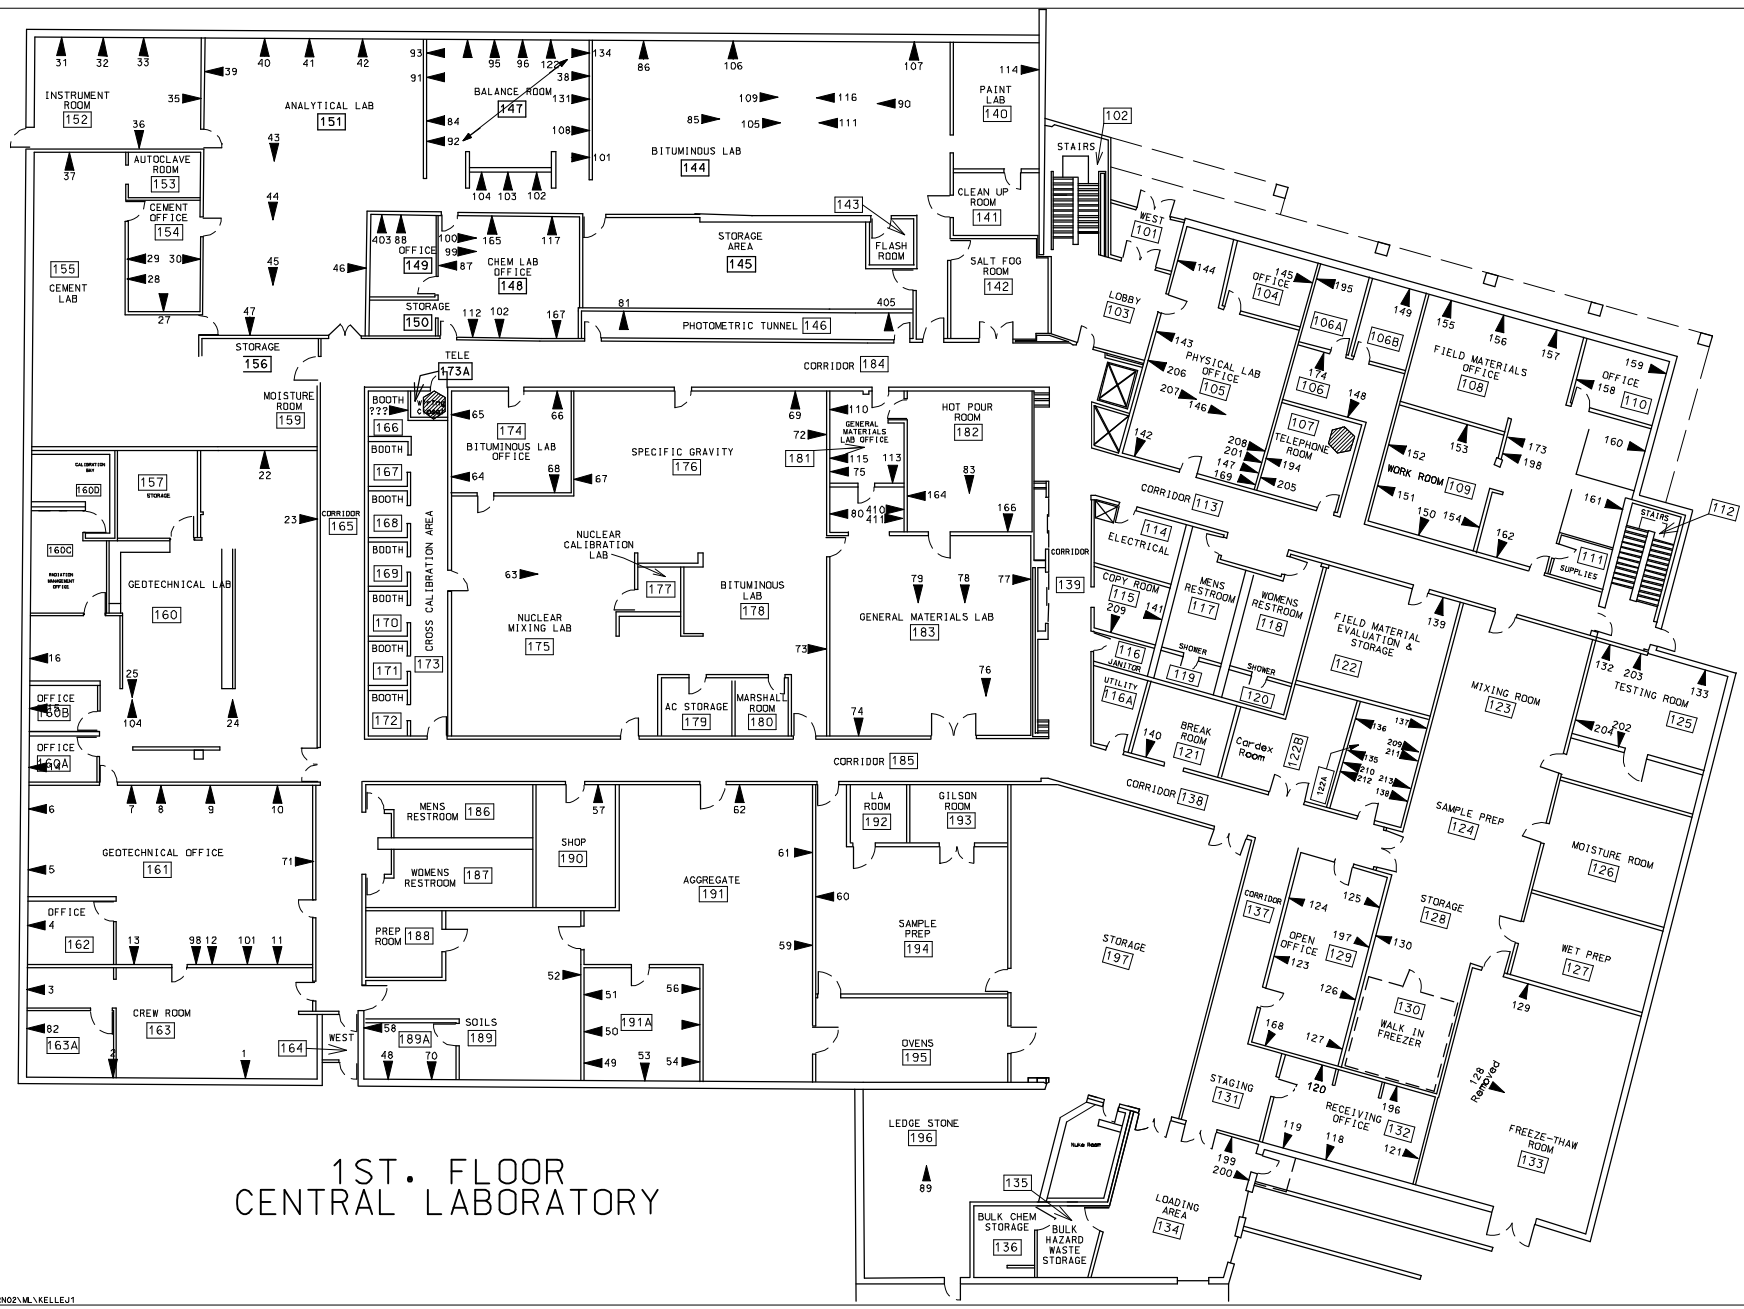

1ST. FLOOR
CENTRAL LABORATORY

PATH: J:\KELLEJ1 OR PATH: \\MRNO2\ML\KELLEJ1

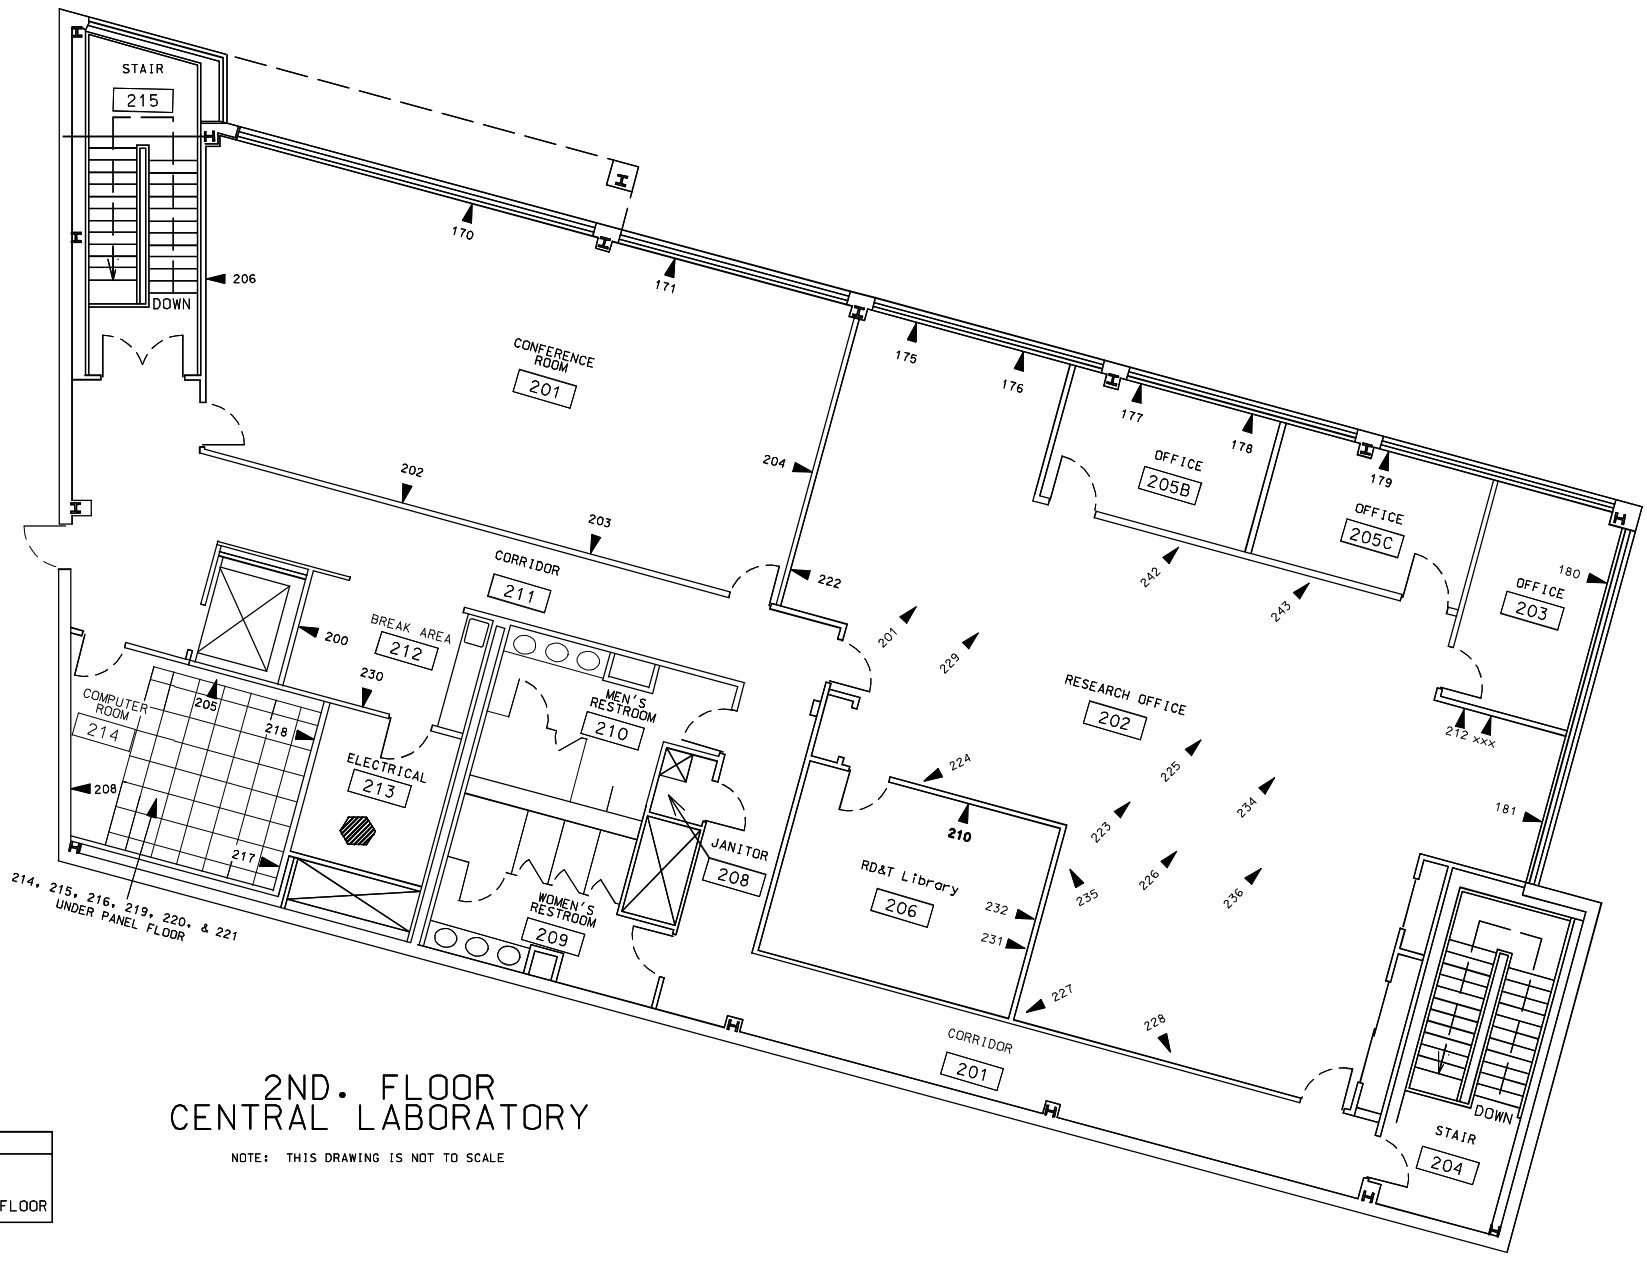

2ND. FLOOR
CENTRAL LABORATORY

NOTE: THIS DRAWING IS NOT TO SCALE

LEGEND
◄ = NETWORK PORT LOCATION
??? = ROOM NUMBER
▨ = DOESN'T EXIST ON 2ND. FLOOR