ROUTE	STATE	DISTRICT
I-64	MO	6
JOB NO.	J6I0978	
COUNTY	STLCO/STLCITY	

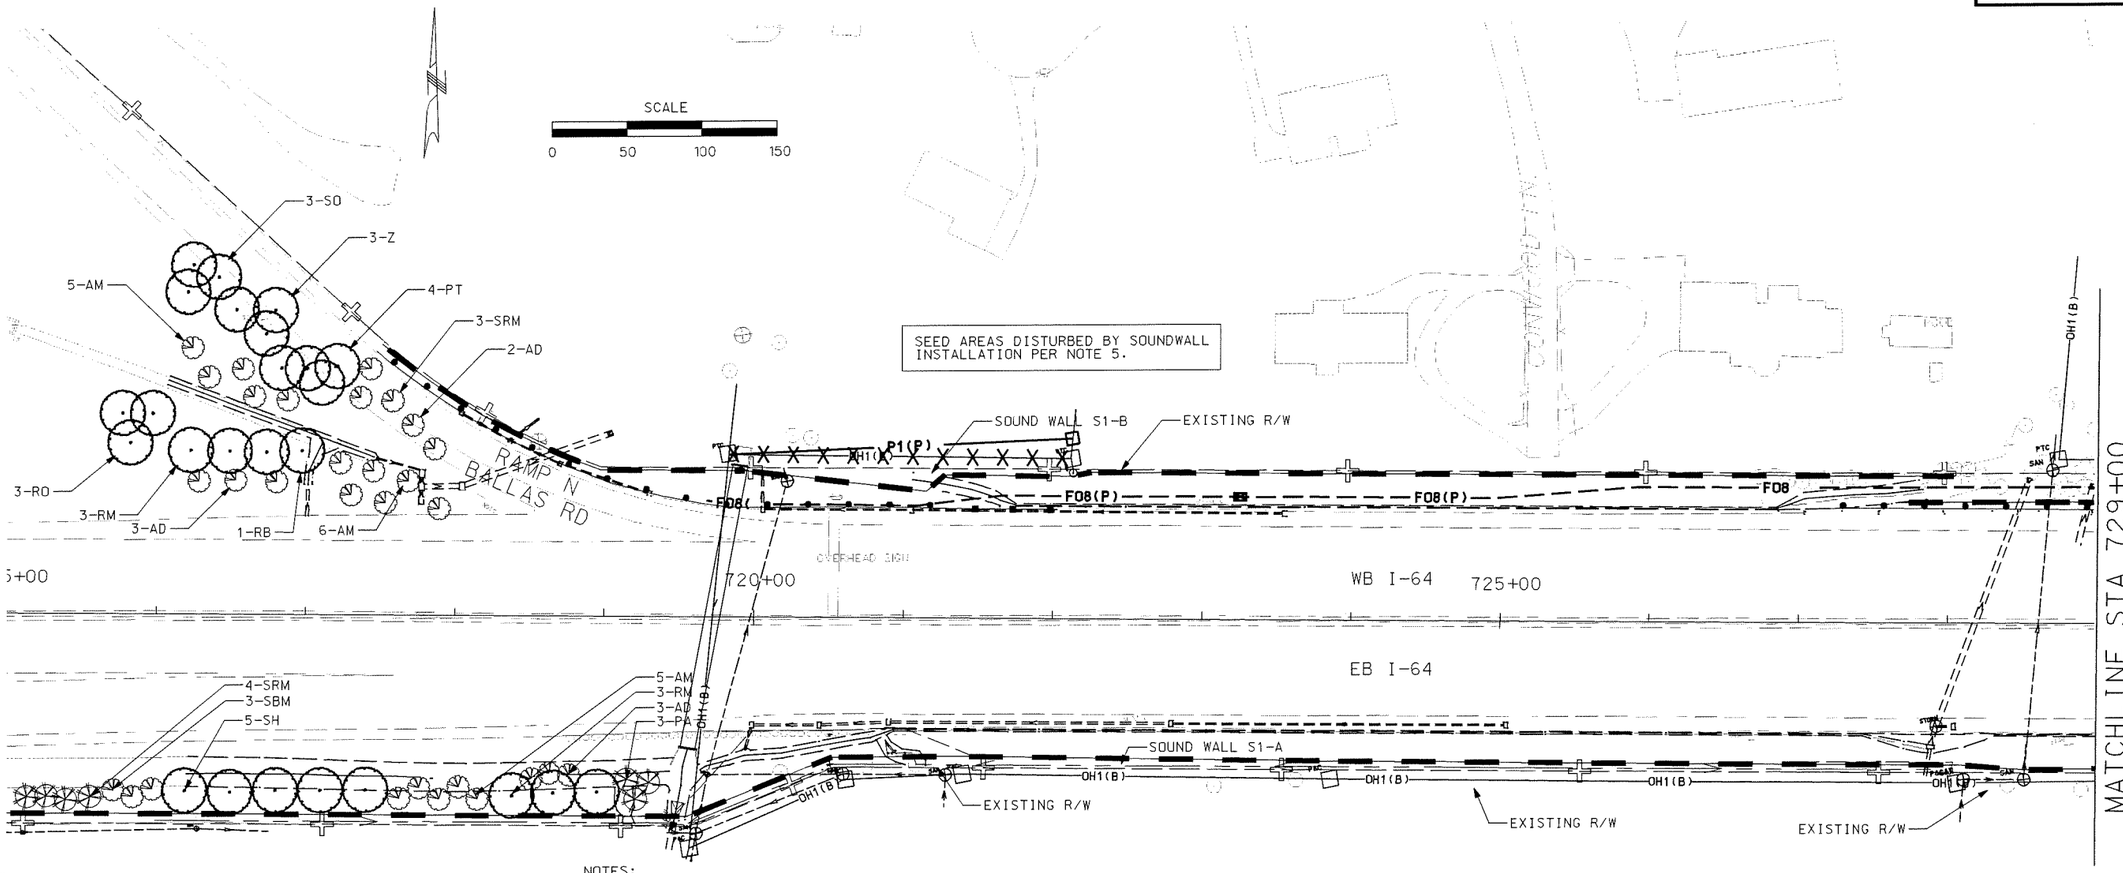

NOTES:
1. SEE STANDARD PLANS FOR GENERAL PLANTING AND SEEDING DETAILS AND NOTES.
2. SEE DRAINAGE PLANS - SHEETS DRDT012-016 FOR VEGATIVE COVER MATRIX WITH DITCHES. EXCLUDE ANY SEEDING WITHIN CONCRETE OR ROCK LINED DITCHES AS SHOWN ON DRAINAGE PLANS
3. SEE PAVING DRAWINGS FOR LOCATIONS OF SLOPE PAVING.
4. ALL SHRUBS TO BE CONTAINED WITHIN MULCH BEDS FOLLOWING GENERAL SHAPE SHOWN IN LANDSCAPE DRAWINGS.
5. SEEDING SHOWN TO SLOPE LIMITS UNLESS OTHERWISE SHOWN.
6. CONTRACTOR TO TREAT AREAS DISTURBED BY SOUND WALL INSTALLATION NOT SHOWN ON PLANS AS FOLLOWED:
   A. SCOTISH MIX - BACK OF WALL OR ON SLOPES GREATER THAN 3:1
   B. MODOT MIX - FACE OF WALL ON SLOPES LESS THAN 3:1
   C. PER DITCH DETAIL MATRIX WITHIN DITCHES.

NOTES:
7. TREES TO BE PLANTED MIN. 8' FROM FACE OF ANY WALL IN NON-MOWED AREAS, AND A MIN. 10' FORM ANY WALL, FENCE, OR GUARDRAIL IN MOWED AREA. ALL PLANTINGS TO MAINTAIN MIN. 24" CLEARANCE (SHRUBS) AND 5' MIN. CLEARANCE (TREES) WHERE UTILITIES, INCLUDING FIBER OPTIC LINES RUN THROUGH LANDSCAPE PLANTINGS AREAS.
8. ANY PLANTING THAT COMES IN CONFLICT WITH UTILITIES OR OTHER ELEMENTS MAY BE RELOCATED BY CONTRACTOR WITHIN APPROXIMATELY 10' OF ITS ORIGINAL LOCATION AND IS CONSIDERED A MINOR CHANGE. THE CONTRACTOR SHALL ENDEAVOR TO PRESERVE THE GENERAL LAYOUT OF EACH GROUP OF PLANTINGS AND SYMMETRY OF ADJACENT PLANTING GROUPS IN MAKING SUCH ADJUSTMENTS. PROPOSED CHANGES EXCEEDING THESE LIMITS SHALL BE SUBMITTED BY FDC FOR APPROVAL BY THE LANDSCAPE ARCHITECT.
9. TREES PLANTED ON SLOPES 3:1 OR FLATTER SHALL BE SPACED A MINIMUM OF 25' ON-CENTER. TREES ON STEEPER SLOPES MAY BE SPACED UP TO 15' ON-CENTER, DEPENDING ON DESIGN SHOWN ON PLANS. TREES MAY BE SPACED CLOSER TOGETHER IN 3:1 AND FLATTER AREAS IF THEY ARE PLACED IN MULCH OR SHRUB BEDS.
10. ALL TREES MUST BE 30' AWAY FROM EDGE OF TRAVELWAY FOR I-64 AND 20' AWAY FROM EDGE OF TRAVELWAY FOR RAMPS.

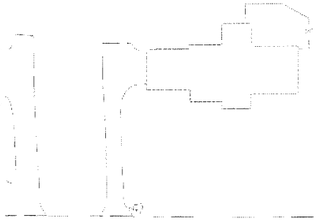

LANDSCAPE PLAN LEGEND:
- SOD
- TURF SEED MIX
- MODOT SEED MIX
- NATIVE SEED MIX
- SCOTISH SEED MIX
- ROCK

SEED AREAS DISTURBED BY SOUNDWALL INSTALLATION PER NOTE 5.

MY RESPONSIBILITY COVERS ONLY THE INFORMATION IN THE CLOUDED AREAS. SEE ORIGINAL RFC SET FOR ORIGINAL STAMP AND SIGNATURE.

DESIGNED BY: DSJ	ISSUE RECORD		
	NO.	DESCRIPTION	DATE
DRAFTED BY: DSJ	B	70% PLAN REVIEW SUBMITTAL	17JULY07
	C	90% PLAN REVIEW SUBMITTAL	28SEPT07
	1	RELEASED FOR CONSTRUCTION	15NOV07
CHECKED BY: JRL	2	RFC FDC 497 ADDITIONAL TREE PLANTINGS	10OCT08
	AB	AS-BUILT FDC-497	09JUN10

PARSONS

Gateway Constructors
Granite • Fred Weber • Millstone Bangert

THE NEW I-64

THE NEW I-64 PROJECT
SEGMENT 1
LANDSCAPE PLAN
I-64
STA 715+00 TO STA 729+00

MoDOT

DRAWING NUMBER
LPPL001

AS-BUILT

File Name: C:\EXPORT\ITEMP\001_LPPL_I100_S1.DGN
User: PARSONS
Time Plotted: 10:51:44 AM
Date Plotted: 7/16/2010
Pen Table: I-64_HALFSIZEBW-DATE.TBLPlot Driver: 11X17_PDF_AB.PLT

ROUTE	STATE	DISTRICT
I-64	MO	6
JOB NO.	J6I0978	
COUNTY	STLCO/STLCITY	

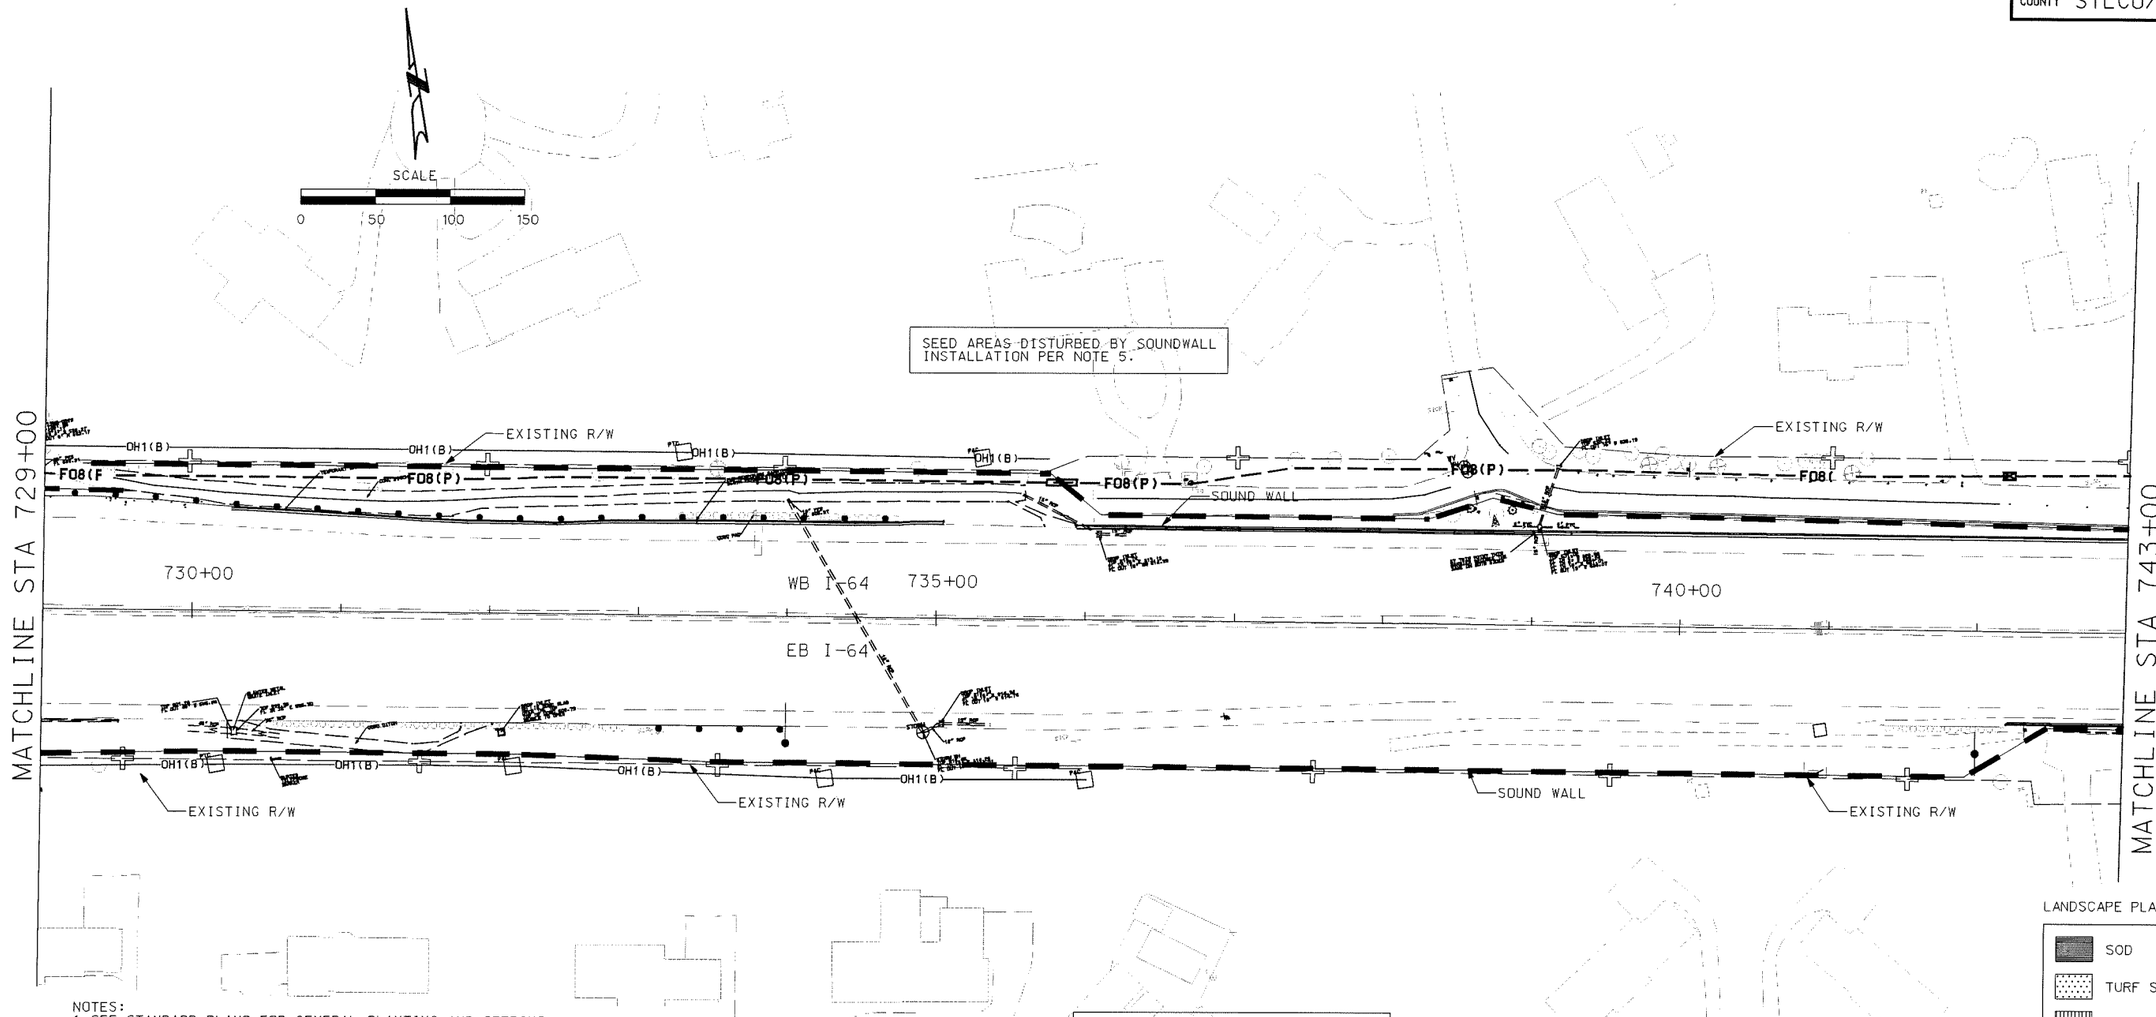

LANDSCAPE PLAN LEGEND:

- SOD
- TURF SEED MIX
- MODOT SEED MIX
- NATIVE SEED MIX
- SCOTISH SEED MIX
- ROCK

NOTES:

1. SEE STANDARD PLANS FOR GENERAL PLANTING AND SEEDING DETAILS AND NOTES.
2. SEE DRAINAGE PLANS - SHEETS DRDT012-016 FOR VEGATIVE COVER MATRIX WITH DITCHES. EXCLUDE ANY SEEDING WITHIN CONCRETE OR ROCK LINED DITCHES AS SHOWN ON DRAINAGE PLANS
2. SEE PAVING DRAWINGS FOR LOCATIONS OF SLOPE PAVING.
3. ALL SHRUBS TO BE CONTAINED WITHIN MULCH BEDS FOLLOWING GENERAL SHAPE SHOWN IN LANDSCAPE DRAWINGS.
4. SEEDING SHOWN TO SLOPE LIMITS UNLESS OTHERWISE SHOWN.
5. CONTRACTOR TO TREAT AREAS DISTURBED BY SOUND WALL INSTALLATION NOT SHOWN ON PLANS AS FOLLOWED:
   A. SCOTISH MIX - BACK OF WALL OR ON SLOPES GREATER THAN 3:1
   B. MODOT MIX - FACE OF WALL ON SLOPES LESS THAN 3:1
   C. PER DITCH DETAIL MATRIX WITHIN DITCHES.

DESIGNED BY:	DRAFTED BY:	CHECKED BY:

ISSUE RECORD

NO.	DESCRIPTION	DATE
A	50% PLAN REVIEW SUBMITTAL	04MAY07
B	70% PLAN REVIEW SUBMITTAL	17JULY07
C	90% FINAL DESIGN	28SEPT07
1	RELEASED FOR CONSTRUCTION	15NOV07
AB	AS-BUILT	09JUN10

PARSONS

Gateway Constructors
Granite • Fred Weber • Millstone Bangert

THE NEW I-64

THE NEW I-64 PROJECT

SEGMENT 1
LANDSCAPE PLAN
I-64
STA 729+00 TO STA 743+00

MoDOT

DRAWING NUMBER
LPPL002

AS-BUILT

File Name: C:\EXPORT\ITEMP\002_LPPL_I1100_S1.DGN
User: PARSONS
Time Plotted: 10:51:51 AM
Date Plotted: 7/16/2010
Pen Table: I-64_HALFSIZEBW-DATE.TBL
Plot Driver: 11X17_PDF_AB.PLT

ROUTE	STATE	DISTRICT
I-64	MO	6
JOB NO.	J6I0978	
COUNTY	STLCO/STLCITY	

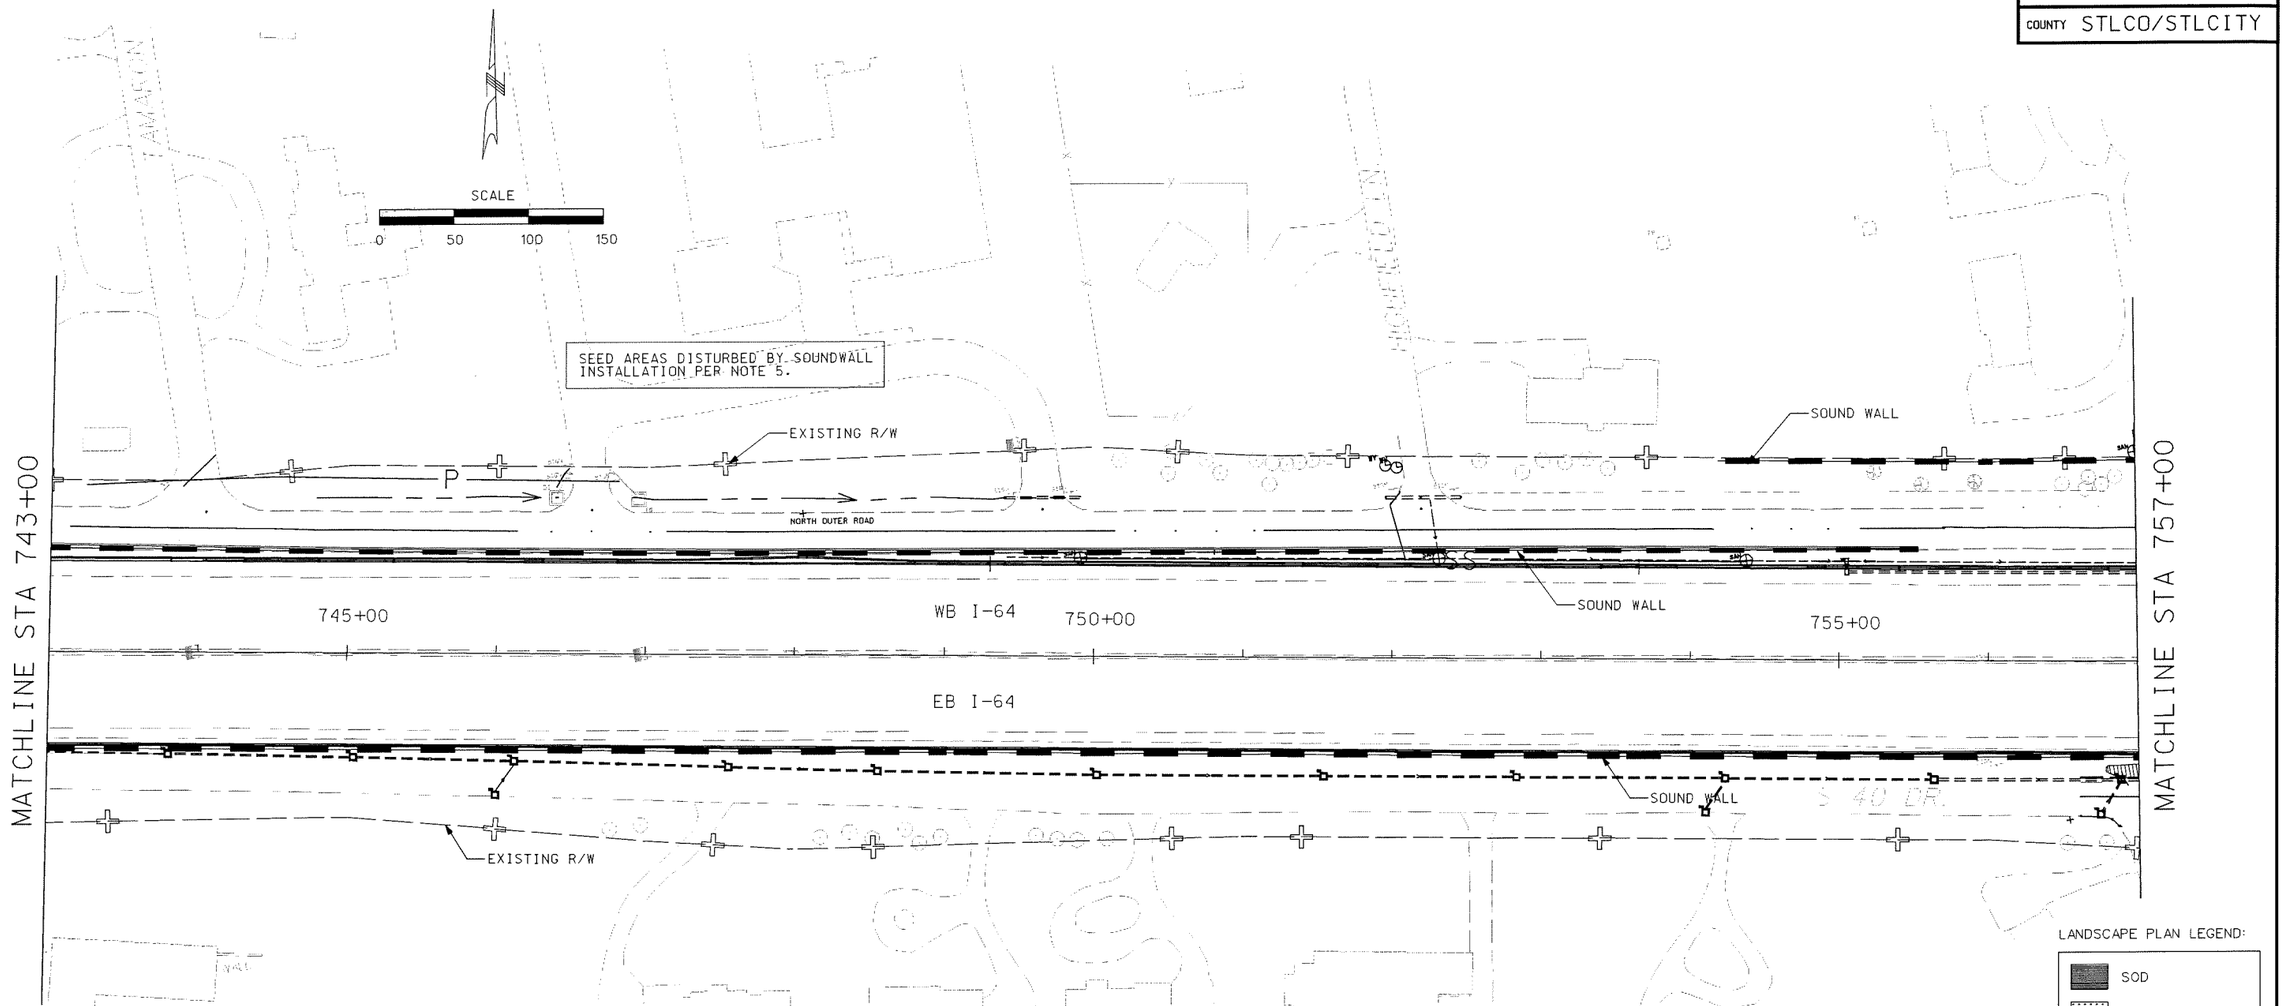

NOTES:
1. SEE STANDARD PLANS FOR GENERAL PLANTING AND SEEDING DETAILS AND NOTES.
2. SEE DRAINAGE PLANS – SHEETS DRDT012-016 FOR VEGATIVE COVER MATRIX WITH DITCHES. EXCLUDE ANY SEEDING WITHIN CONCRETE OR ROCK LINED DITCHES AS SHOWN ON DRAINAGE PLANS
2. SEE PAVING DRAWINGS FOR LOCATIONS OF SLOPE PAVING.
3. ALL SHRUBS TO BE CONTAINED WITHIN MULCH BEDS FOLLOWING GENERAL SHAPE SHOWN IN LANDSCAPE DRAWINGS.
4. SEEDING SHOWN TO SLOPE LIMITS UNLESS OTHERWISE SHOWN.
5. CONTRACTOR TO TREAT AREAS DISTURBED BY SOUND WALL INSTALLATION NOT SHOWN ON PLANS AS FOLLOWED:
   A. SCOTISH MIX – BACK OF WALL OR ON SLOPES GREATER THAN 3:1
   B. MODOT MIX – FACE OF WALL ON SLOPES LESS THAN 3:1
   C. PER DITCH DETAIL MATRIX WITHIN DITCHES.

LANDSCAPE PLAN LEGEND:
- SOD
- TURF SEED MIX
- MODOT SEED MIX
- NATIVE SEED MIX
- SCOTISH SEED MIX
- ROCK

DESIGNED BY:	ISSUE RECORD		
	NO.	DESCRIPTION	DATE
DRAFTED BY:	A	50% PLAN REVIEW SUBMITTAL	04MAY07
	B	70% PLAN REVIEW SUBMITTAL	17JULY07
	C	90% FINAL DESIGN	28SEPT07
CHECKED BY:	1	RELEASED FOR CONSTRUCTION	15NOV07
	AB	AS-BUILT	09JUN10

PARSONS

Gateway Constructors
Granite • Fred Weber • Millstone Bangert

THE NEW I-64

THE NEW I-64 PROJECT

SEGMENT 1
LANDSCAPE PLAN
I-64
STA 743+00 TO STA 757+00

MoDOT

DRAWING NUMBER
LPPL003

AS-BUILT

File Name: C:\EXPORT\ITEMP\003_LPPL_I100_S1.DGN
User: PARSONS
Time Plotted: 10:51:56 AM
Date Plotted: 7/16/2010
Pen Table: I-64_HALFSIZEBW-DATE.TBLPlot Driver: 11X17_PDF_AB.PLT

ROUTE	STATE	DISTRICT
I-64	MO	6
JOB NO.	J6I0978	
COUNTY	STLCO/STLCITY	

NOTES:

7. TREES TO BE PLANTED MIN. 8' FROM FACE OF ANY WALL IN NON-MOWED AREAS, AND A MIN. 10' FORM ANY WALL, FENCE, OR GUARDRAIL IN MOWED AREA. ALL PLANTINGS TO MAINTAIN MIN. 24" CLEARANCE (SHRUBS) AND 5' MIN. CLEARANCE (TREES) WHERE UTILITIES, INCLUDING FIBER OPTIC LINES RUN THROUGH LANDSCAPE PLANTINGS AREAS.

8. ANY PLANTING THAT COMES IN CONFLICT WITH UTILITIES OR OTHER ELEMENTS MAY BE RELOCATED BY CONTRACTOR WITHIN APPROXIMATELY 10' OF ITS ORIGINAL LOCATION AND IS CONSIDERED A MINOR CHANGE. THE CONTRACTOR SHALL ENDEAVOR TO PRESERVE THE GENERAL LAYOUT OF EACH GROUP OF PLANTINGS AND SYMMETRY OF ADJACENT PLANTING GROUPS IN MAKING SUCH ADJUSTMENTS. PROPOSED CHANGES EXCEEDING THESE LIMITS SHALL BE SUBMITTED BY FDC FOR APPROVAL BY THE LANDSCAPE ARCHITECT.

9. TREES PLANTED ON SLOPES 3:1 OR FLATTER SHALL BE SPACED A MINIMUM OF 25' ON-CENTER. TREES ON STEEPER SLOPES MAY BE SPACED UP TO 15' ON-CENTER, DEPENDING ON DESIGN SHOWN ON PLANS. TREES MAY BE SPACED CLOSER TOGETHER IN 3:1 AND FLATTER AREAS IF THEY ARE PLACED IN MULCH OR SHRUB BEDS.

10. ALL TREES MUST BE 30' AWAY FROM EDGE OF TRAVELWAY FOR I-64 AND 20' AWAY FROM EDGE OF TRAVELWAY FOR RAMPS.

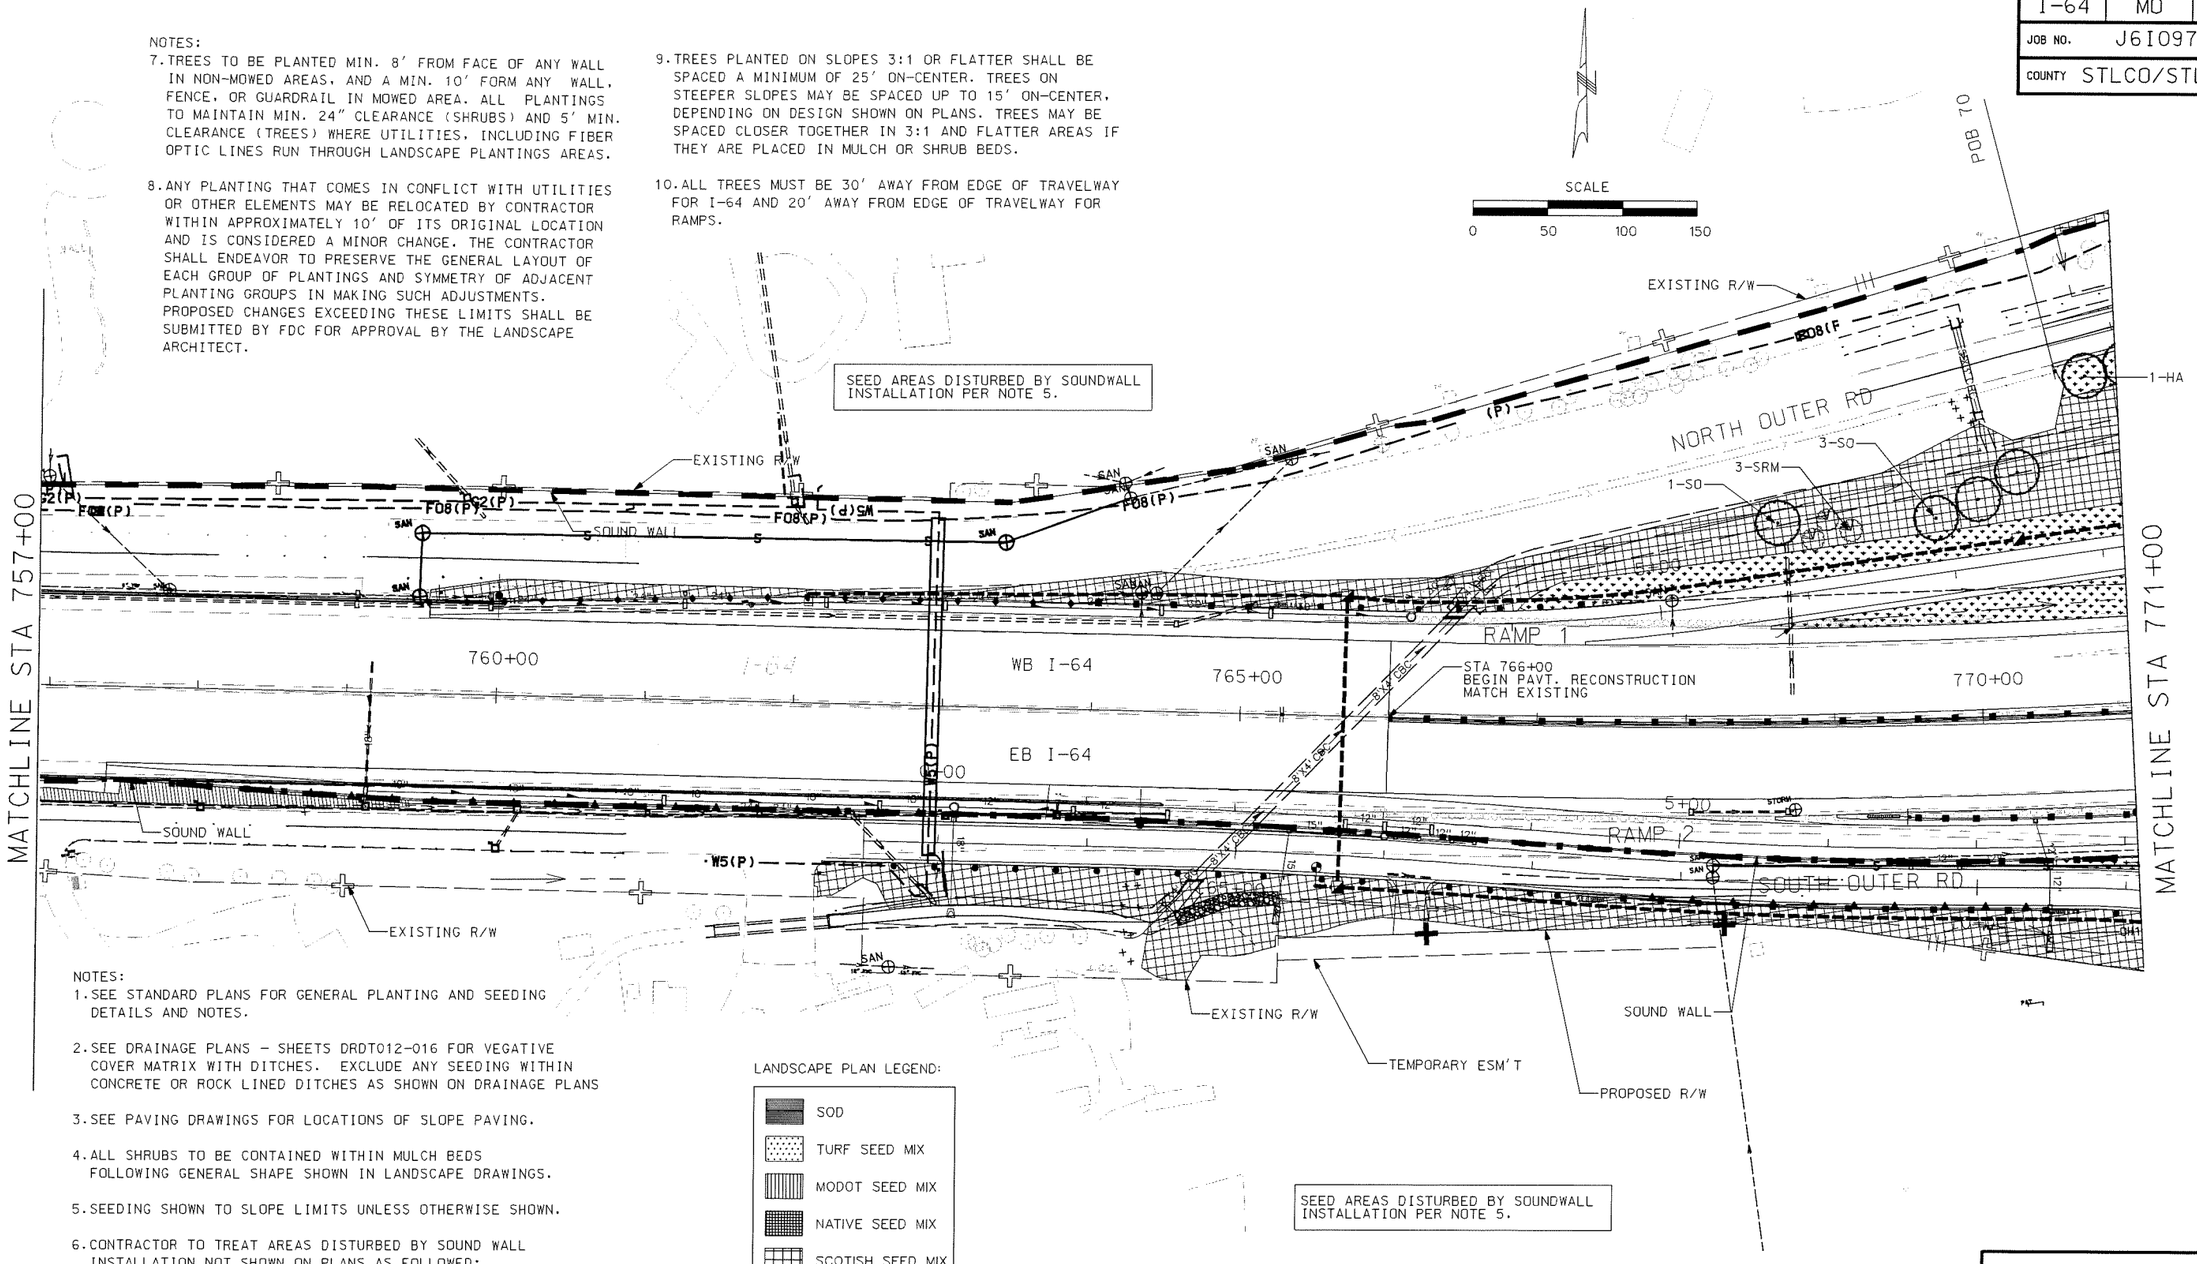

NOTES:

1. SEE STANDARD PLANS FOR GENERAL PLANTING AND SEEDING DETAILS AND NOTES.
2. SEE DRAINAGE PLANS - SHEETS DRDT012-016 FOR VEGATIVE COVER MATRIX WITH DITCHES. EXCLUDE ANY SEEDING WITHIN CONCRETE OR ROCK LINED DITCHES AS SHOWN ON DRAINAGE PLANS
3. SEE PAVING DRAWINGS FOR LOCATIONS OF SLOPE PAVING.
4. ALL SHRUBS TO BE CONTAINED WITHIN MULCH BEDS FOLLOWING GENERAL SHAPE SHOWN IN LANDSCAPE DRAWINGS.
5. SEEDING SHOWN TO SLOPE LIMITS UNLESS OTHERWISE SHOWN.
6. CONTRACTOR TO TREAT AREAS DISTURBED BY SOUND WALL INSTALLATION NOT SHOWN ON PLANS AS FOLLOWED:
   A. SCOTISH MIX - BACK OF WALL OR ON SLOPES GREATER THAN 3:1
   B. MODOT MIX - FACE OF WALL ON SLOPES LESS THAN 3:1
   C. PER DITCH DETAIL MATRIX WITHIN DITCHES.

LANDSCAPE PLAN LEGEND:

- SOD
- TURF SEED MIX
- MODOT SEED MIX
- NATIVE SEED MIX
- SCOTISH SEED MIX
- ROCK

MY RESPONSIBILITY COVERS ONLY THE INFORMATION IN THE CLOUDED AREAS. SEE ORIGINAL RFC SET FOR ORIGINAL STAMP AND SIGNATURE.

DESIGNED BY: DSJ	ISSUE RECORD		
	NO.	DESCRIPTION	DATE
DRAFTED BY: DSJ	B	70% PLAN REVIEW SUBMITTAL	17JULY07
	C	90% FINAL DESIGN	28SEPT07
	1	RELEASED FOR CONSTRUCTION	15NOV07
CHECKED BY: JRL	2	RFC FDC 497 ADDITIONAL TREE PLANTINGS	10OCT08
	AB	AS-BUILT FDC-415, FDC-497	09JUN10

PARSONS

Gateway Constructors
Granite • Fred Weber • Millstone Bangert

THE NEW I-64

THE NEW I-64 PROJECT
SEGMENT 1
LANDSCAPE PLAN
I-64
STA 757+00 TO STA 771+00

MoDOT

DRAWING NUMBER
LPPL004

AS-BUILT

File Name: C:\EXPORT\TEMP\004_LPPL_1100_S1.DGN
User: PARSONS
Time Plotted: 10:52:01 AM
Date Plotted: 7/16/2010
Pen Table: I-64_HALFSIZEBW-DATE.TBLPlot Driver: 11X17_PDF_A8.PLT

ROUTE	STATE	DISTRICT
I-64	MO	6
JOB NO.	J6I0978	
COUNTY	STLCO/STLCITY	

LANDSCAPE PLAN LEGEND:

- SOD
- TURF SEED MIX
- MODOT SEED MIX
- NATIVE SEED MIX
- SCOTISH SEED MIX
- ROCK

NOTES:

9. TREES PLANTED ON SLOPES 3:1 OR FLATTER SHALL BE SPACED A MINIMUM OF 25' ON-CENTER. TREES ON STEEPER SLOPES MAY BE SPACED UP TO 15' ON-CENTER, DEPENDING ON DESIGN SHOWN ON PLANS. TREES MAY BE SPACED CLOSER TOGETHER IN 3:1 AND FLATTER AREAS IF THEY ARE PLACED IN MULCH OR SHRUB BEDS.

10. ALL TREES MUST BE 30' AWAY FROM EDGE OF TRAVELWAY FOR I-64 AND 20' AWAY FROM EDGE OF TRAVELWAY FOR RAMPS.

NOTES:

1. SEE STANDARD PLANS FOR GENERAL PLANTING AND SEEDING DETAILS AND NOTES
2. SEE DRAINAGE PLANS - SHEETS DRDT012-016 FOR VEGETATIVE COVER MATRIX WITH DITCHES. EXCLUDE ANY SEEDING WITHIN CONCRETE OR ROCK LINED DITCHES AS SHOWN ON DRAINAGE PLANS.
3. SEE PAVING DRAWINGS FOR LOCATIONS OF SLOPE PAVING.
4. ALL SHRUBS TO BE CONTAINED WITHIN MULCH BEDS FOLLOWING GENERAL SHAPE SHOWN IN LANDSCAPE DRAWINGS.
5. SEEDING SHOWN TO SLOPE LIMITS UNLESS OTHERWISE SHOWN.
6. CONTRACTOR TO TREAT AREAS DISTURB BY SOUND WALL INSTALLATION NOT SHOWN ON PLANS AS FOLLOWED:
   A. SCOTISH MIX- BACK OF WALL OR ON SLOPES GREATER THAN 3:1
   B. MODOT MIX - FACE OF WALL ON SLOPES LESS THAN 3:1.
   C. PER DITCH DETAIL MATRIX WITHIN DITCHES.

NOTES:

7. TREES TO BE PLANTED MIN. 8' FROM FACE OF ANY WALL IN NON-MOWED AREAS, AND A MIN. 10' FORM ANY WALL, FENCE, OR GUARDRAIL IN MOWED AREA. ALL PLANTINGS TO MAINTAIN MIN. 24" CLEARANCE (SHRUBS) AND 5' MIN. CLEARANCE (TREES) WHERE UTILITIES, INCLUDING FIBER OPTIC LINES RUN THROUGH LANDSCAPE PLANTINGS AREAS.
8. ANY PLANTING THAT COMES IN CONFLICT WITH UTILITIES OR OTHER ELEMENTS MAY BE RELOCATED BY CONTRACTOR WITHIN APPROXIMATELY 10' OF ITS ORIGINAL LOCATION AND IS CONSIDERED A MINOR CHANGE. THE CONTRACTOR SHALL ENDEAVOR TO PRESERVE THE GENERAL LAYOUT OF EACH GROUP OF PLANTINGS AND SYMMETRY OF ADJACENT PLANTING GROUPS IN MAKING SUCH ADJUSTMENTS. PROPOSED CHANGES EXCEEDING THESE LIMITS SHALL BE SUBMITTED BY FDC FOR APPROVAL BY THE LANDSCAPE ARCHITECT.

MY RESPONSIBILITY COVERS ONLY THE INFORMATION IN THE CLOUDED AREAS. SEE ORIGINAL RFC SET FOR ORIGINAL STAMP AND SIGNATURE.

DESIGNED BY: DSJ	ISSUE RECORD		
	NO.	DESCRIPTION	DATE
DRAFTED BY: DSJ	B	70% PLAN REVIEW SUBMITTAL	17JULY07
	C	90% FINAL DESIGN	28SEPT07
	1	RELEASED FOR CONSTRUCTION	15NOV07
CHECKED BY: JRL	2	RFC FDC 497 ADDITIONAL TREE PLANTINGS	10OCT08
	AB	AS-BUILT FDC-497	09JUN10

PARSONS

Gateway Constructors
Granite • Fred Weber • Millstone Bangert

THE NEW I-64

THE NEW I-64 PROJECT

SEGMENT 1
LANDSCAPE PLAN
I-64
STA 771+00 TO STA 785+00

MoDOT

DRAWING NUMBER
LPPL005

AS-BUILT

File Name: C:\EXPORT\!TEMP\005_LPPL_I100_S1.DGN
User: PARSONS
Pen Table: I-64_HALFSIZEBW-DATE.TBL
Time Plotted: 2:44:00 PM
Date Plotted: 7/30/2010
Plot Driver: 11X17_PDF_AB.PLT

ROUTE	STATE	DISTRICT
I-64	MO	6
JOB NO.	J6I0978	
COUNTY	STLCO/STLCITY	

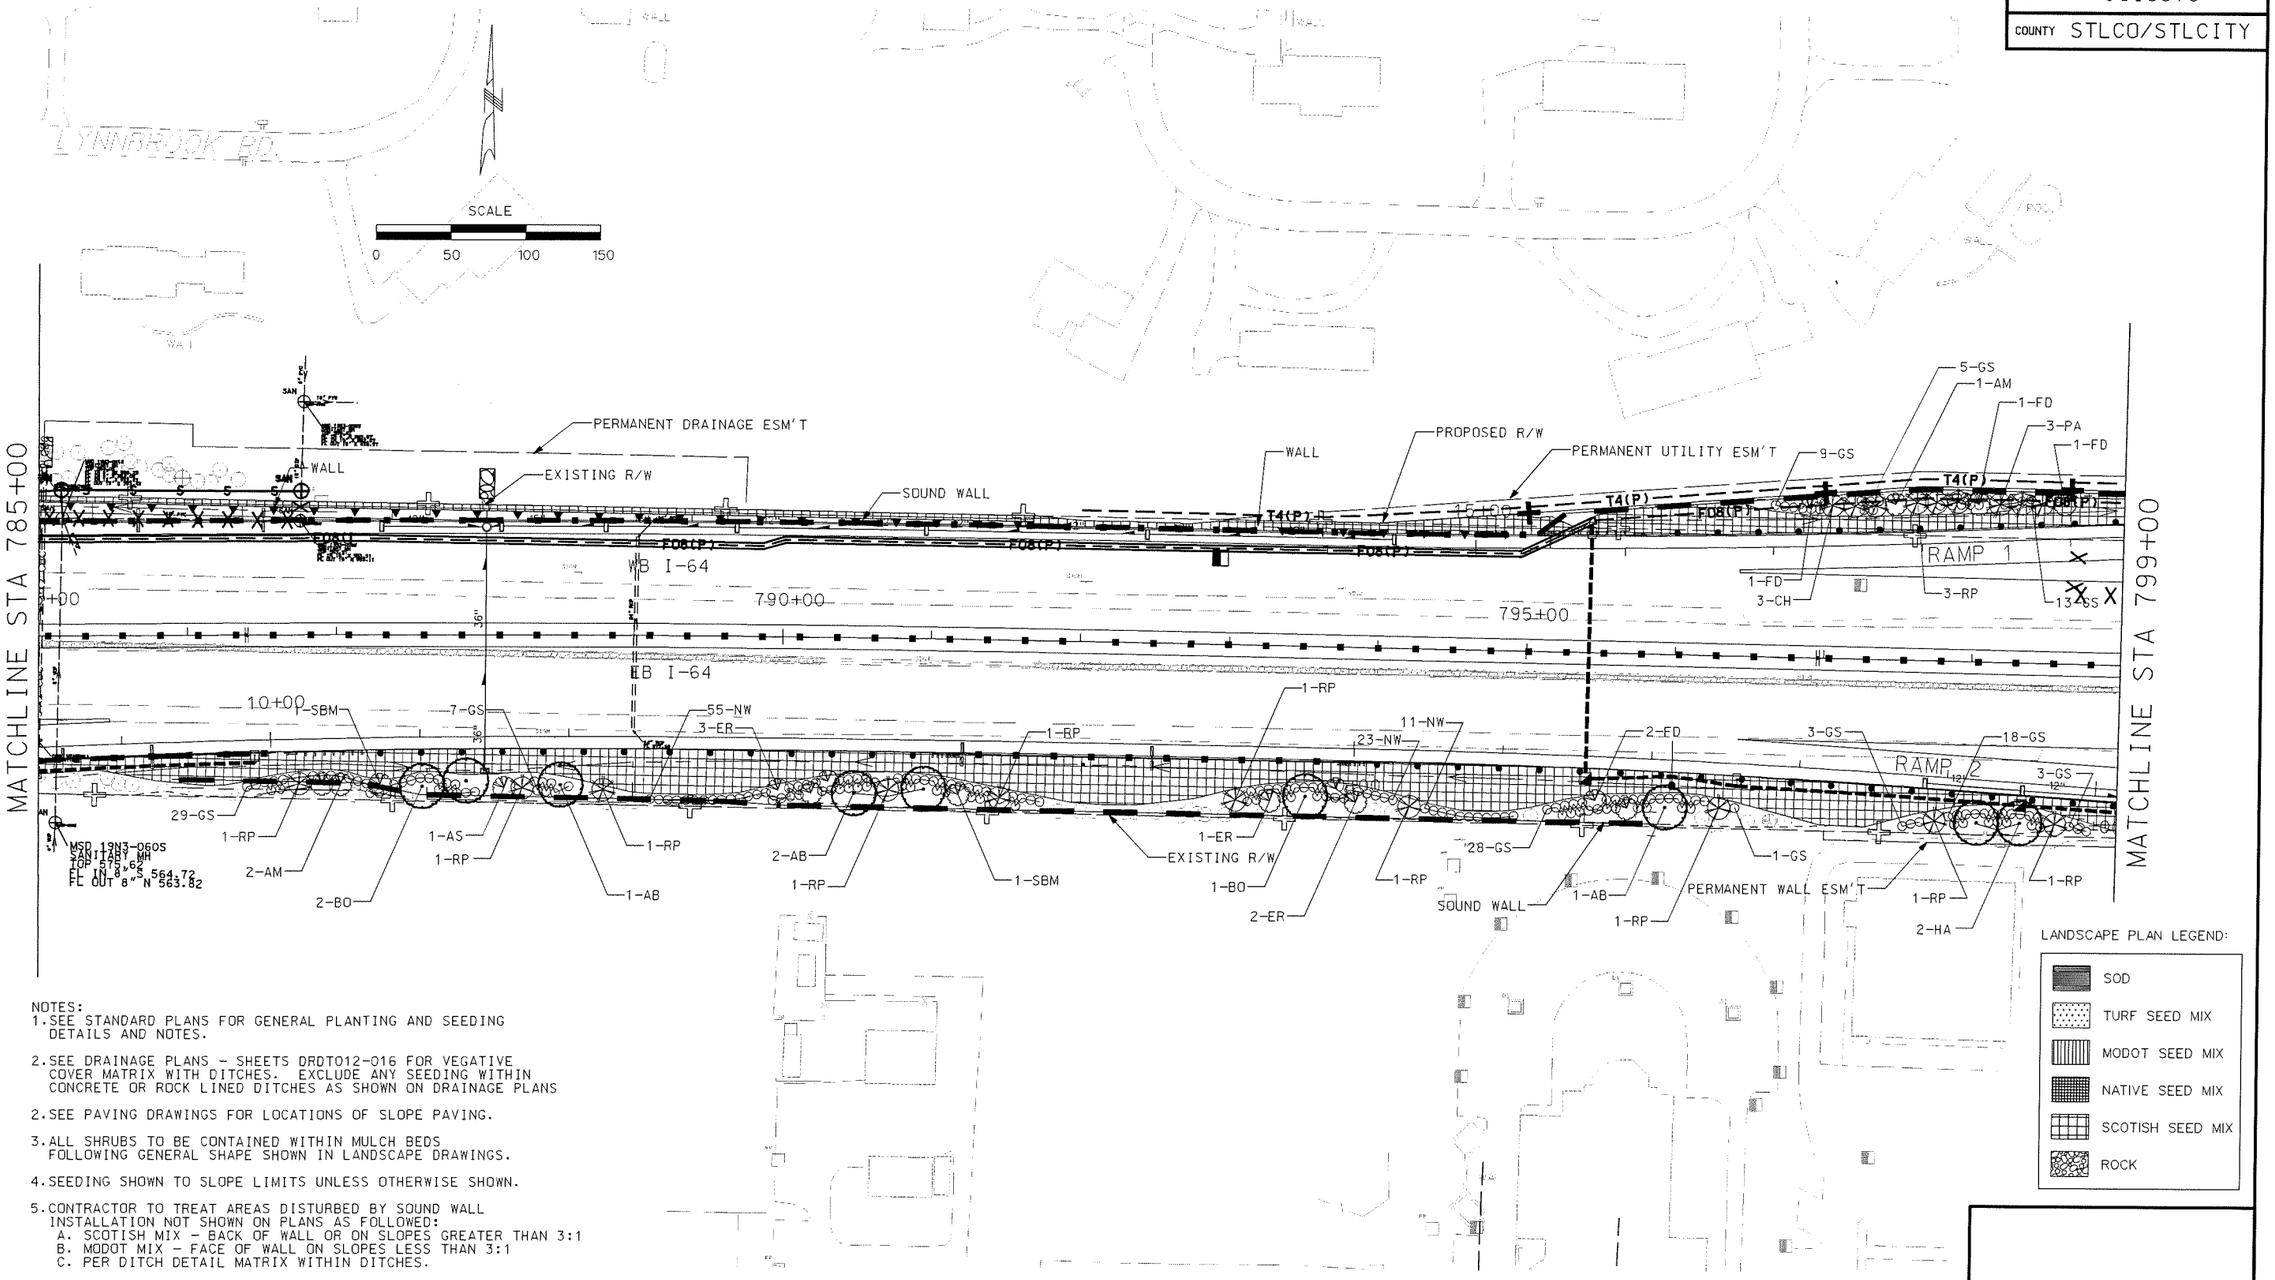

NOTES:
1. SEE STANDARD PLANS FOR GENERAL PLANTING AND SEEDING DETAILS AND NOTES.
2. SEE DRAINAGE PLANS - SHEETS DROTO12-016 FOR VEGATIVE COVER MATRIX WITH DITCHES. EXCLUDE ANY SEEDING WITHIN CONCRETE OR ROCK LINED DITCHES AS SHOWN ON DRAINAGE PLANS
2. SEE PAVING DRAWINGS FOR LOCATIONS OF SLOPE PAVING.
3. ALL SHRUBS TO BE CONTAINED WITHIN MULCH BEDS FOLLOWING GENERAL SHAPE SHOWN IN LANDSCAPE DRAWINGS.
4. SEEDING SHOWN TO SLOPE LIMITS UNLESS OTHERWISE SHOWN.
5. CONTRACTOR TO TREAT AREAS DISTURBED BY SOUND WALL INSTALLATION NOT SHOWN ON PLANS AS FOLLOWED:
   A. SCOTISH MIX - BACK OF WALL OR ON SLOPES GREATER THAN 3:1
   B. MODOT MIX - FACE OF WALL ON SLOPES LESS THAN 3:1
   C. PER DITCH DETAIL MATRIX WITHIN DITCHES.

LANDSCAPE PLAN LEGEND:
- SOD
- TURF SEED MIX
- MODOT SEED MIX
- NATIVE SEED MIX
- SCOTISH SEED MIX
- ROCK

DESIGNED BY:	ISSUE RECORD		
	NO.	DESCRIPTION	DATE
DRAFTED BY:	A	50% PLAN REVIEW SUBMITTAL	04MAY07
	B	70% PLAN REVIEW SUBMITTAL	17JULY07
	C	90% FINAL DESIGN	28SEPT07
CHECKED BY:	1	RELEASED FOR CONSTRUCTION	15NOV07
	AB	AS-BUILT	09JUN10

PARSONS

Gateway Constructors
Granite • Fred Weber • Millstone Bangert

THE NEW I-64

THE NEW I-64 PROJECT
SEGMENT 1
LANDSCAPE PLAN
I-64
STA 785+00 TO STA 799+00

MoDOT

DRAWING NUMBER
LPPL006

AS-BUILT

File Name: C:\EXPORT\ITEMP\006_LPPL_I100_S1.DGN
User: PARSONS
Time Plotted: 10:52:27 AM
Date Plotted: 7/16/2010
Pen Table: I-64_HALFSIZEBW-DATE.TBL
Plot Driver: 11X17_PDF_AB.PLT

ROUTE	STATE	DISTRICT
I-64	MO	6
JOB NO.	J6I0978	
COUNTY	STLCO/STLCITY	

NOTES:
1. SEE STANDARD PLANS FOR GENERAL PLANTING AND SEEDING DETAILS AND NOTES.
2. SEE DRAINAGE PLANS – SHEETS DRDT012–016 FOR VEGATIVE COVER MATRIX WITH DITCHES. EXCLUDE ANY SEEDING WITHIN CONCRETE OR ROCK LINED DITCHES AS SHOWN ON DRAINAGE PLANS
3. SEE PAVING DRAWINGS FOR LOCATIONS OF SLOPE PAVING.
4. ALL SHRUBS TO BE CONTAINED WITHIN MULCH BEDS FOLLOWING GENERAL SHAPE SHOWN IN LANDSCAPE DRAWINGS.
5. SEEDING SHOWN TO SLOPE LIMITS UNLESS OTHERWISE SHOWN.
6. CONTRACTOR TO TREAT AREAS DISTURBED BY SOUND WALL INSTALLATION NOT SHOWN ON PLANS AS FOLLOWED:
   A. SCOTISH MIX – BACK OF WALL OR ON SLOPES GREATER THAN 3:1
   B. MODOT MIX – FACE OF WALL ON SLOPES LESS THAN 3:1
   C. PER DITCH DETAIL MATRIX WITHIN DITCHES.

SCALE
0 50 100 150

LANDSCAPE PLAN LEGEND:
- SOD
- TURF SEED MIX
- MODOT SEED MIX
- NATIVE SEED MIX
- SCOTISH SEED MIX
- ROCK

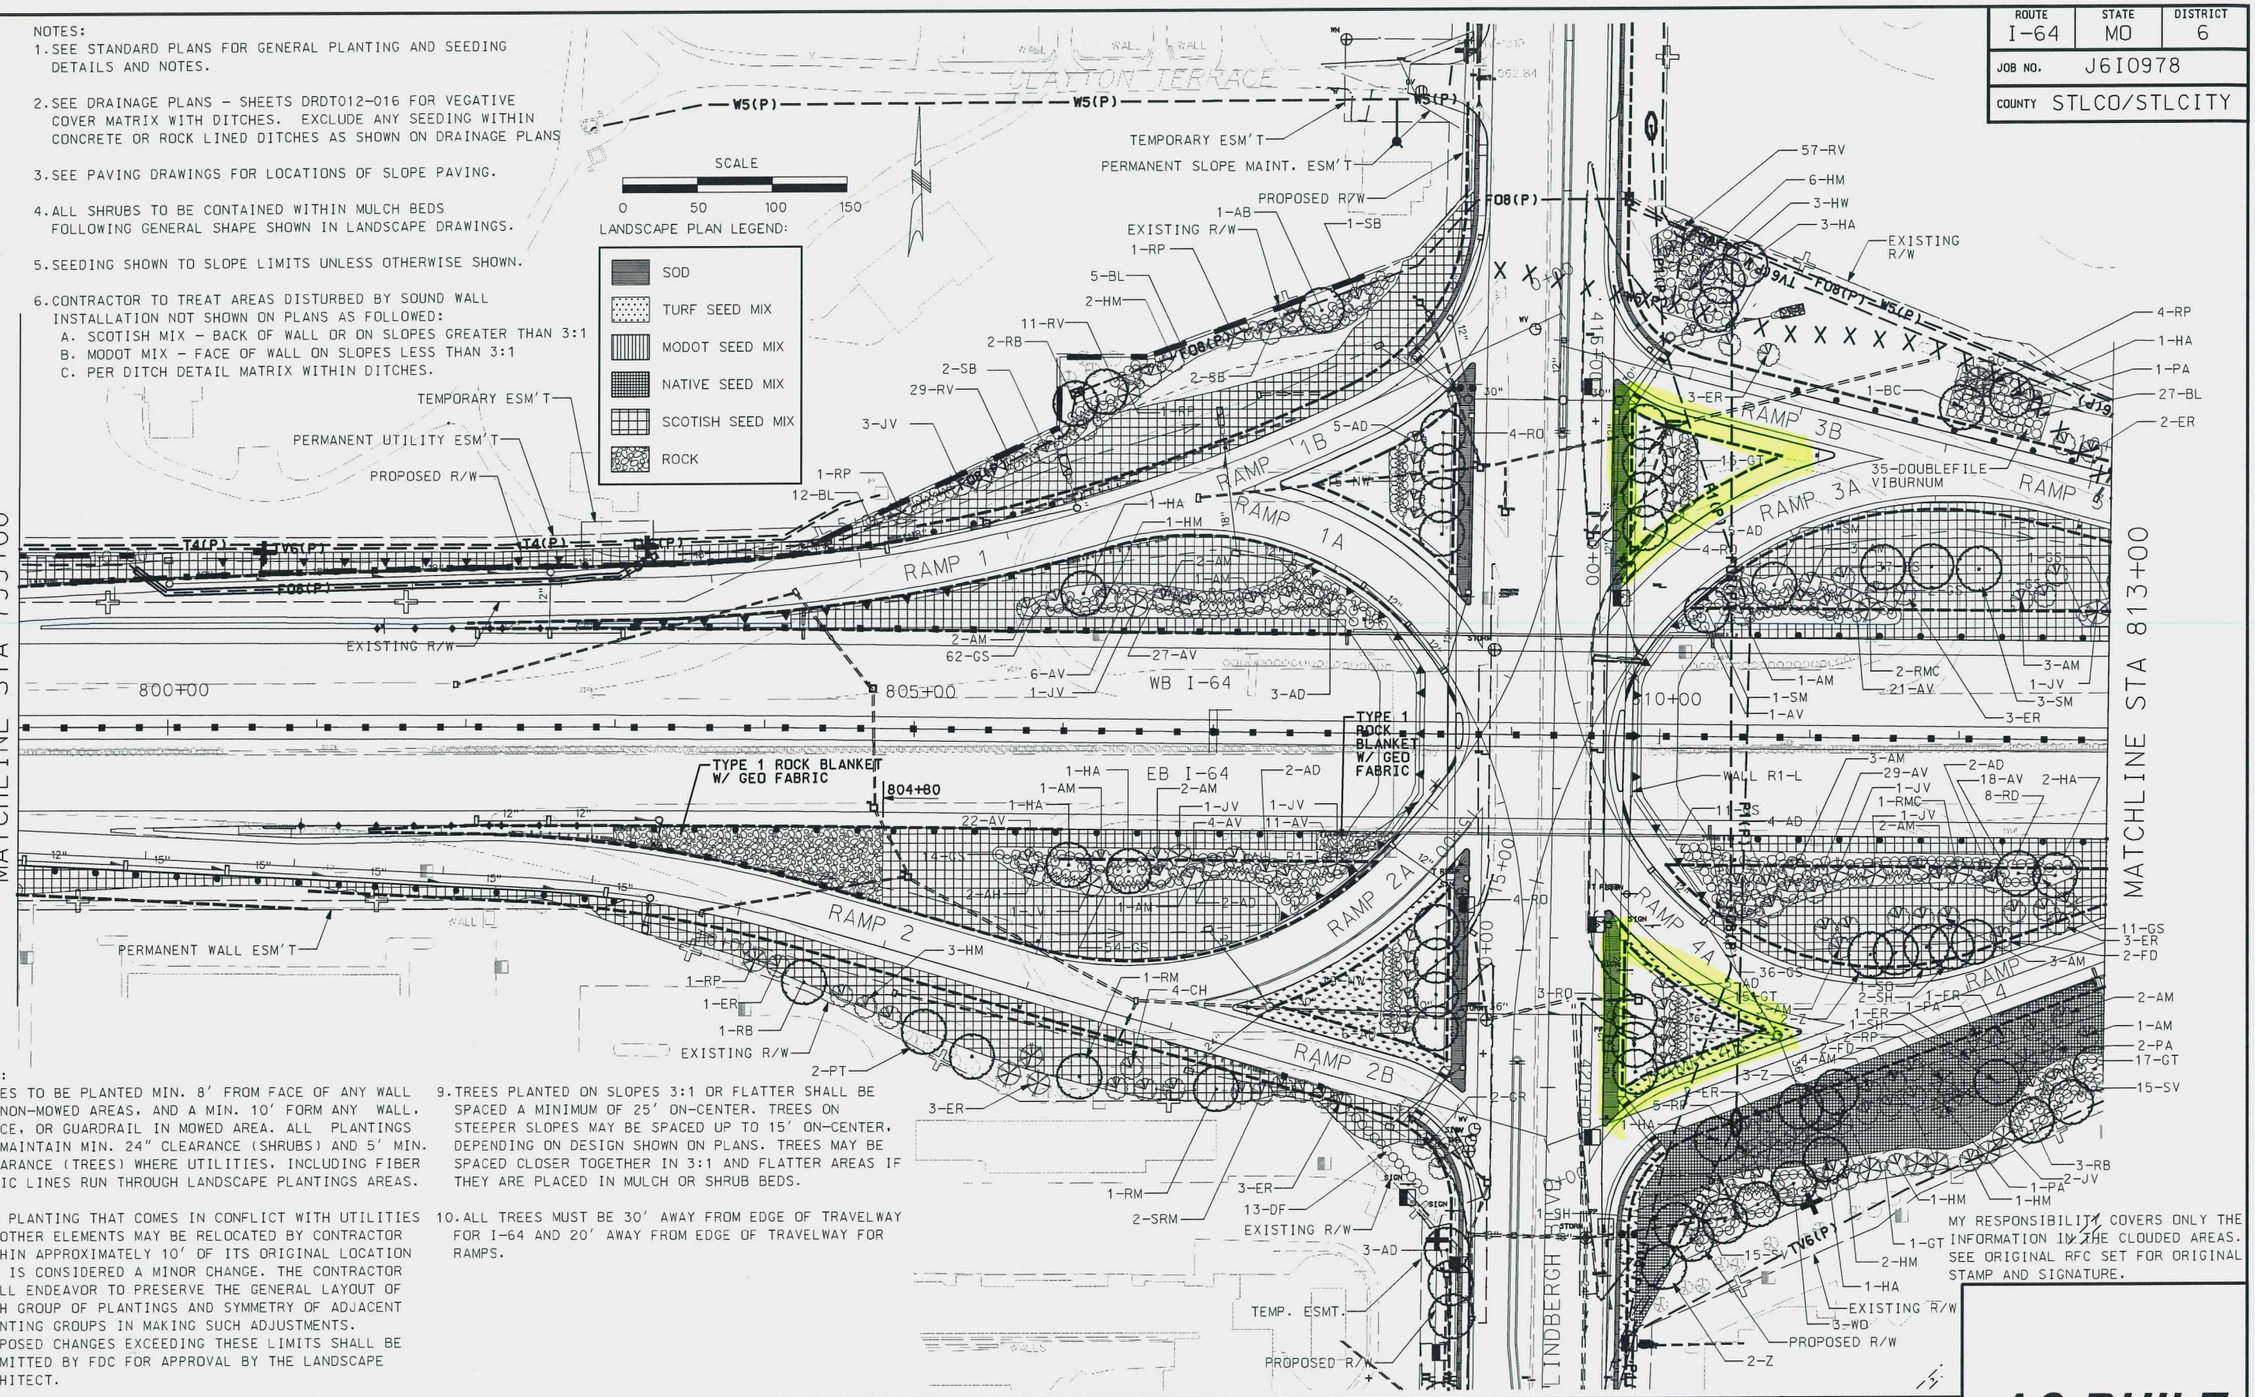

NOTES:
7. TREES TO BE PLANTED MIN. 8' FROM FACE OF ANY WALL IN NON-MOWED AREAS, AND A MIN. 10' FORM ANY WALL, FENCE, OR GUARDRAIL IN MOWED AREA. ALL PLANTINGS TO MAINTAIN MIN. 24" CLEARANCE (SHRUBS) AND 5' MIN. CLEARANCE (TREES) WHERE UTILITIES, INCLUDING FIBER OPTIC LINES RUN THROUGH LANDSCAPE PLANTINGS AREAS.
8. ANY PLANTING THAT COMES IN CONFLICT WITH UTILITIES OR OTHER ELEMENTS MAY BE RELOCATED BY CONTRACTOR WITHIN APPROXIMATELY 10' OF ITS ORIGINAL LOCATION AND IS CONSIDERED A MINOR CHANGE. THE CONTRACTOR SHALL ENDEAVOR TO PRESERVE THE GENERAL LAYOUT OF EACH GROUP OF PLANTINGS AND SYMMETRY OF ADJACENT PLANTING GROUPS IN MAKING SUCH ADJUSTMENTS. PROPOSED CHANGES EXCEEDING THESE LIMITS SHALL BE SUBMITTED BY FDC FOR APPROVAL BY THE LANDSCAPE ARCHITECT.
9. TREES PLANTED ON SLOPES 3:1 OR FLATTER SHALL BE SPACED A MINIMUM OF 25' ON-CENTER. TREES ON STEEPER SLOPES MAY BE SPACED UP TO 15' ON-CENTER, DEPENDING ON DESIGN SHOWN ON PLANS. TREES MAY BE SPACED CLOSER TOGETHER IN 3:1 AND FLATTER AREAS IF THEY ARE PLACED IN MULCH OR SHRUB BEDS.
10. ALL TREES MUST BE 30' AWAY FROM EDGE OF TRAVELWAY FOR I-64 AND 20' AWAY FROM EDGE OF TRAVELWAY FOR RAMPS.

MY RESPONSIBILITY COVERS ONLY THE INFORMATION IN THE CLOUDED AREAS. SEE ORIGINAL RFC SET FOR ORIGINAL STAMP AND SIGNATURE.

DESIGNED BY: DSJ	ISSUE RECORD		
DRAFTED BY: DSJ	NO.	DESCRIPTION	DATE
CHECKED BY: JRL	B	70% PLAN REVIEW SUBMITTAL	17JULY07
	C	90% FINAL DESIGN	28SEPT07
	1	RELEASED FOR CONSTRUCTION	15NOV07
	2	RFC FDC 497 ADDITIONAL TREE PLANTINGS	10OCT08
	AB	AS-BUILT FDC-497, FDC-733	09JUN10

PARSONS

Gateway Constructors
Granite • Fred Weber • Millstone Bangert

THE NEW I-64

THE NEW I-64 PROJECT
SEGMENT 1
LANDSCAPE PLAN
I-64
STA 799+00 TO STA 813+00

MoDOT

DRAWING NUMBER
LPPL007

AS-BUILT

File Name: C:\EXPORT\TEMP\007_LPPL_I100_S1.DGN
User: PARSONS
Pen Table: I-64_HALFSIZEBW-DATE.TBL
Date Plotted: 7/30/2010
Time Plotted: 2:44:17 PM
Plot Driver: 11X17_PDF_AB.PLT

ROUTE	STATE	DISTRICT
I-64	MO	6
JOB NO.	J6I0978	
COUNTY	STLCO/STLCITY	

NOTES:
1. SEE STANDARD PLANS FOR GENERAL PLANTING AND SEEDING DETAILS AND NOTES.
2. SEE DRAINAGE PLANS - SHEETS DRDT012-016 FOR VEGATIVE COVER MATRIX WITH DITCHES. EXCLUDE ANY SEEDING WITHIN CONCRETE OR ROCK LINED DITCHES AS SHOWN ON DRAINAGE PLANS
3. SEE PAVING DRAWINGS FOR LOCATIONS OF SLOPE PAVING.
4. ALL SHRUBS TO BE CONTAINED WITHIN MULCH BEDS FOLLOWING GENERAL SHAPE SHOWN IN LANDSCAPE DRAWINGS.
5. SEEDING SHOWN TO SLOPE LIMITS UNLESS OTHERWISE SHOWN.
6. CONTRACTOR TO TREAT AREAS DISTURBED BY SOUND WALL INSTALLATION NOT SHOWN ON PLANS AS FOLLOWED:
   A. SCOTISH MIX - BACK OF WALL OR ON SLOPES GREATER THAN 3:1
   B. MODOT MIX - FACE OF WALL ON SLOPES LESS THAN 3:1
   C. PER DITCH DETAIL MATRIX WITHIN DITCHES.

NOTES:
7. TREES TO BE PLANTED MIN. 8' FROM FACE OF ANY WALL IN NON-MOWED AREAS. AND A MIN. 10' FORM ANY WALL, FENCE, OR GUARDRAIL IN MOWED AREA. ALL PLANTINGS TO MAINTAIN MIN. 24" CLEARANCE (SHRUBS) AND 5' MIN. CLEARANCE (TREES) WHERE UTILITIES, INCLUDING FIBER OPTIC LINES RUN THROUGH LANDSCAPE PLANTINGS AREAS.
8. ANY PLANTING THAT COMES IN CONFLICT WITH UTILITIES OR OTHER ELEMENTS MAY BE RELOCATED BY CONTRACTOR WITHIN APPROXIMATELY 10' OF ITS ORIGINAL LOCATION AND IS CONSIDERED A MINOR CHANGE. THE CONTRACTOR SHALL ENDEAVOR TO PRESERVE THE GENERAL LAYOUT OF EACH GROUP OF PLANTINGS AND SYMMETRY OF ADJACENT PLANTING GROUPS IN MAKING SUCH ADJUSTMENTS. PROPOSED CHANGES EXCEEDING THESE LIMITS SHALL BE SUBMITTED BY FDC FOR APPROVAL BY THE LANDSCAPE ARCHITECT.
9. TREES PLANTED ON SLOPES 3:1 OR FLATTER SHALL BE SPACED A MINIMUM OF 25' ON-CENTER. TREES ON STEEPER SLOPES MAY BE SPACED UP TO 15' ON-CENTER, DEPENDING ON DESIGN SHOWN ON PLANS. TREES MAY BE SPACED CLOSER TOGETHER IN 3:1 AND FLATTER AREAS IF THEY ARE PLACED IN MULCH OR SHRUB BEDS.
10. ALL TREES MUST BE 30' AWAY FROM EDGE OF TRAVELWAY FOR I-64 AND 20' AWAY FROM EDGE OF TRAVELWAY FOR RAMPS.

ARWOC

RWOOD

SCALE
0 50 100 150

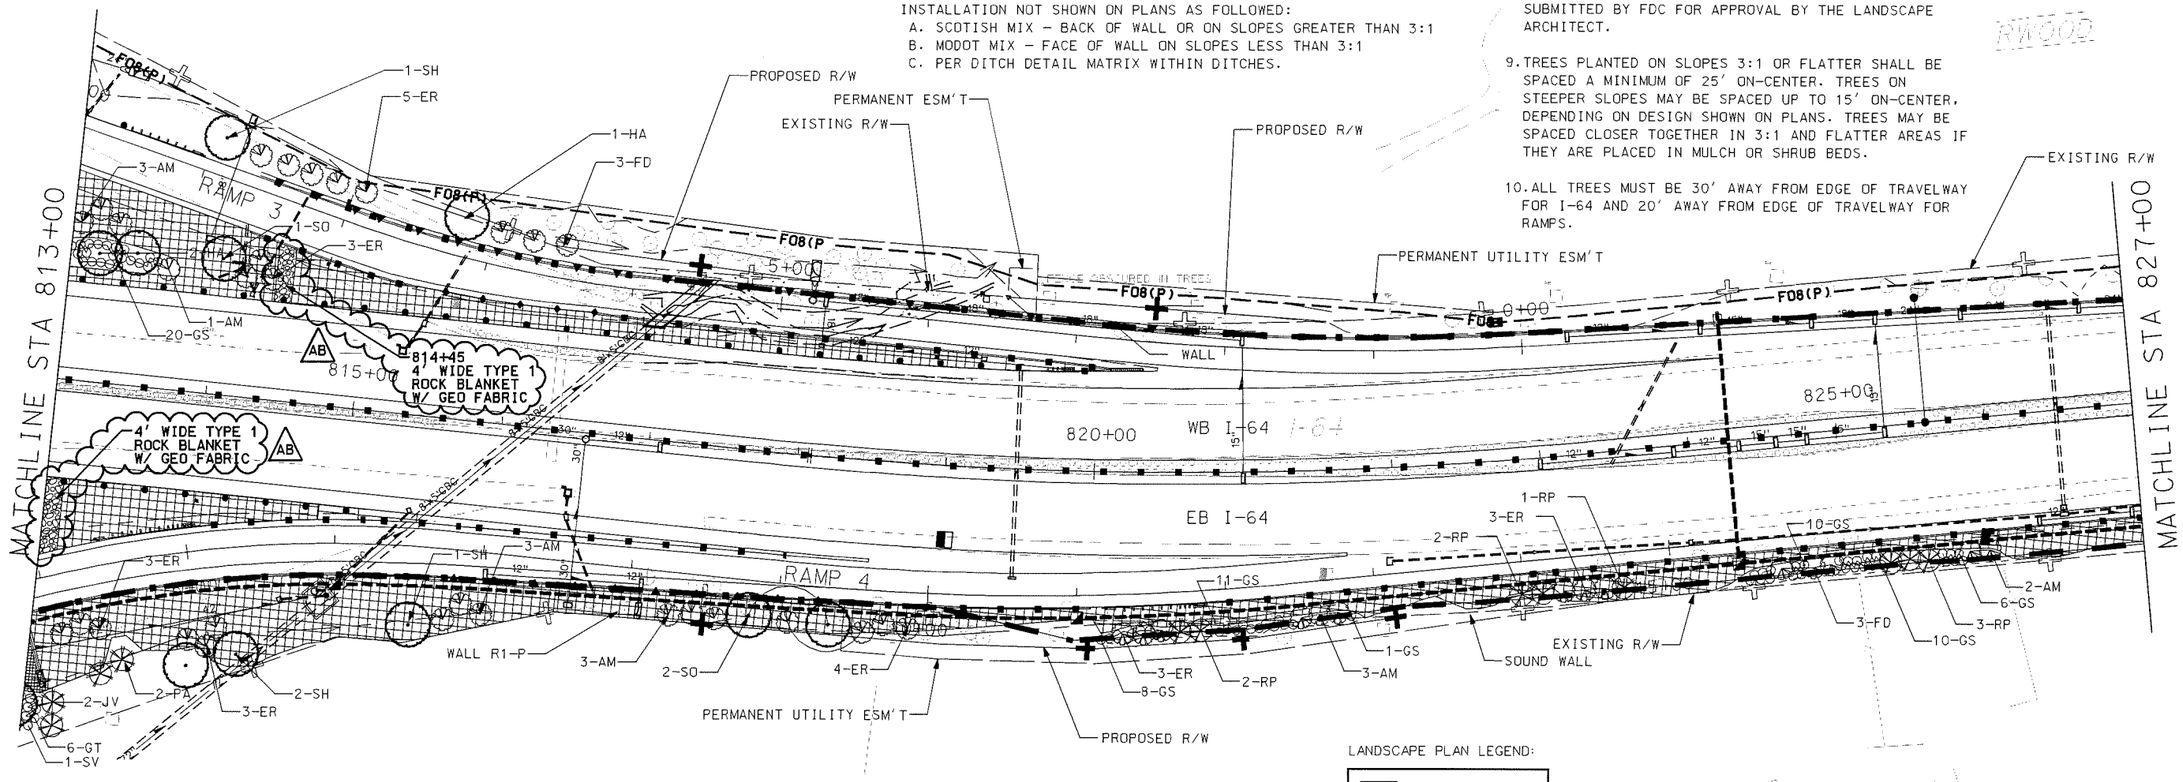

LANDSCAPE PLAN LEGEND:

- SOD
- TURF SEED MIX
- MODOT SEED MIX
- NATIVE SEED MIX
- SCOTISH SEED MIX
- ROCK

MY RESPONSIBILITY COVERS ONLY THE INFORMATION IN THE CLOUDED AREAS. SEE ORIGINAL RFC SET FOR ORIGINAL STAMP AND SIGNATURE.

DESIGNED BY: DSJ	ISSUE RECORD		
	NO.	DESCRIPTION	DATE
DRAFTED BY: DSJ	B	70% PLAN REVIEW SUBMITTAL	17JULY07
	C	90% FINAL DESIGN	28SEPT07
	1	RELEASED FOR CONSTRUCTION	15NOV07
CHECKED BY: JRL	2	RFC FDC 497 ADDITIONAL TREE PLANTINGS	10OCT08
	AB	AS-BUILT FDC-497, FDC-733	09JUN10

PARSONS

Gateway Constructors
Granite • Fred Weber • Millstone Bangert

THE NEW I-64

THE NEW I-64 PROJECT
SEGMENT 1
LANDSCAPE PLAN
I-64
STA 813+00 TO STA 827+00

MoDOT

DRAWING NUMBER
LPPL008

AS-BUILT

File Name: C:\EXPORT\TEMP\008_LPPL_I100_S1.DGN
User: PARSONS
Time Plotted: 10:52:54 AM
Date Plotted: 7/16/2010
Pen Table: I-64_HALFSIZEBW-DATE.TBL
Plot Driver: 11X17_PDF_AB.PLT

ROUTE	STATE	DISTRICT
I-64	MO	6
JOB NO.	J6I0978	
COUNTY	STLCO/STLCITY	

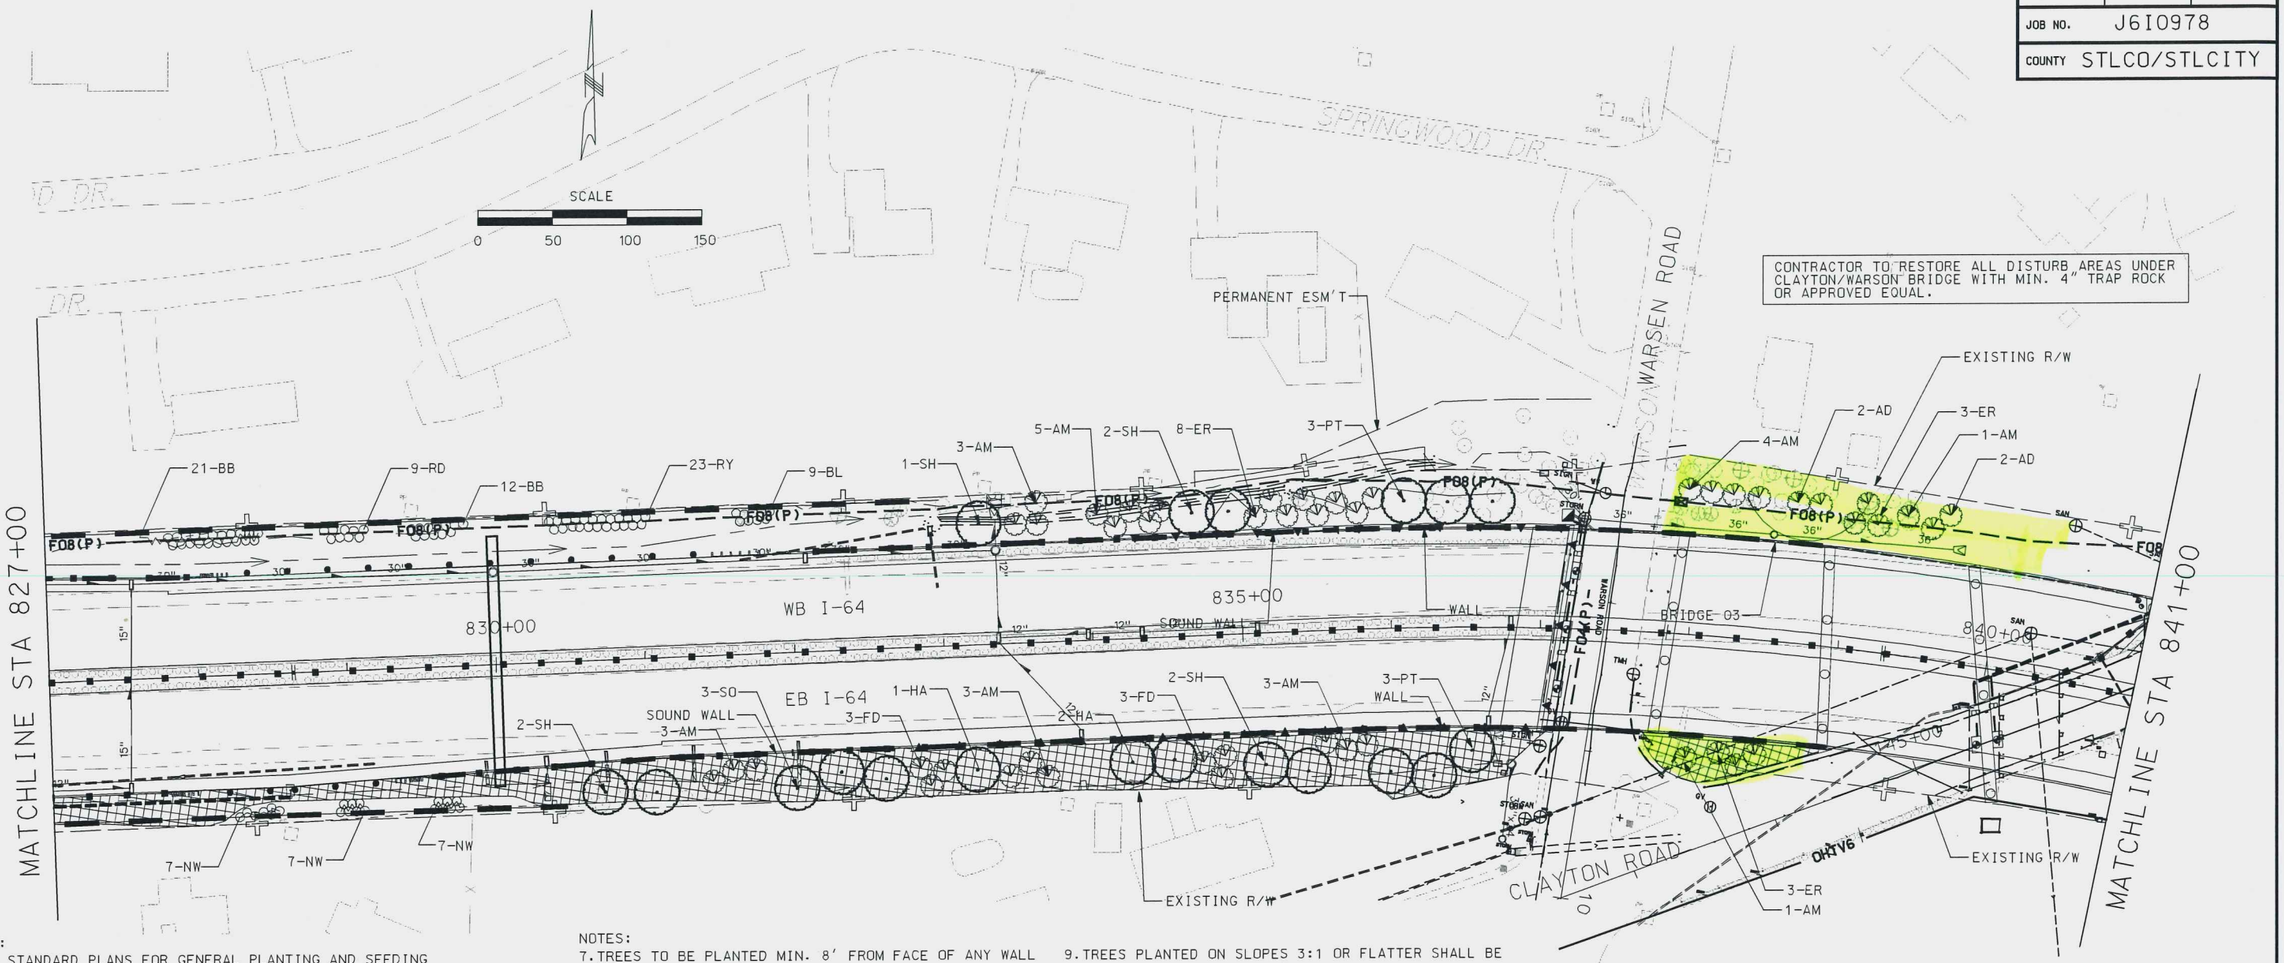

NOTES:

1. SEE STANDARD PLANS FOR GENERAL PLANTING AND SEEDING DETAILS AND NOTES.
2. SEE DRAINAGE PLANS - SHEETS DRDT012-016 FOR VEGATIVE COVER MATRIX WITH DITCHES. EXCLUDE ANY SEEDING WITHIN CONCRETE OR ROCK LINED DITCHES AS SHOWN ON DRAINAGE PLANS
3. SEE PAVING DRAWINGS FOR LOCATIONS OF SLOPE PAVING.
4. ALL SHRUBS TO BE CONTAINED WITHIN MULCH BEDS FOLLOWING GENERAL SHAPE SHOWN IN LANDSCAPE DRAWINGS.
5. SEEDING SHOWN TO SLOPE LIMITS UNLESS OTHERWISE SHOWN.
6. CONTRACTOR TO TREAT AREAS DISTURBED BY SOUND WALL INSTALLATION NOT SHOWN ON PLANS AS FOLLOWED:
   A. SCOTISH MIX - BACK OF WALL OR ON SLOPES GREATER THAN 3:1
   B. MODOT MIX - FACE OF WALL ON SLOPES LESS THAN 3:1
   C. PER DITCH DETAIL MATRIX WITHIN DITCHES.

NOTES:

7. TREES TO BE PLANTED MIN. 8' FROM FACE OF ANY WALL IN NON-MOWED AREAS, AND A MIN. 10' FORM ANY WALL, FENCE, OR GUARDRAIL IN MOWED AREA. ALL PLANTINGS TO MAINTAIN MIN. 24" CLEARANCE (SHRUBS) AND 5' MIN. CLEARANCE (TREES) WHERE UTILITIES, INCLUDING FIBER OPTIC LINES RUN THROUGH LANDSCAPE PLANTINGS AREAS.
8. ANY PLANTING THAT COMES IN CONFLICT WITH UTILITIES OR OTHER ELEMENTS MAY BE RELOCATED BY CONTRACTOR WITHIN APPROXIMATELY 10' OF ITS ORIGINAL LOCATION AND IS CONSIDERED A MINOR CHANGE. THE CONTRACTOR SHALL ENDEAVOR TO PRESERVE THE GENERAL LAYOUT OF EACH GROUP OF PLANTINGS AND SYMMETRY OF ADJACENT PLANTING GROUPS IN MAKING SUCH ADJUSTMENTS. PROPOSED CHANGES EXCEEDING THESE LIMITS SHALL BE SUBMITTED BY FDC FOR APPROVAL BY THE LANDSCAPE ARCHITECT.
9. TREES PLANTED ON SLOPES 3:1 OR FLATTER SHALL BE SPACED A MINIMUM OF 25' ON-CENTER. TREES ON STEEPER SLOPES MAY BE SPACED UP TO 15' ON-CENTER. DEPENDING ON DESIGN SHOWN ON PLANS. TREES MAY BE SPACED CLOSER TOGETHER IN 3:1 AND FLATTER AREAS IF THEY ARE PLACED IN MULCH OR SHRUB BEDS.
10. ALL TREES MUST BE 30' AWAY FROM EDGE OF TRAVELWAY FOR I-64 AND 20' AWAY FROM EDGE OF TRAVELWAY FOR RAMPS.

LANDSCAPE PLAN LEGEND:

- SOD
- TURF SEED MIX
- MODOT SEED MIX
- NATIVE SEED MIX
- SCOTISH SEED MIX
- ROCK

MY RESPONSIBILITY COVERS ONLY THE INFORMATION IN THE CLOUDED AREAS. SEE ORIGINAL RFC SET FOR ORIGINAL STAMP AND SIGNATURE.

DESIGNED BY: DSJ	ISSUE RECORD		
	NO.	DESCRIPTION	DATE
DRAFTED BY: DSJ	B	70% PLAN REVIEW SUBMITTAL	17JULY07
	C	90% FINAL DESIGN	28SEPT07
	1	RELEASED FOR CONSTRUCTION	15NOV07
CHECKED BY: JRL	2	RFC FDC 497 ADDITIONAL TREE PLANTINGS	10OCT08
	AB	AS-BUILT FDC-497	09JUN10

PARSONS

Gateway Constructors
Granite • Fred Weber • Millstone Bangert

THE NEW I-64 PROJECT
SEGMENT 1
LANDSCAPE PLAN
I-64
STA 827+00 TO STA 841+00

MoDOT

DRAWING NUMBER
LPPL009

AS-BUILT

File Name: C:\EXPORT\TEMP\009_LPPL_1100_S1.DGN
User: PARSONS
Time Plotted: 10:53:03 AM
Date Plotted: 7/16/2010
Pen Table: I-64_HALFSIZEBW-DATE.TBL Plot Driver: 11X17_PDF_AB.PLT

ROUTE	STATE	DISTRICT
I-64	MO	6
JOB NO.	J6I0978	
COUNTY	STLCO/STLCITY	

CONTRACTOR TO RESTORE ALL DISTURB AREAS UNDER CLAYTON/WARSON BRIDGE WITH MIN. 4" TRAP ROCK OR APPROVED EQUAL.

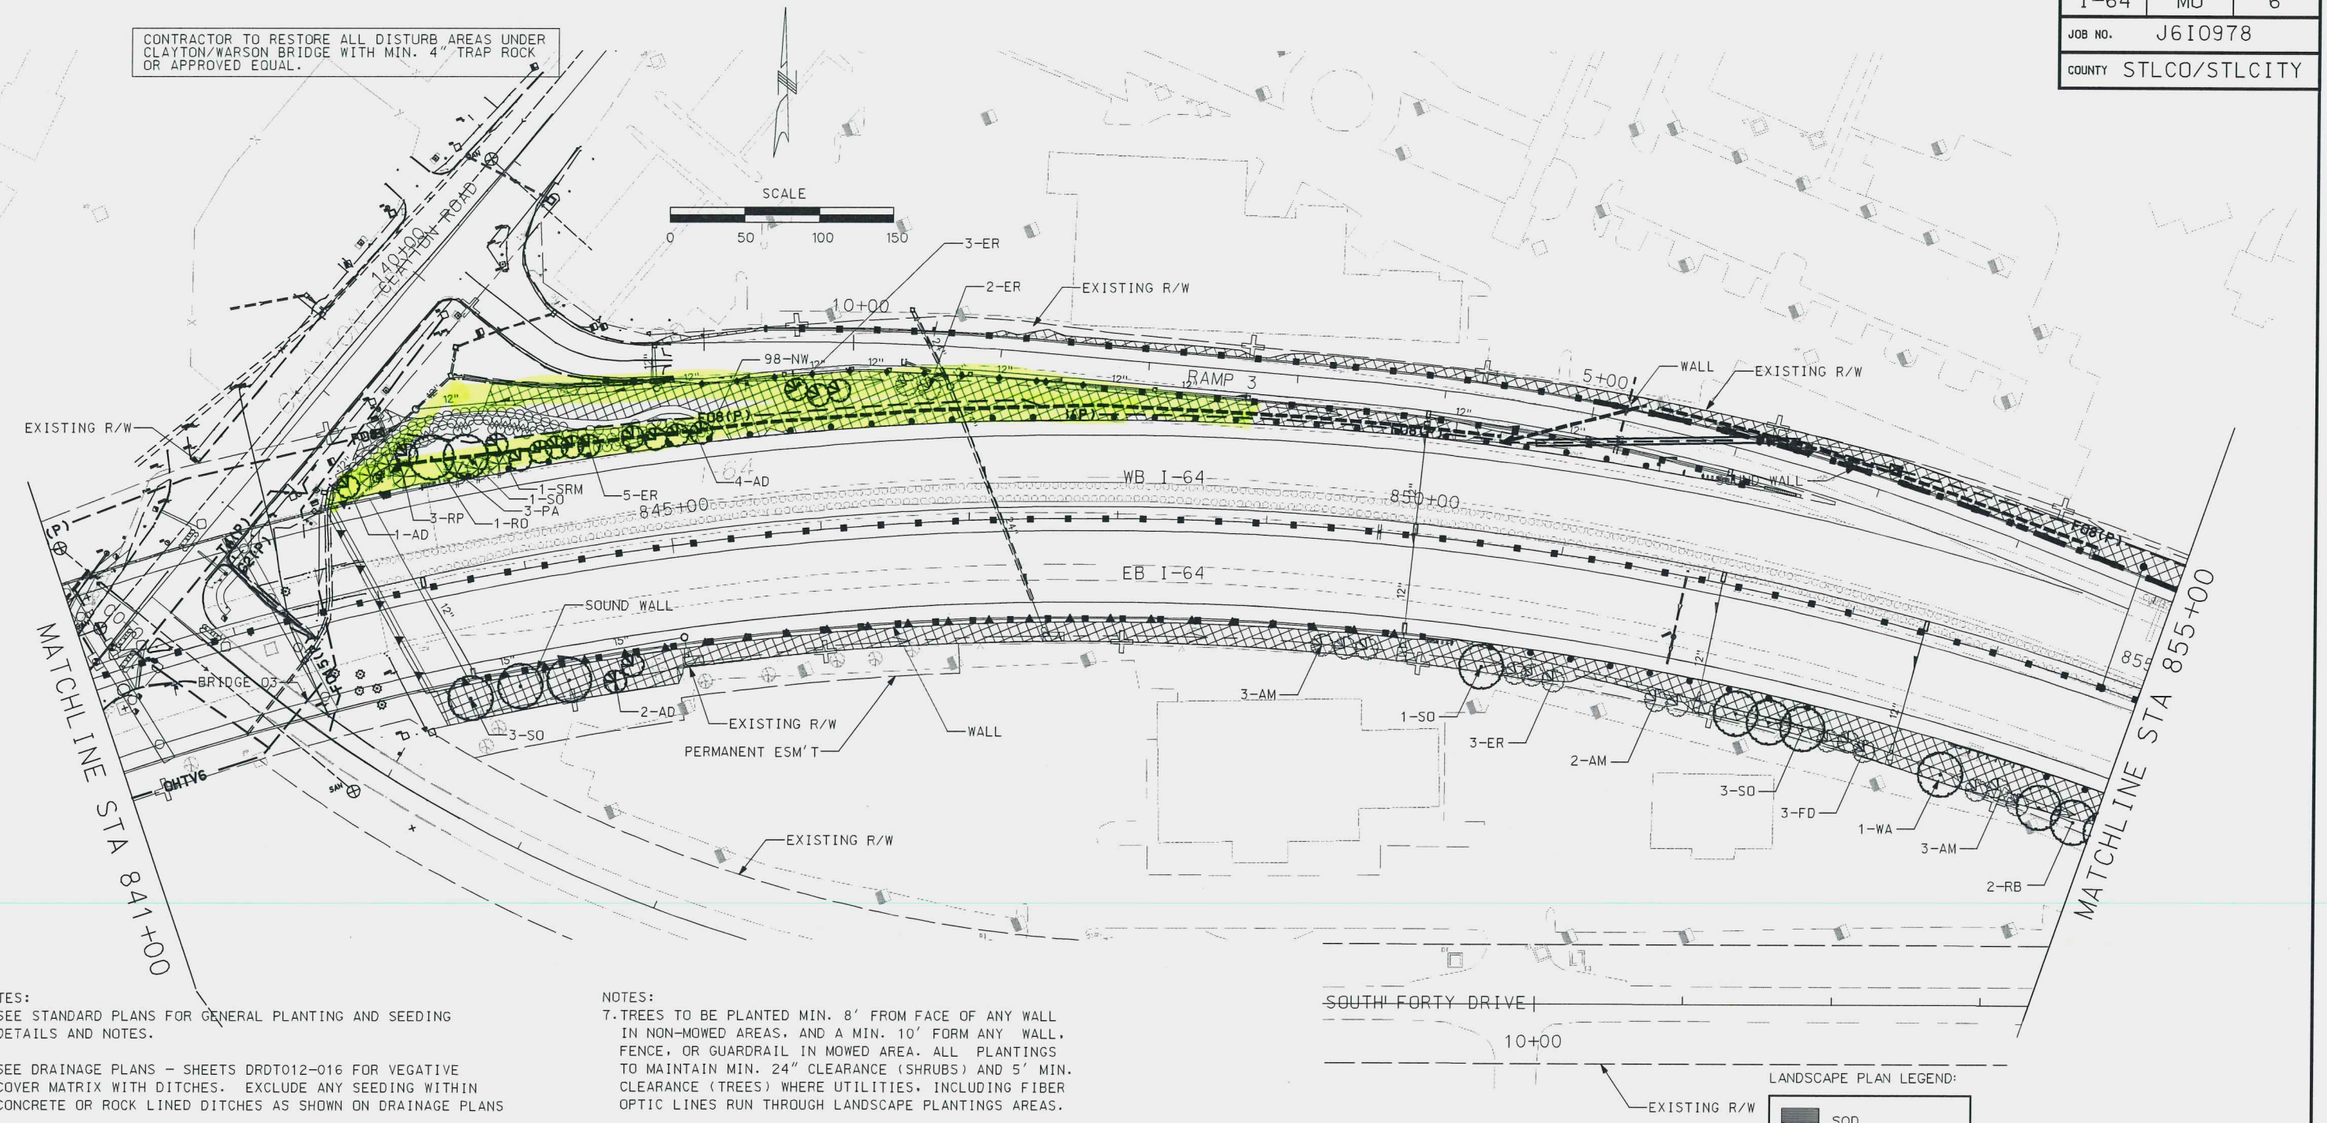

NOTES:
1. SEE STANDARD PLANS FOR GENERAL PLANTING AND SEEDING DETAILS AND NOTES.
2. SEE DRAINAGE PLANS – SHEETS DRDT012-016 FOR VEGATIVE COVER MATRIX WITH DITCHES. EXCLUDE ANY SEEDING WITHIN CONCRETE OR ROCK LINED DITCHES AS SHOWN ON DRAINAGE PLANS
3. SEE PAVING DRAWINGS FOR LOCATIONS OF SLOPE PAVING.
4. ALL SHRUBS TO BE CONTAINED WITHIN MULCH BEDS FOLLOWING GENERAL SHAPE SHOWN IN LANDSCAPE DRAWINGS.
5. SEEDING SHOWN TO SLOPE LIMITS UNLESS OTHERWISE SHOWN.
6. CONTRACTOR TO TREAT AREAS DISTURBED BY SOUND WALL INSTALLATION NOT SHOWN ON PLANS AS FOLLOWED:
   A. SCOTISH MIX – BACK OF WALL OR ON SLOPES GREATER THAN 3:1
   B. MODOT MIX – FACE OF WALL ON SLOPES LESS THAN 3:1
   C. PER DITCH DETAIL MATRIX WITHIN DITCHES.

NOTES:
7. TREES TO BE PLANTED MIN. 8' FROM FACE OF ANY WALL IN NON-MOWED AREAS, AND A MIN. 10' FORM ANY WALL, FENCE, OR GUARDRAIL IN MOWED AREA. ALL PLANTINGS TO MAINTAIN MIN. 24" CLEARANCE (SHRUBS) AND 5' MIN. CLEARANCE (TREES) WHERE UTILITIES, INCLUDING FIBER OPTIC LINES RUN THROUGH LANDSCAPE PLANTINGS AREAS.
8. ANY PLANTING THAT COMES IN CONFLICT WITH UTILITIES OR OTHER ELEMENTS MAY BE RELOCATED BY CONTRACTOR WITHIN APPROXIMATELY 10' OF ITS ORIGINAL LOCATION AND IS CONSIDERED A MINOR CHANGE. THE CONTRACTOR SHALL ENDEAVOR TO PRESERVE THE GENERAL LAYOUT OF EACH GROUP OF PLANTINGS AND SYMMETRY OF ADJACENT PLANTING GROUPS IN MAKING SUCH ADJUSTMENTS. PROPOSED CHANGES EXCEEDING THESE LIMITS SHALL BE SUBMITTED BY FDC FOR APPROVAL BY THE LANDSCAPE ARCHITECT.
9. TREES PLANTED ON SLOPES 3:1 OR FLATTER SHALL BE SPACED A MINIMUM OF 25' ON-CENTER. TREES ON STEEPER SLOPES MAY BE SPACED UP TO 15' ON-CENTER, DEPENDING ON DESIGN SHOWN ON PLANS. TREES MAY BE SPACED CLOSER TOGETHER IN 3:1 AND FLATTER AREAS IF THEY ARE PLACED IN MULCH OR SHRUB BEDS.
10. ALL TREES MUST BE 30' AWAY FROM EDGE OF TRAVELWAY FOR I-64 AND 20' AWAY FROM EDGE OF TRAVELWAY FOR RAMPS.

LANDSCAPE PLAN LEGEND:
- SOD
- TURF SEED MIX
- MODOT SEED MIX
- NATIVE SEED MIX
- SCOTISH SEED MIX
- ROCK

MY RESPONSIBILITY COVERS ONLY THE INFORMATION IN THE CLOUDED AREAS. SEE ORIGINAL RFC SET FOR ORIGINAL STAMP AND SIGNATURE.

DESIGNED BY: DSJ	ISSUE RECORD		
	NO.	DESCRIPTION	DATE
DRAFTED BY: DSJ	B	70% PLAN REVIEW SUBMITTAL	17JULY07
	C	90% FINAL DESIGN	28SEPT07
	1	RELEASED FOR CONSTRUCTION	15NOV07
CHECKED BY: JRL	2	RFC FDC 497 ADDITIONAL TREE PLANTINGS	10OCT08
	AB	AS-BUILT FDC-497	09JUN10

PARSONS

Gateway Constructors
Granite • Fred Weber • Millstone Bangert

THE NEW I-64

THE NEW I-64 PROJECT
SEGMENT 1
LANDSCAPE PLAN
I-64
STA 841+00 TO STA 855+00

MoDOT

DRAWING NUMBER
LPPL010

AS-BUILT

File Name: C:\EXPORT\TEMP\010_LPPL_I100_S1.DGN
User: PARSONS
Time Plotted: 10:53:13 AM
Date Plotted: 7/16/2010
Pen Table: I-64_HALFSIZEBW-DATE.TBL
Plot Driver: 11X17_PDF_AB.PLT

ROUTE	STATE	DISTRICT
I-64	MO	6
JOB NO.	J6I0978	
COUNTY	STLCO/STLCITY	

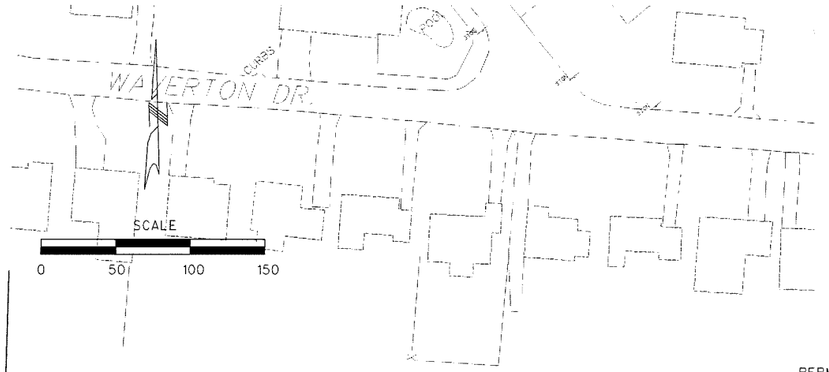

NOTES:
1. SEE STANDARD PLANS FOR GENERAL PLANTING AND SEEDING DETAILS AND NOTES.
2. SEE DRAINAGE PLANS - SHEETS DRDT012-016 FOR VEGATIVE COVER MATRIX WITH DITCHES. EXCLUDE ANY SEEDING WITHIN CONCRETE OR ROCK LINED DITCHES AS SHOWN ON DRAINAGE PLANS
3. SEE PAVING DRAWINGS FOR LOCATIONS OF SLOPE PAVING.
4. ALL SHRUBS TO BE CONTAINED WITHIN MULCH BEDS FOLLOWING GENERAL SHAPE SHOWN IN LANDSCAPE DRAWINGS.
5. SEEDING SHOWN TO SLOPE LIMITS UNLESS OTHERWISE SHOWN.
6. CONTRACTOR TO TREAT AREAS DISTURBED BY SOUND WALL INSTALLATION NOT SHOWN ON PLANS AS FOLLOWED:
   A. SCOTISH MIX - BACK OF WALL OR ON SLOPES GREATER THAN 3:1
   B. MODOT MIX - FACE OF WALL ON SLOPES LESS THAN 3:1
   C. PER DITCH DETAIL MATRIX WITHIN DITCHES.

NOTES:
7. TREES TO BE PLANTED MIN. 8' FROM FACE OF ANY WALL IN NON-MOWED AREAS, AND A MIN. 10' FORM ANY WALL, FENCE, OR GUARDRAIL IN MOWED AREA. ALL PLANTINGS TO MAINTAIN MIN. 24" CLEARANCE (SHRUBS) AND 5' MIN. CLEARANCE (TREES) WHERE UTILITIES, INCLUDING FIBER OPTIC LINES RUN THROUGH LANDSCAPE PLANTINGS AREAS.
8. ANY PLANTING THAT COMES IN CONFLICT WITH UTILITIES OR OTHER ELEMENTS MAY BE RELOCATED BY CONTRACTOR WITHIN APPROXIMATELY 10' OF ITS ORIGINAL LOCATION AND IS CONSIDERED A MINOR CHANGE. THE CONTRACTOR SHALL ENDEAVOR TO PRESERVE THE GENERAL LAYOUT OF EACH GROUP OF PLANTINGS AND SYMMETRY OF ADJACENT PLANTING GROUPS IN MAKING SUCH ADJUSTMENTS. PROPOSED CHANGES EXCEEDING THESE LIMITS SHALL BE SUBMITTED BY FDC FOR APPROVAL BY THE LANDSCAPE ARCHITECT.
9. TREES PLANTED ON SLOPES 3:1 OR FLATTER SHALL BE SPACED A MINIMUM OF 25' ON-CENTER. TREES ON STEEPER SLOPES MAY BE SPACED UP TO 15' ON-CENTER, DEPENDING ON DESIGN SHOWN ON PLANS. TREES MAY BE SPACED CLOSER TOGETHER IN 3:1 AND FLATTER AREAS IF THEY ARE PLACED IN MULCH OR SHRUB BEDS.
10. ALL TREES MUST BE 30' AWAY FROM EDGE OF TRAVELWAY FOR I-64 AND 20' AWAY FROM EDGE OF TRAVELWAY FOR RAMPS.

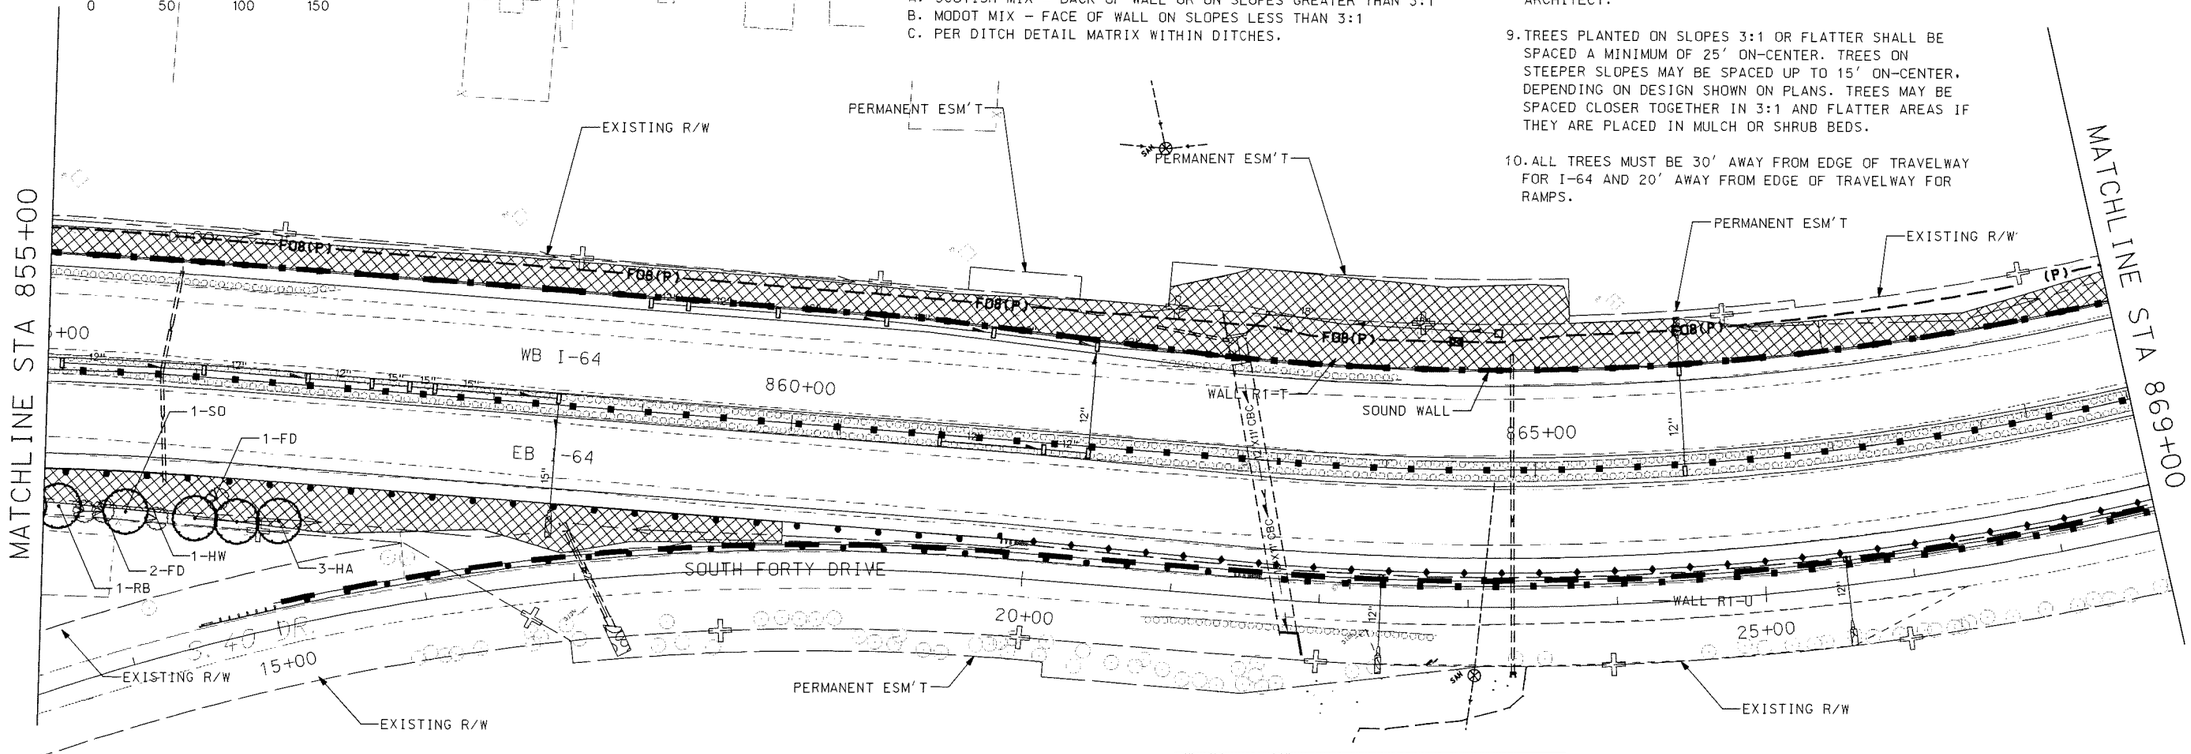

STA. 860+00 TO STA 863+40 ADD 2'- TYPE 1 AGGREGATE BASE - 4" DEPTH. SEE PAVING AND ROADWAY TYPICALS FOR ADD. INFORMATION

LANDSCAPE PLAN LEGEND:
- SOD
- TURF SEED MIX
- MODOT SEED MIX
- NATIVE SEED MIX
- SCOTISH SEED MIX
- ROCK

MY RESPONSIBILITY COVERS ONLY THE INFORMATION IN THE CLOUDED AREAS. SEE ORIGINAL RFC SET FOR ORIGINAL STAMP AND SIGNATURE.

AS-BUILT

DESIGNED BY: DSJ	NO.	DESCRIPTION	DATE
DRAFTED BY: DSJ	B	70% PLAN REVIEW SUBMITTAL	17JULY07
	C	90% FINAL DESIGN	28SEPT07
CHECKED BY: JRL	1	RELEASED FOR CONSTRUCTION	15NOV07
	2	RFC FDC 497 ADDITIONAL TREE PLANTINGS	10OCT08
	AB	AS-BUILT FDC-497	09JUN10

PARSONS

Gateway Constructors
Granite • Fred Weber • Millstone Bangert

THE NEW I-64

THE NEW I-64 PROJECT
SEGMENT 1
LANDSCAPE PLAN
I-64
STA 855+00 TO STA 869+00

MoDOT

DRAWING NUMBER
LPPL011

Pen Table: I-64_HALFSIZEBW-DATE.TBL Plot Driver: 11X17_PDF_AB.PLT
Date Plotted: 7/16/2010
Time Plotted: 10:53:22 AM
File Name: C:\EXPORT\ITEMP\011_LPPL_1100_S1.DGN
User: PARSONS

ROUTE	STATE	DISTRICT
I-64	MO	6
JOB NO.	J6I0978	
COUNTY	STLCO/STLCITY	

NOTES:
1. SEE STANDARD PLANS FOR GENERAL PLANTING AND SEEDING DETAILS AND NOTES.
2. SEE DRAINAGE PLANS - SHEETS DRDT012-016 FOR VEGATIVE COVER MATRIX WITH DITCHES. EXCLUDE ANY SEEDING WITHIN CONCRETE OR ROCK LINED DITCHES AS SHOWN ON DRAINAGE PLANS
3. SEE PAVING DRAWINGS FOR LOCATIONS OF SLOPE PAVING.
4. ALL SHRUBS TO BE CONTAINED WITHIN MULCH BEDS FOLLOWING GENERAL SHAPE SHOWN IN LANDSCAPE DRAWINGS.
5. SEEDING SHOWN TO SLOPE LIMITS UNLESS OTHERWISE SHOWN.
6. CONTRACTOR TO TREAT AREAS DISTURBED BY SOUND WALL INSTALLATION NOT SHOWN ON PLANS AS FOLLOWED:
   A. SCOTISH MIX - BACK OF WALL OR ON SLOPES GREATER THAN 3:1
   B. MODOT MIX - FACE OF WALL ON SLOPES LESS THAN 3:1
   C. PER DITCH DETAIL MATRIX WITHIN DITCHES.

NOTES:
7. TREES TO BE PLANTED MIN. 8' FROM FACE OF ANY WALL IN NON-MOWED AREAS, AND A MIN. 10' FORM ANY WALL, FENCE, OR GUARDRAIL IN MOWED AREA. ALL PLANTINGS TO MAINTAIN MIN. 24" CLEARANCE (SHRUBS) AND 5' MIN. CLEARANCE (TREES) WHERE UTILITIES, INCLUDING FIBER OPTIC LINES RUN THROUGH LANDSCAPE PLANTINGS AREAS.
8. ANY PLANTING THAT COMES IN CONFLICT WITH UTILITIES OR OTHER ELEMENTS MAY BE RELOCATED BY CONTRACTOR WITHIN APPROXIMATELY 10' OF ITS ORIGINAL LOCATION AND IS CONSIDERED A MINOR CHANGE. THE CONTRACTOR SHALL ENDEAVOR TO PRESERVE THE GENERAL LAYOUT OF EACH GROUP OF PLANTINGS AND SYMMETRY OF ADJACENT PLANTING GROUPS IN MAKING SUCH ADJUSTMENTS. PROPOSED CHANGES EXCEEDING THESE LIMITS SHALL BE SUBMITTED BY FDC FOR APPROVAL BY THE LANDSCAPE ARCHITECT.
9. TREES PLANTED ON SLOPES 3:1 OR FLATTER SHALL BE SPACED A MINIMUM OF 25' ON-CENTER. TREES ON STEEPER SLOPES MAY BE SPACED UP TO 15' ON-CENTER, DEPENDING ON DESIGN SHOWN ON PLANS. TREES MAY BE SPACED CLOSER TOGETHER IN 3:1 AND FLATTER AREAS IF THEY ARE PLACED IN MULCH OR SHRUB BEDS.
10. ALL TREES MUST BE 30' AWAY FROM EDGE OF TRAVELWAY FOR I-64 AND 20' AWAY FROM EDGE OF TRAVELWAY FOR RAMPS.

STA. 876+00 TO STA 883+00 ADD 2' - TYPE 1 AGGREGATE BASE - 4" DEPTH. SEE PAVING AND ROADWAY TYPICALS FOR ADD. INFORMATION

SCALE
0 50 100 150

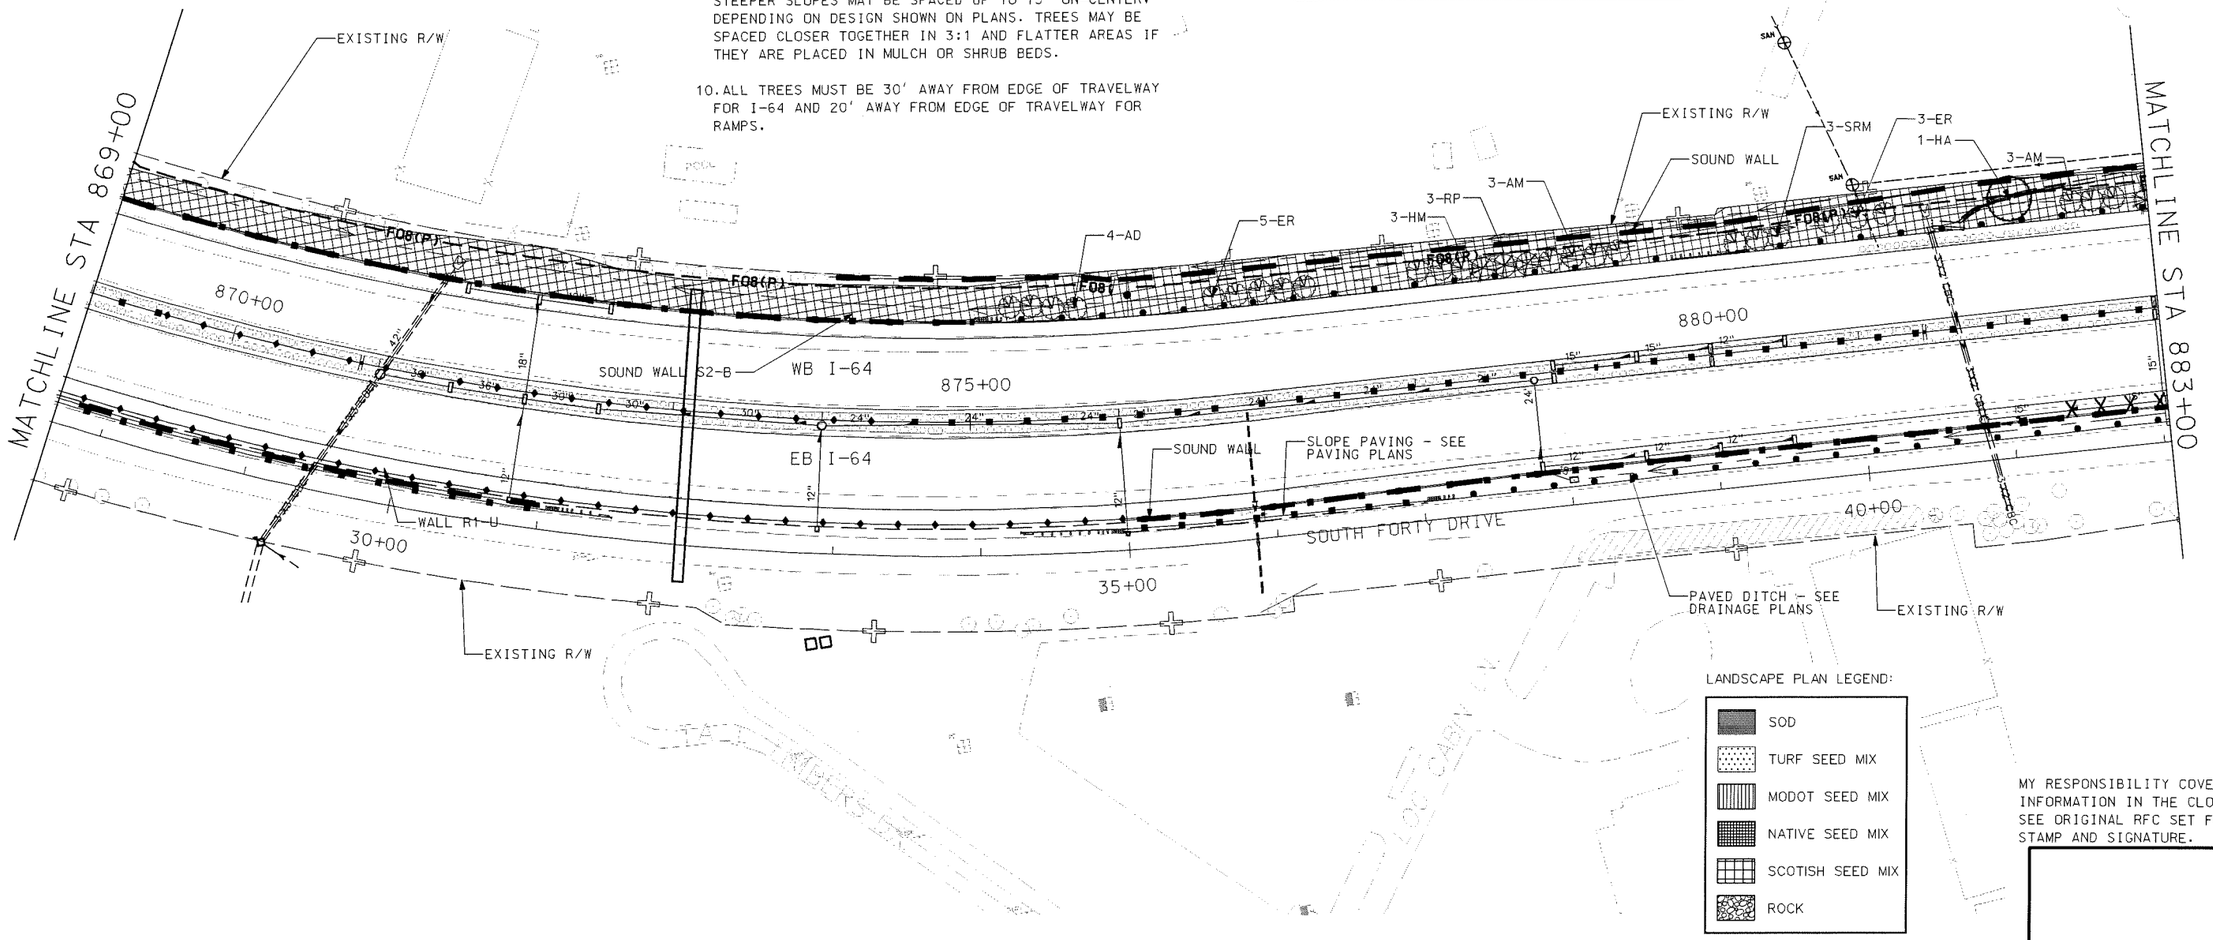

LANDSCAPE PLAN LEGEND:
- SOD
- TURF SEED MIX
- MODOT SEED MIX
- NATIVE SEED MIX
- SCOTISH SEED MIX
- ROCK

MY RESPONSIBILITY COVERS ONLY THE INFORMATION IN THE CLOUDED AREAS. SEE ORIGINAL RFC SET FOR ORIGINAL STAMP AND SIGNATURE.

DESIGNED BY: DSJ	ISSUE RECORD		
	NO.	DESCRIPTION	DATE
DRAFTED BY: DSJ	B	70% PLAN REVIEW SUBMITTAL	17JULY07
	C	90% FINAL DESIGN	28SEPT07
	1	RELEASED FOR CONSTRUCTION	15NOV07
CHECKED BY: JRL	2	RFC FDC 497 ADDITIONAL TREE PLANTINGS	10OCT08
	AB	AS-BUILT FDC-497	09JUN10

PARSONS

Gateway Constructors
Granite • Fred Weber • Millstone Bangert

THE NEW I-64

THE NEW I-64 PROJECT
SEGMENT 1
LANDSCAPE PLAN
I-64
STA 869+00 TO STA 883+00

MoDOT

DRAWING NUMBER
LPPL012

AS-BUILT

File Name: C:\EXPORT\TEMP\012_LPPL_1100_S1.DGN
User: PARSONS
Time Plotted: 10:53:30 AM Date Plotted: 7/16/2010 Pen Table: I-64_HALFSIZEBW-DATE.TBL Plot Driver: 11X17_PDF_AB.PLT

ROUTE	STATE	DISTRICT
I-64	MO	6
JOB NO.	J6I0978	
COUNTY	STLCO/STLCITY	

NOTES:
1. SEE STANDARD PLANS FOR GENERAL PLANTING AND SEEDING DETAILS AND NOTES.
2. SEE DRAINAGE PLANS - SHEETS DRDT012-016 FOR VEGATIVE COVER MATRIX WITH DITCHES. EXCLUDE ANY SEEDING WITHIN CONCRETE OR ROCK LINED DITCHES AS SHOWN ON DRAINAGE PLANS
3. SEE PAVING DRAWINGS FOR LOCATIONS OF SLOPE PAVING.
4. ALL SHRUBS TO BE CONTAINED WITHIN MULCH BEDS FOLLOWING GENERAL SHAPE SHOWN IN LANDSCAPE DRAWINGS.
5. SEEDING SHOWN TO SLOPE LIMITS UNLESS OTHERWISE SHOWN.
6. CONTRACTOR TO TREAT AREAS DISTURBED BY SOUND WALL INSTALLATION NOT SHOWN ON PLANS AS FOLLOWED:
   A. SCOTISH MIX - BACK OF WALL OR ON SLOPES GREATER THAN 3:1
   B. MODOT MIX - FACE OF WALL ON SLOPES LESS THAN 3:1
   C. PER DITCH DETAIL MATRIX WITHIN DITCHES.

NOTES:
7. TREES TO BE PLANTED MIN. 8' FROM FACE OF ANY WALL IN NON-MOWED AREAS, AND A MIN. 10' FORM ANY WALL, FENCE, OR GUARDRAIL IN MOWED AREA. ALL PLANTINGS TO MAINTAIN MIN. 24" CLEARANCE (SHRUBS) AND 5' MIN. CLEARANCE (TREES) WHERE UTILITIES, INCLUDING FIBER OPTIC LINES RUN THROUGH LANDSCAPE PLANTINGS AREAS.
8. ANY PLANTING THAT COMES IN CONFLICT WITH UTILITIES OR OTHER ELEMENTS MAY BE RELOCATED BY CONTRACTOR WITHIN APPROXIMATELY 10' OF ITS ORIGINAL LOCATION AND IS CONSIDERED A MINOR CHANGE. THE CONTRACTOR SHALL ENDEAVOR TO PRESERVE THE GENERAL LAYOUT OF EACH GROUP OF PLANTINGS AND SYMMETRY OF ADJACENT PLANTING GROUPS IN MAKING SUCH ADJUSTMENTS. PROPOSED CHANGES EXCEEDING THESE LIMITS SHALL BE SUBMITTED BY FDC FOR APPROVAL BY THE LANDSCAPE ARCHITECT.
9. TREES PLANTED ON SLOPES 3:1 OR FLATTER SHALL BE SPACED A MINIMUM OF 25' ON-CENTER. TREES ON STEEPER SLOPES MAY BE SPACED UP TO 15' ON-CENTER, DEPENDING ON DESIGN SHOWN ON PLANS. TREES MAY BE SPACED CLOSER TOGETHER IN 3:1 AND FLATTER AREAS IF THEY ARE PLACED IN MULCH OR SHRUB BEDS.
10. ALL TREES MUST BE 30' AWAY FROM EDGE OF TRAVELWAY FOR I-64 AND 20' AWAY FROM EDGE OF TRAVELWAY FOR RAMPS.

SCALE
0 50 100 150

MATCHLINE STA 883+00

885+00 890+00 895+00

WB I-64

EB I-64

SOUTH FORTY DRIVE

RAMP A

OREL LN

ROLLING ROCK LN

3-RP 2-JV 2-FD 1-TP 2-AM 3-ER 2-BO 2-FD 1-RMC 2-AM 5-RP SOUND WALL 15-AM 2-JV 1-TP 2-JV 4-ER 3-JV 2-TP 1-JV 4-FD 2-JV 2-BO 2-JV 5-SB 5-ER EXISTING R/W

3-JV 4-ER 3-SRM 3-ER

FDB(P)

EXISTING R/W

11-AM 1-ER 4-WA 45+00 4-SO 4-PA 10-ER 2-SH 8-AM 3-SO 3-SH 3-RM 2-PT 6-AD 2-SBM SOUND WALL EXISTING R/W

1-ER 2-PA 3-WA 3-AM 1-SO 10-ER 3-RB PERMANENT ESM'T

MATCHLINE STA 897+00

STA. 883+00 TO STA 893+00 ADD 2'- TYPE 1 AGGREGATE BASE - 4" DEPTH. SEE PAVING AND ROADWAY TYPICALS FOR ADD. INFORMATION

LANDSCAPE PLAN LEGEND:
- SOD
- TURF SEED MIX
- MODOT SEED MIX
- NATIVE SEED MIX
- SCOTISH SEED MIX
- ROCK

MY RESPONSIBILITY COVERS ONLY THE INFORMATION IN THE CLOUDED AREAS. SEE ORIGINAL RFC SET FOR ORIGINAL STAMP AND SIGNATURE.

DESIGNED BY: DSJ	ISSUE RECORD		
	NO.	DESCRIPTION	DATE
DRAFTED BY: DSJ	B	70% PLAN REVIEW SUBMITTAL	17JULY07
	C	90% FINAL DESIGN	28SEPT07
	1	RELEASED FOR CONSTRUCTION	15NOV07
CHECKED BY: JRL	2	RFC FDC 497 ADDITIONAL TREE PLANTINGS	10OCT08
	AB	AS-BUILT FDC-497	09JUN10

PARSONS

Gateway Constructors
Granite • Fred Weber • Millstone Bangert

THE NEW I-64

THE NEW I-64 PROJECT
SEGMENT 1
LANDSCAPE PLAN
I-64
STA 883+00 TO STA 897+00

MoDOT

DRAWING NUMBER
LPPL013

AS-BUILT

File Name: C:\EXPORT\TEMP\013_LLPPL_I100_S1.DGN
User: PARSONS
Time Plotted: 10:53:38 AM
Date Plotted: 7/16/2010
Pen Table: I-64_HALFSIZEBW-DATE.TBL Plot Driver: 11X17_PDF_AB.PLT

ROUTE	STATE	DISTRICT
I-64	MO	6
JOB NO.	J6I0978	
COUNTY	STLCO/STLCITY	

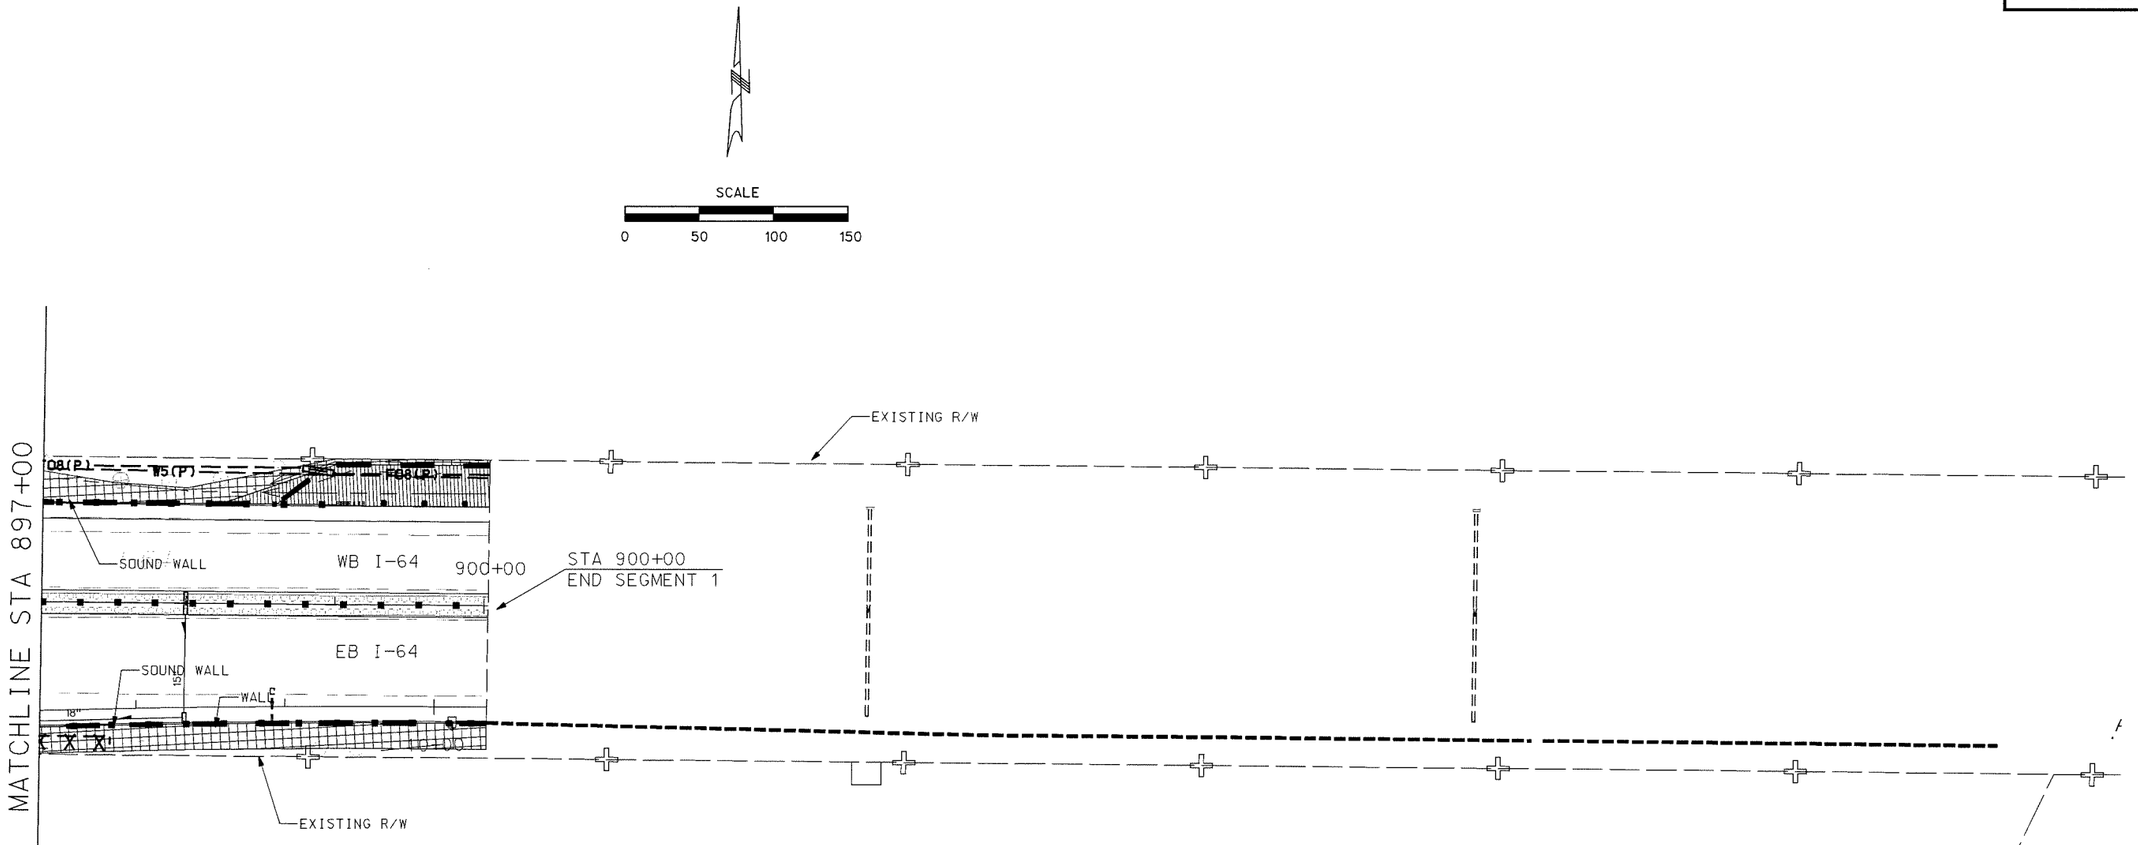

NOTES:
1. SEE STANDARD PLANS FOR GENERAL PLANTING AND SEEDING DETAILS AND NOTES.
2. SEE DRAINAGE PLANS - SHEETS DRDT012-016 FOR VEGATIVE COVER MATRIX WITH DITCHES. EXCLUDE ANY SEEDING WITHIN CONCRETE OR ROCK LINED DITCHES AS SHOWN ON DRAINAGE PLANS
3. SEE PAVING DRAWINGS FOR LOCATIONS OF SLOPE PAVING.
4. ALL SHRUBS TO BE CONTAINED WITHIN MULCH BEDS FOLLOWING GENERAL SHAPE SHOWN IN LANDSCAPE DRAWINGS.
5. SEEDING SHOWN TO SLOPE LIMITS UNLESS OTHERWISE SHOWN.
6. CONTRACTOR TO TREAT AREAS DISTURBED BY SOUND WALL INSTALLATION NOT SHOWN ON PLANS AS FOLLOWED:
   A. SCOTISH MIX - BACK OF WALL OR ON SLOPES GREATER THAN 3:1
   B. MODOT MIX - FACE OF WALL ON SLOPES LESS THAN 3:1
   C. PER DITCH DETAIL MATRIX WITHIN DITCHES.

NOTES:
7. TREES TO BE PLANTED MIN. 8' FROM FACE OF ANY WALL IN NON-MOWED AREAS, AND A MIN. 10' FORM ANY WALL, FENCE, OR GUARDRAIL IN MOWED AREA. ALL PLANTINGS TO MAINTAIN MIN. 24" CLEARANCE (SHRUBS) AND 5' MIN. CLEARANCE (TREES) WHERE UTILITIES, INCLUDING FIBER OPTIC LINES RUN THROUGH LANDSCAPE PLANTINGS AREAS.
8. ANY PLANTING THAT COMES IN CONFLICT WITH UTILITIES OR OTHER ELEMENTS MAY BE RELOCATED BY CONTRACTOR WITHIN APPROXIMATELY 10' OF ITS ORIGINAL LOCATION AND IS CONSIDERED A MINOR CHANGE. THE CONTRACTOR SHALL ENDEAVOR TO PRESERVE THE GENERAL LAYOUT OF EACH GROUP OF PLANTINGS AND SYMMETRY OF ADJACENT PLANTING GROUPS IN MAKING SUCH ADJUSTMENTS. PROPOSED CHANGES EXCEEDING THESE LIMITS SHALL BE SUBMITTED BY FDC FOR APPROVAL BY THE LANDSCAPE ARCHITECT.
9. TREES PLANTED ON SLOPES 3:1 OR FLATTER SHALL BE SPACED A MINIMUM OF 25' ON-CENTER. TREES ON STEEPER SLOPES MAY BE SPACED UP TO 15' ON-CENTER, DEPENDING ON DESIGN SHOWN ON PLANS. TREES MAY BE SPACED CLOSER TOGETHER IN 3:1 AND FLATTER AREAS IF THEY ARE PLACED IN MULCH OR SHRUB BEDS.
10. ALL TREES MUST BE 30' AWAY FROM EDGE OF TRAVELWAY FOR I-64 AND 20' AWAY FROM EDGE OF TRAVELWAY FOR RAMPS.

MY RESPONSIBILITY COVERS ONLY THE INFORMATION IN THE CLOUDED AREAS. SEE ORIGINAL RFC SET FOR ORIGINAL STAMP AND SIGNATURE.

DESIGNED BY: DSJ	ISSUE RECORD		
	NO.	DESCRIPTION	DATE
DRAFTED BY: DSJ	B	70% PLAN REVIEW SUBMITTAL	17JULY07
	C	90% FINAL DESIGN	28SEPT07
	1	RELEASED FOR CONSTRUCTION	15NOV07
CHECKED BY: JRL	2	RFC FDC 497 ADDITIONAL TREE PLANTINGS	10OCT08
	AB	AS-BUILT FDC-497	09JUN10

PARSONS

Gateway Constructors
Granite • Fred Weber • Millstone Bangert

THE NEW I-64

THE NEW I-64 PROJECT
SEGMENT 1
LANDSCAPE PLAN
I-64
STA 897+00 TO 900+00

MoDOT

DRAWING NUMBER
LPPL014

AS-BUILT

File Name: C:\EXPORT\TEMP\014_LPPL_1100_S1.DGN
User: PARSONS
Time Plotted: 10:53:47 AM
Date Plotted: 7/16/2010
Pen Table: I-64_HALFSIZEBW-DATE.TBL
Plot Driver: 11X17_PDF_AB.PLT

ROUTE	STATE	DISTRICT
I-64	MO	6
JOB NO.	J6I0978	
COUNTY	STLCO/STLCITY	

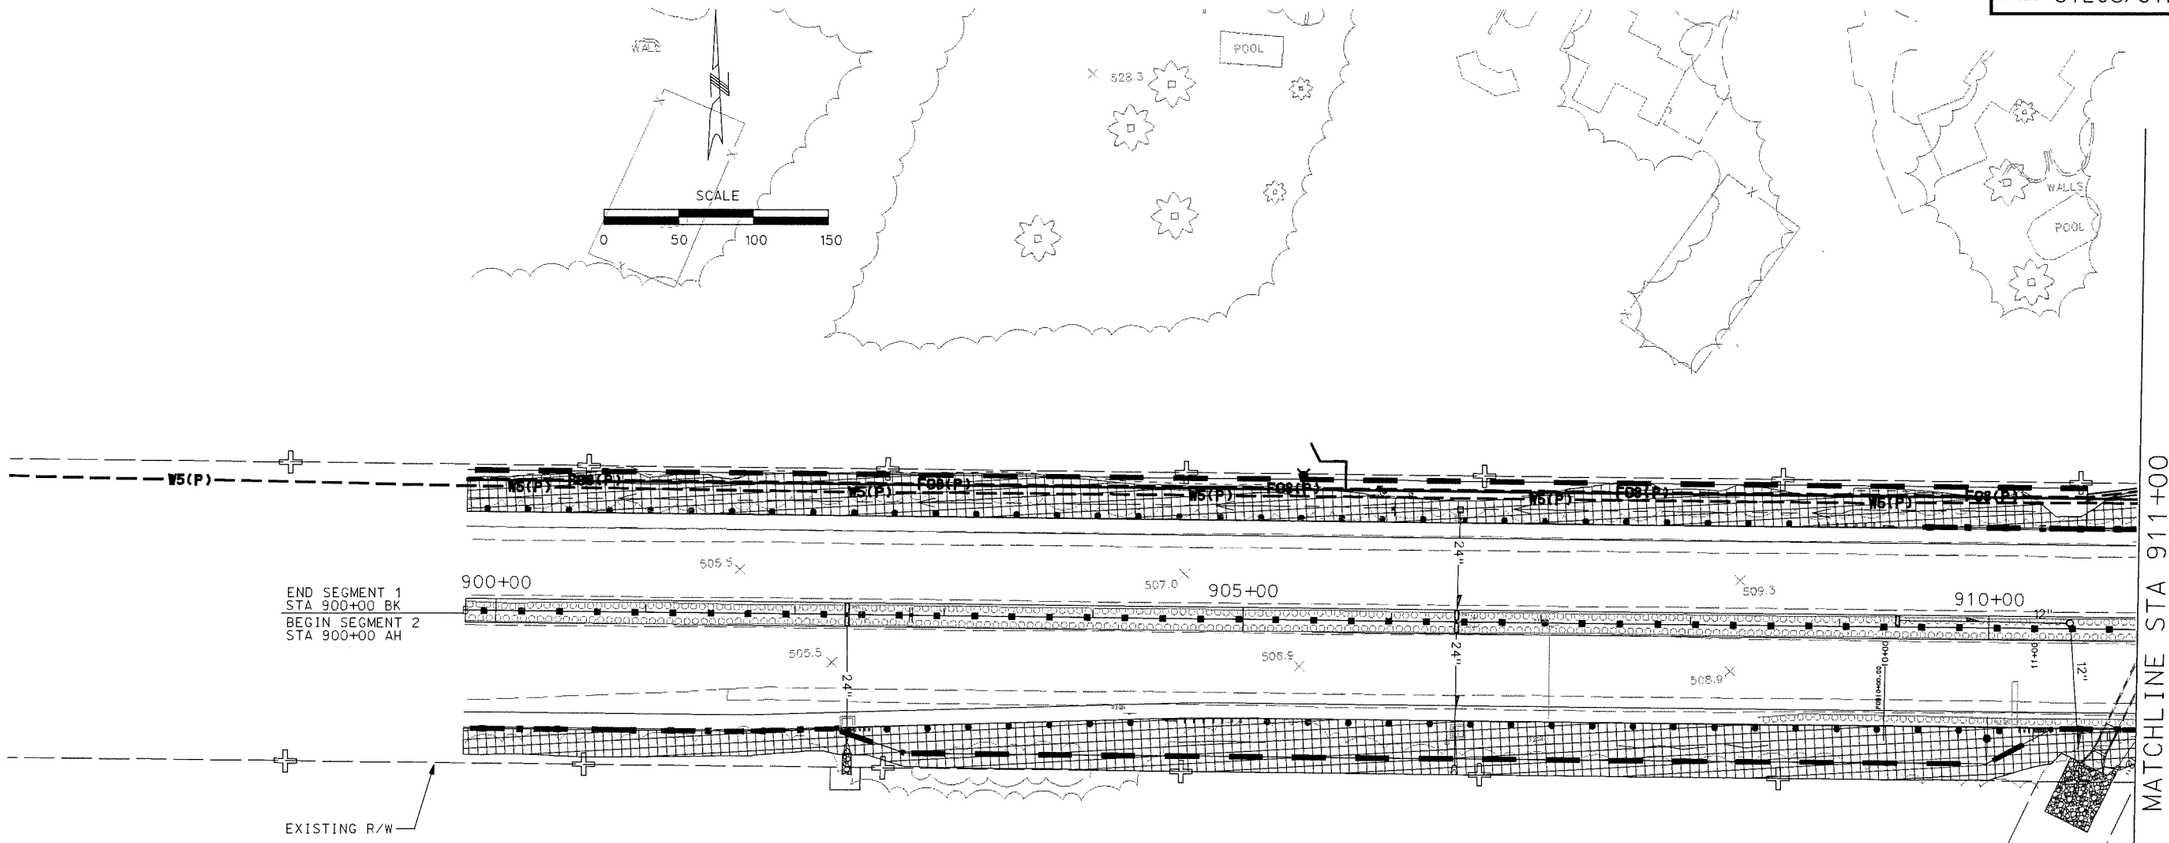

NOTES:

1. SEE STANDARD PLANS FOR GENERAL PLANTING AND SEEDING DETAILS AND NOTES.
2. SEE DRAINAGE PLANS – SHEETS DRDT012-016 FOR VEGATIVE COVER MATRIX WITH DITCHES. EXCLUDE ANY SEEDING WITHIN CONCRETE OR ROCK LINED DITCHES AS SHOWN ON DRAINAGE PLANS
3. SEE PAVING DRAWINGS FOR LOCATIONS OF SLOPE PAVING.
4. ALL SHRUBS TO BE CONTAINED WITHIN MULCH BEDS FOLLOWING GENERAL SHAPE SHOWN IN LANDSCAPE DRAWINGS.
5. SEEDING SHOWN TO SLOPE LIMITS UNLESS OTHERWISE SHOWN.
6. CONTRACTOR TO TREAT AREAS DISTURBED BY SOUND WALL INSTALLATION NOT SHOWN ON PLANS AS FOLLOWED:
   A. SCOTISH MIX – BACK OF WALL OR ON SLOPES GREATER THAN 3:1
   B. MODOT MIX – FACE OF WALL ON SLOPES LESS THAN 3:1
   C. PER DITCH DETAIL MATRIX WITHIN DITCHES.

NOTES:

7. TREES TO BE PLANTED MIN. 8' FROM FACE OF ANY WALL IN NON-MOWED AREAS, AND A MIN. 10' FORM ANY WALL, FENCE, OR GUARDRAIL IN MOWED AREA. ALL PLANTINGS TO MAINTAIN MIN. 24" CLEARANCE (SHRUBS) AND 5' MIN. CLEARANCE (TREES) WHERE UTILITIES, INCLUDING FIBER OPTIC LINES RUN THROUGH LANDSCAPE PLANTINGS AREAS.
8. ANY PLANTING THAT COMES IN CONFLICT WITH UTILITIES OR OTHER ELEMENTS MAY BE RELOCATED BY CONTRACTOR WITHIN APPROXIMATELY 10' OF ITS ORIGINAL LOCATION AND IS CONSIDERED A MINOR CHANGE. THE CONTRACTOR SHALL ENDEAVOR TO PRESERVE THE GENERAL LAYOUT OF EACH GROUP OF PLANTINGS AND SYMMETRY OF ADJACENT PLANTING GROUPS IN MAKING SUCH ADJUSTMENTS. PROPOSED CHANGES EXCEEDING THESE LIMITS SHALL BE SUBMITTED BY FDC FOR APPROVAL BY THE LANDSCAPE ARCHITECT.
9. TREES PLANTED ON SLOPES 3:1 OR FLATTER SHALL BE SPACED A MINIMUM OF 25' ON-CENTER. TREES ON STEEPER SLOPES MAY BE SPACED UP TO 15' ON-CENTER, DEPENDING ON DESIGN SHOWN ON PLANS. TREES MAY BE SPACED CLOSER TOGETHER IN 3:1 AND FLATTER AREAS IF THEY ARE PLACED IN MULCH OR SHRUB BEDS.
10. ALL TREES MUST BE 30' AWAY FROM EDGE OF TRAVELWAY FOR I-64 AND 20' AWAY FROM EDGE OF TRAVELWAY FOR RAMPS.

LANDSCAPE PLAN LEGEND:

- SOD
- TURF SEED MIX
- MODOT SEED MIX
- NATIVE SEED MIX
- SCOTISH SEED MIX
- ROCK

MY RESPONSIBILITY COVERS ONLY THE INFORMATION IN THE CLOUDED AREAS. SEE ORIGINAL RFC SET FOR ORIGINAL STAMP AND SIGNATURE.

DESIGNED BY: DSJ	ISSUE RECORD		
	NO.	DESCRIPTION	DATE
DRAFTED BY: DSJ	B	70% PLAN REVIEW SUBMITTAL	15AUG07
	C	90% FINAL DESIGN	19OCT07
	1	RELEASED FOR CONSTRUCTION	12DEC07
CHECKED BY: JRL	2	RFC FDC 497 ADDITIONAL TREE PLANTINGS	10OCT08
	AB	AS-BUILT FDC-497	11JUN10

PARSONS

Gateway Constructors
Granite • Fred Weber • Millstone Bangert

THE NEW I-64

THE NEW I-64 PROJECT

SEGMENT 2
LANDSCAPE PLAN
I-64
STA 900+00 TO STA 911+00

MoDOT

DRAWING NUMBER
LPPL001

AS-BUILT

Pen Table: I-64_HALFSIZEBW-DATE.TBL Plot Driver: 11X17_PDF_AB.PLT
Date Plotted: 7/16/2010
Time Plotted: 12:58:05 PM
File Name: C:\EXPORT\ITEMP\001_LPPL_I100_S2.DGN
User: PARSONS

ROUTE	STATE	DISTRICT
I-64	MO	6
JOB NO.	J6I0978	
COUNTY	STLCO/STLCITY	

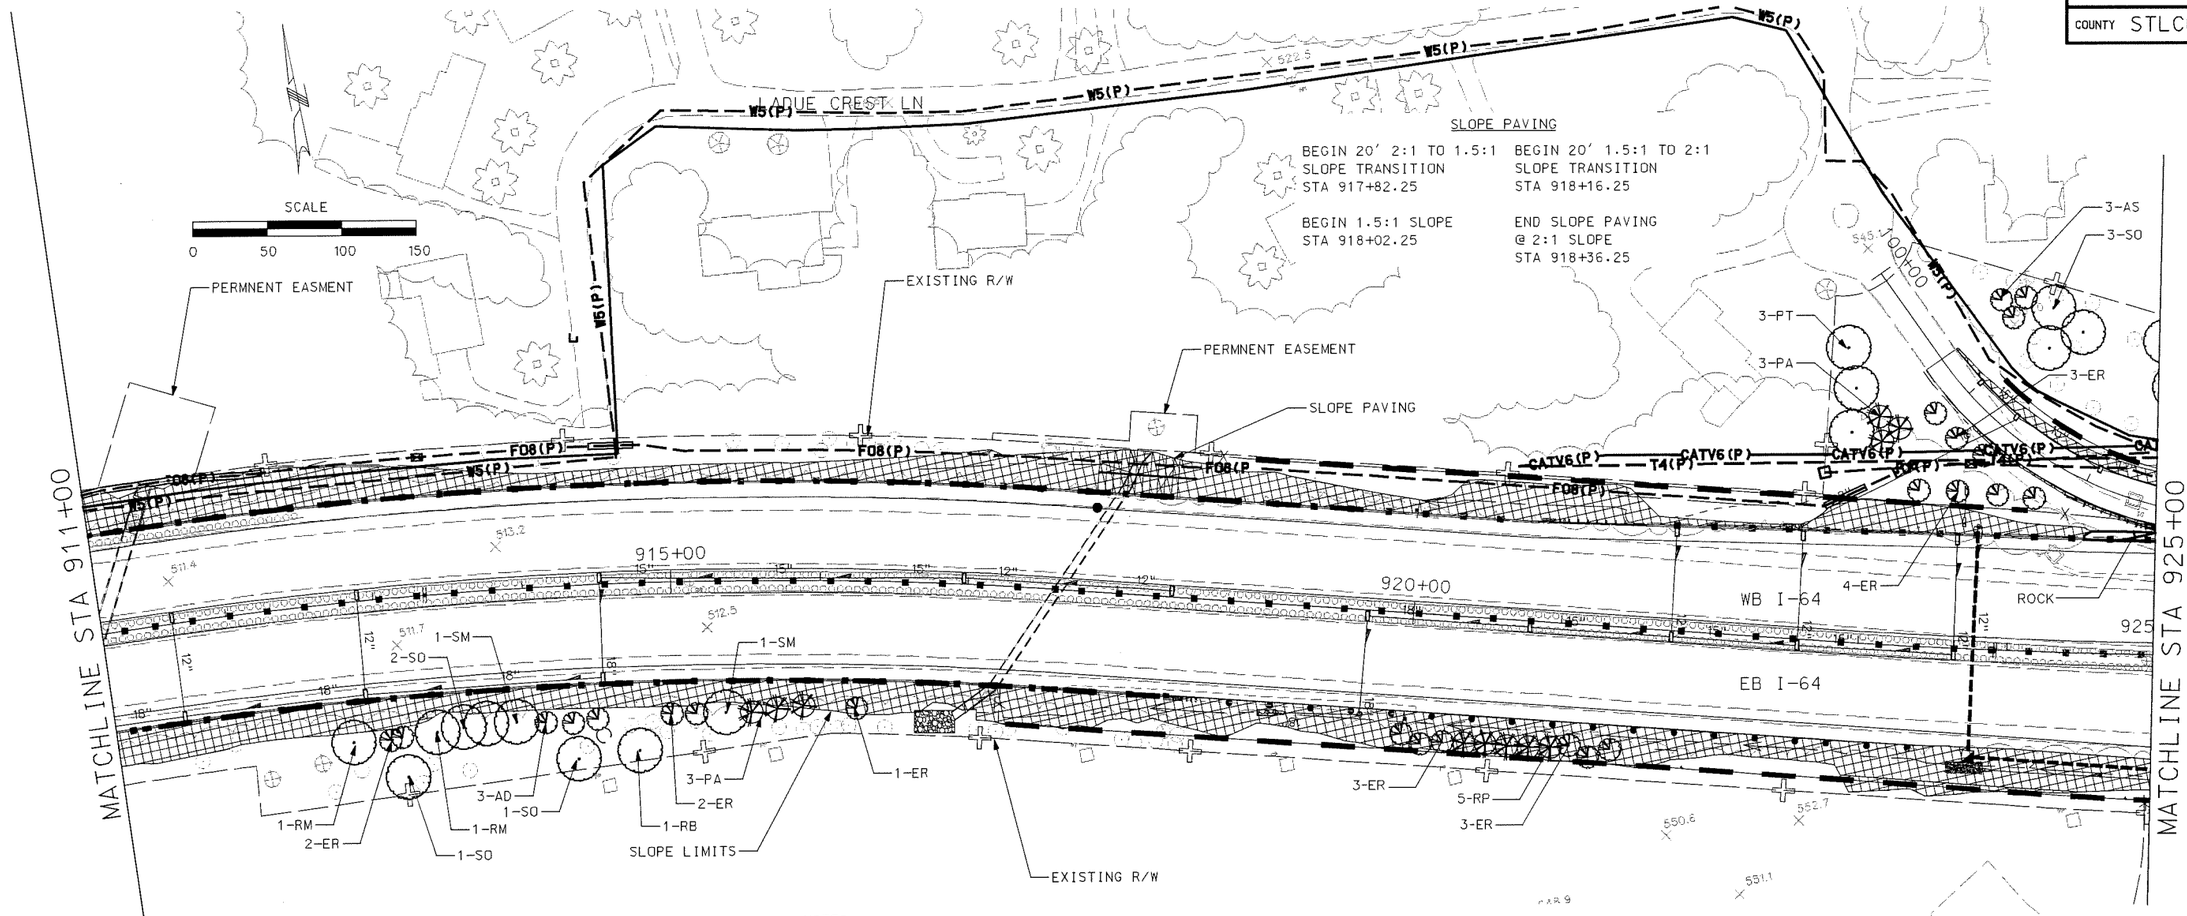

NOTES:
1. SEE STANDARD PLANS FOR GENERAL PLANTING AND SEEDING DETAILS AND NOTES.
2. SEE DRAINAGE PLANS - SHEETS DRDT012-016 FOR VEGATIVE COVER MATRIX WITH DITCHES. EXCLUDE ANY SEEDING WITHIN CONCRETE OR ROCK LINED DITCHES AS SHOWN ON DRAINAGE PLANS
3. SEE PAVING DRAWINGS FOR LOCATIONS OF SLOPE PAVING.
4. ALL SHRUBS TO BE CONTAINED WITHIN MULCH BEDS FOLLOWING GENERAL SHAPE SHOWN IN LANDSCAPE DRAWINGS.
5. SEEDING SHOWN TO SLOPE LIMITS UNLESS OTHERWISE SHOWN.
6. CONTRACTOR TO TREAT AREAS DISTURBED BY SOUND WALL INSTALLATION NOT SHOWN ON PLANS AS FOLLOWED:
   A. SCOTISH MIX - BACK OF WALL OR ON SLOPES GREATER THAN 3:1
   B. MODOT MIX - FACE OF WALL ON SLOPES LESS THAN 3:1
   C. PER DITCH DETAIL MATRIX WITHIN DITCHES.

NOTES:
7. TREES TO BE PLANTED MIN. 8' FROM FACE OF ANY WALL IN NON-MOWED AREAS, AND A MIN. 10' FORM ANY WALL, FENCE, OR GUARDRAIL IN MOWED AREA. ALL PLANTINGS TO MAINTAIN MIN. 24" CLEARANCE (SHRUBS) AND 5' MIN. CLEARANCE (TREES) WHERE UTILITIES, INCLUDING FIBER OPTIC LINES RUN THROUGH LANDSCAPE PLANTINGS AREAS.
8. ANY PLANTING THAT COMES IN CONFLICT WITH UTILITIES OR OTHER ELEMENTS MAY BE RELOCATED BY CONTRACTOR WITHIN APPROXIMATELY 10' OF ITS ORIGINAL LOCATION AND IS CONSIDERED A MINOR CHANGE. THE CONTRACTOR SHALL ENDEAVOR TO PRESERVE THE GENERAL LAYOUT OF EACH GROUP OF PLANTINGS AND SYMMETRY OF ADJACENT PLANTING GROUPS IN MAKING SUCH ADJUSTMENTS. PROPOSED CHANGES EXCEEDING THESE LIMITS SHALL BE SUBMITTED BY FDC FOR APPROVAL BY THE LANDSCAPE ARCHITECT.
9. TREES PLANTED ON SLOPES 3:1 OR FLATTER SHALL BE SPACED A MINIMUM OF 25' ON-CENTER. TREES ON STEEPER SLOPES MAY BE SPACED UP TO 15' ON-CENTER, DEPENDING ON DESIGN SHOWN ON PLANS. TREES MAY BE SPACED CLOSER TOGETHER IN 3:1 AND FLATTER AREAS IF THEY ARE PLACED IN MULCH OR SHRUB BEDS.
10. ALL TREES MUST BE 30' AWAY FROM EDGE OF TRAVELWAY FOR I-64 AND 20' AWAY FROM EDGE OF TRAVELWAY FOR RAMPS.

LANDSCAPE PLAN LEGEND:
- SOD
- TURF SEED MIX
- MODOT SEED MIX
- NATIVE SEED MIX
- SCOTISH SEED MIX
- ROCK

MY RESPONSIBILITY COVERS ONLY THE INFORMATION IN THE CLOUDED AREAS. SEE ORIGINAL RFC SET FOR ORIGINAL STAMP AND SIGNATURE.

DESIGNED BY: DSJ
DRAFTED BY: DSJ
CHECKED BY: JRL

ISSUE RECORD

NO.	DESCRIPTION	DATE
B	70% PLAN REVIEW SUBMITTAL	15AUG07
C	90% FINAL DESIGN	19OCT07
1	RELEASED FOR CONSTRUCTION	12DEC07
2	RFC FDC 497 ADDITIONAL TREE PLANTINGS	10OCT08
AB	AS-BUILT FDC-296, FDC-497	11JUN10

PARSONS

Gateway Constructors
Granite • Fred Weber • Millstone Bangert

THE NEW I-64

THE NEW I-64 PROJECT
SEGMENT 2
LANDSCAPE PLAN
I-64
STA 911+00 TO STA 925+00

MoDOT

DRAWING NUMBER
LPPL002

AS-BUILT

File Name: C:\EXPORT\ITEMP\002_LPPL_I100_S2.DGN
User: PARSONS
Time Plotted: 12:58:13 PM
Date Plotted: 7/16/2010
Pen Table: I-64_HALFSIZEBW-DATE.TBL
Plot Driver: 11X17_PDF_AB.PLT

ROUTE	STATE	DISTRICT
I-64	MO	6
JOB NO.	J6I0978	
COUNTY	STLCO/STLCITY	

NOTES:
1. SEE STANDARD PLANS FOR GENERAL PLANTING AND SEEDING DETAILS AND NOTES.
2. SEE DRAINAGE PLANS - SHEETS DRDT012-016 FOR VEGATIVE COVER MATRIX WITH DITCHES. EXCLUDE ANY SEEDING WITHIN CONCRETE OR ROCK LINED DITCHES AS SHOWN ON DRAINAGE PLANS
3. SEE PAVING DRAWINGS FOR LOCATIONS OF SLOPE PAVING.
4. ALL SHRUBS TO BE CONTAINED WITHIN MULCH BEDS FOLLOWING GENERAL SHAPE SHOWN IN LANDSCAPE DRAWINGS.
5. SEEDING SHOWN TO SLOPE LIMITS UNLESS OTHERWISE SHOWN.
6. CONTRACTOR TO TREAT AREAS DISTURBED BY SOUND WALL INSTALLATION NOT SHOWN ON PLANS AS FOLLOWED:
   A. SCOTISH MIX - BACK OF WALL OR ON SLOPES GREATER THAN 3:1
   B. MODOT MIX - FACE OF WALL ON SLOPES LESS THAN 3:1
   C. PER DITCH DETAIL MATRIX WITHIN DITCHES.

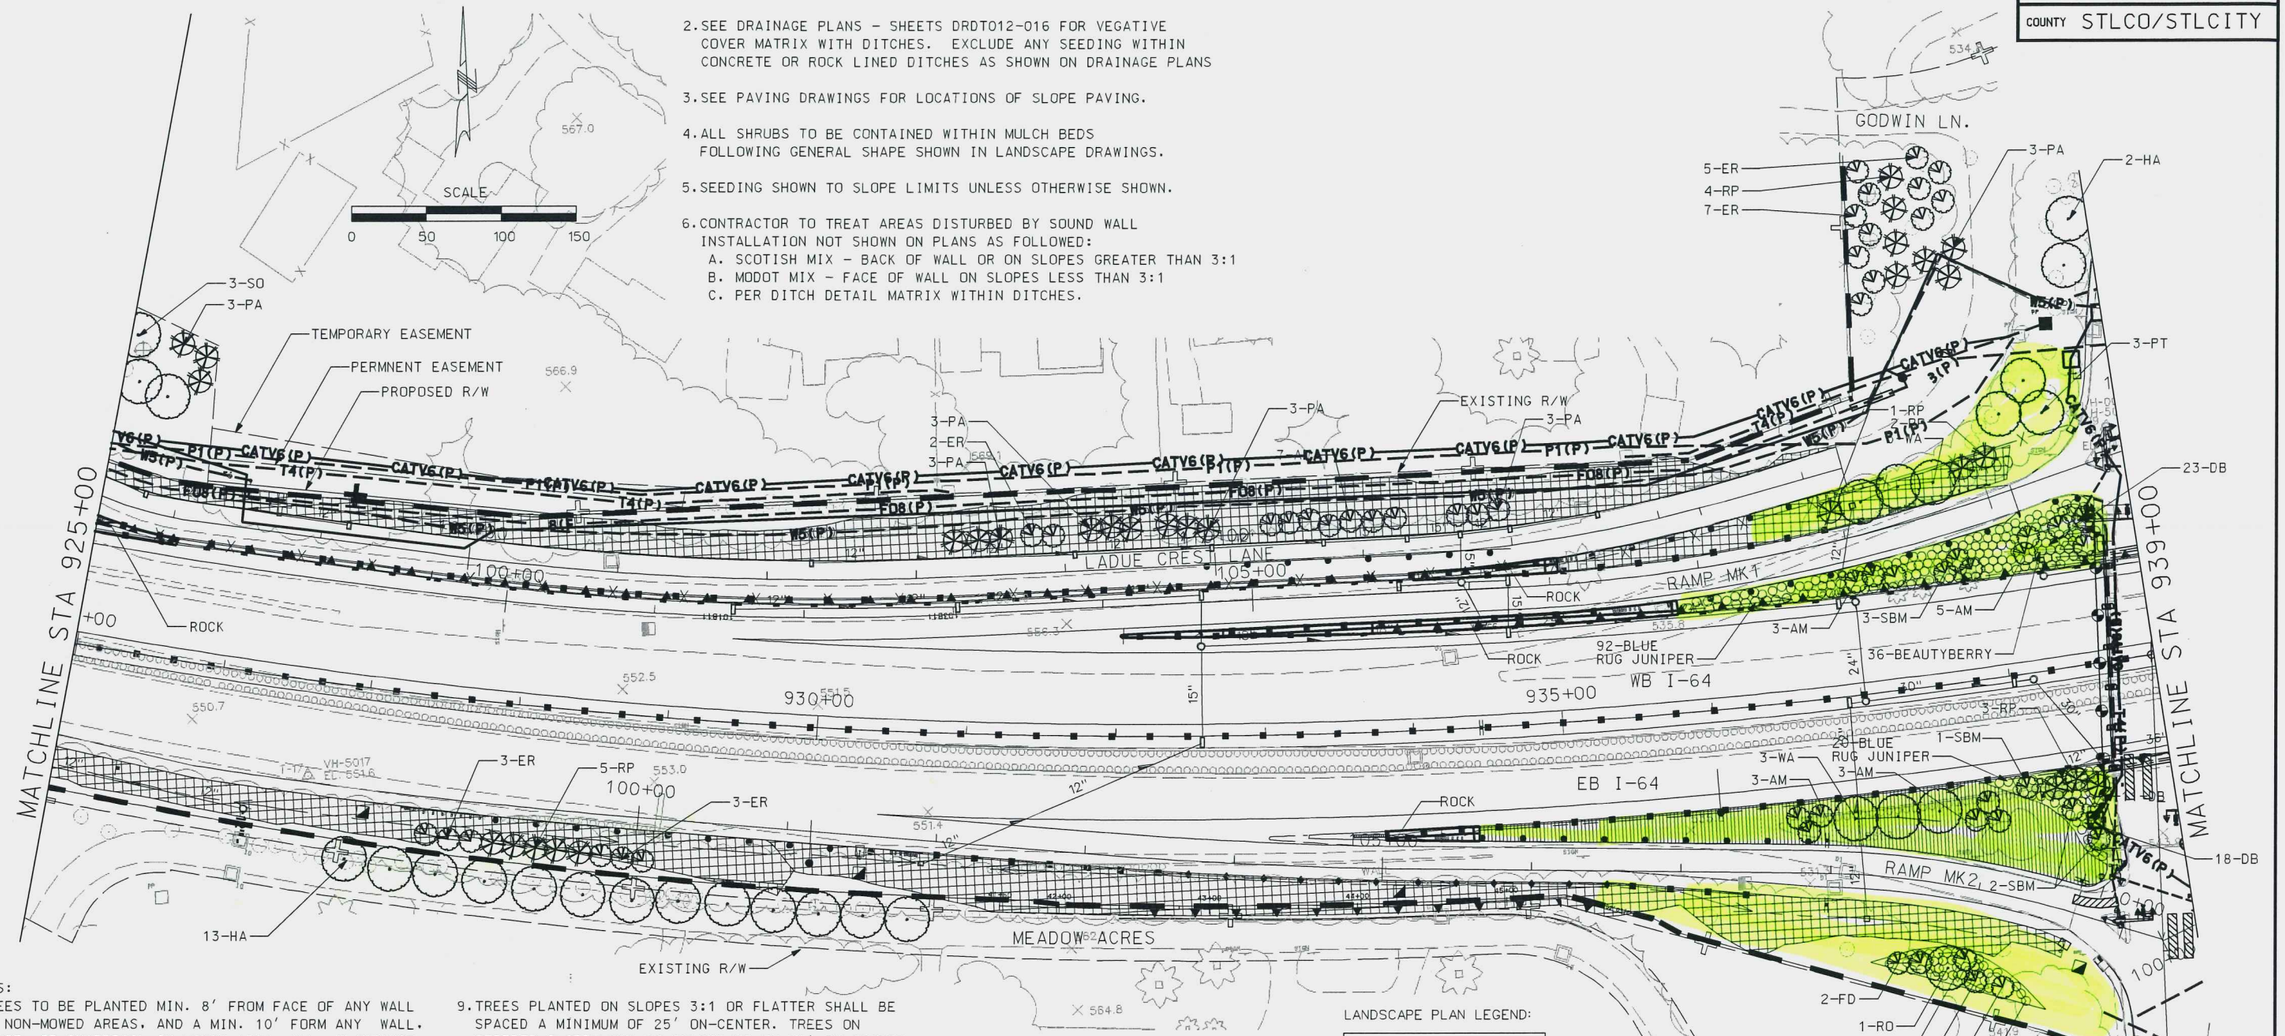

NOTES:
7. TREES TO BE PLANTED MIN. 8' FROM FACE OF ANY WALL IN NON-MOWED AREAS, AND A MIN. 10' FORM ANY WALL, FENCE, OR GUARDRAIL IN MOWED AREA. ALL PLANTINGS TO MAINTAIN MIN. 24" CLEARANCE (SHRUBS) AND 5' MIN. CLEARANCE (TREES) WHERE UTILITIES, INCLUDING FIBER OPTIC LINES RUN THROUGH LANDSCAPE PLANTINGS AREAS.
8. ANY PLANTING THAT COMES IN CONFLICT WITH UTILITIES OR OTHER ELEMENTS MAY BE RELOCATED BY CONTRACTOR WITHIN APPROXIMATELY 10' OF ITS ORIGINAL LOCATION AND IS CONSIDERED A MINOR CHANGE. THE CONTRACTOR SHALL ENDEAVOR TO PRESERVE THE GENERAL LAYOUT OF EACH GROUP OF PLANTINGS AND SYMMETRY OF ADJACENT PLANTING GROUPS IN MAKING SUCH ADJUSTMENTS. PROPOSED CHANGES EXCEEDING THESE LIMITS SHALL BE SUBMITTED BY FDC FOR APPROVAL BY THE LANDSCAPE ARCHITECT.
9. TREES PLANTED ON SLOPES 3:1 OR FLATTER SHALL BE SPACED A MINIMUM OF 25' ON-CENTER. TREES ON STEEPER SLOPES MAY BE SPACED UP TO 15' ON-CENTER, DEPENDING ON DESIGN SHOWN ON PLANS. TREES MAY BE SPACED CLOSER TOGETHER IN 3:1 AND FLATTER AREAS IF THEY ARE PLACED IN MULCH OR SHRUB BEDS.
10. ALL TREES MUST BE 30' AWAY FROM EDGE OF TRAVELWAY FOR I-64 AND 20' AWAY FROM EDGE OF TRAVELWAY FOR RAMPS.

LANDSCAPE PLAN LEGEND:

- SOD
- TURF SEED MIX
- MODOT SEED MIX
- NATIVE SEED MIX
- SCOTISH SEED MIX
- ROCK

MY RESPONSIBILITY COVERS ONLY THE INFORMATION IN THE CLOUDED AREAS. SEE ORIGINAL RFC SET FOR ORIGINAL STAMP AND SIGNATURE.

DESIGNED BY: DSJ	ISSUE RECORD		
	NO.	DESCRIPTION	DATE
DRAFTED BY: DSJ	B	70% PLAN REVIEW SUBMITTAL	15AUG07
	C	90% FINAL DESIGN	19OCT07
	1	RELEASED FOR CONSTRUCTION	12DEC07
CHECKED BY: JRL	2	RFC FDC 497 ADDITIONAL TREE PLANTINGS	10OCT08
	AB	AS-BUILT FDC-497	11JUN10

PARSONS

Gateway Constructors
Granite • Fred Weber • Millstone Bangert

THE NEW I-64

THE NEW I-64 PROJECT
SEGMENT 2
LANDSCAPE PLAN
I-64
STA 925+00 TO STA 939+00

MoDOT

DRAWING NUMBER
LPPL003

AS-BUILT

File Name: C:\EXPORT\ITEMP\003_LPPL_I100_S2.DGN
User: PARSONS
Time Plotted: 12:58:22 PM
Date Plotted: 7/16/2010
Pen Table: I-64_HALFSIZEBW-DATE.TBLPlot Driver: 11X17_PDF_AB.PLT

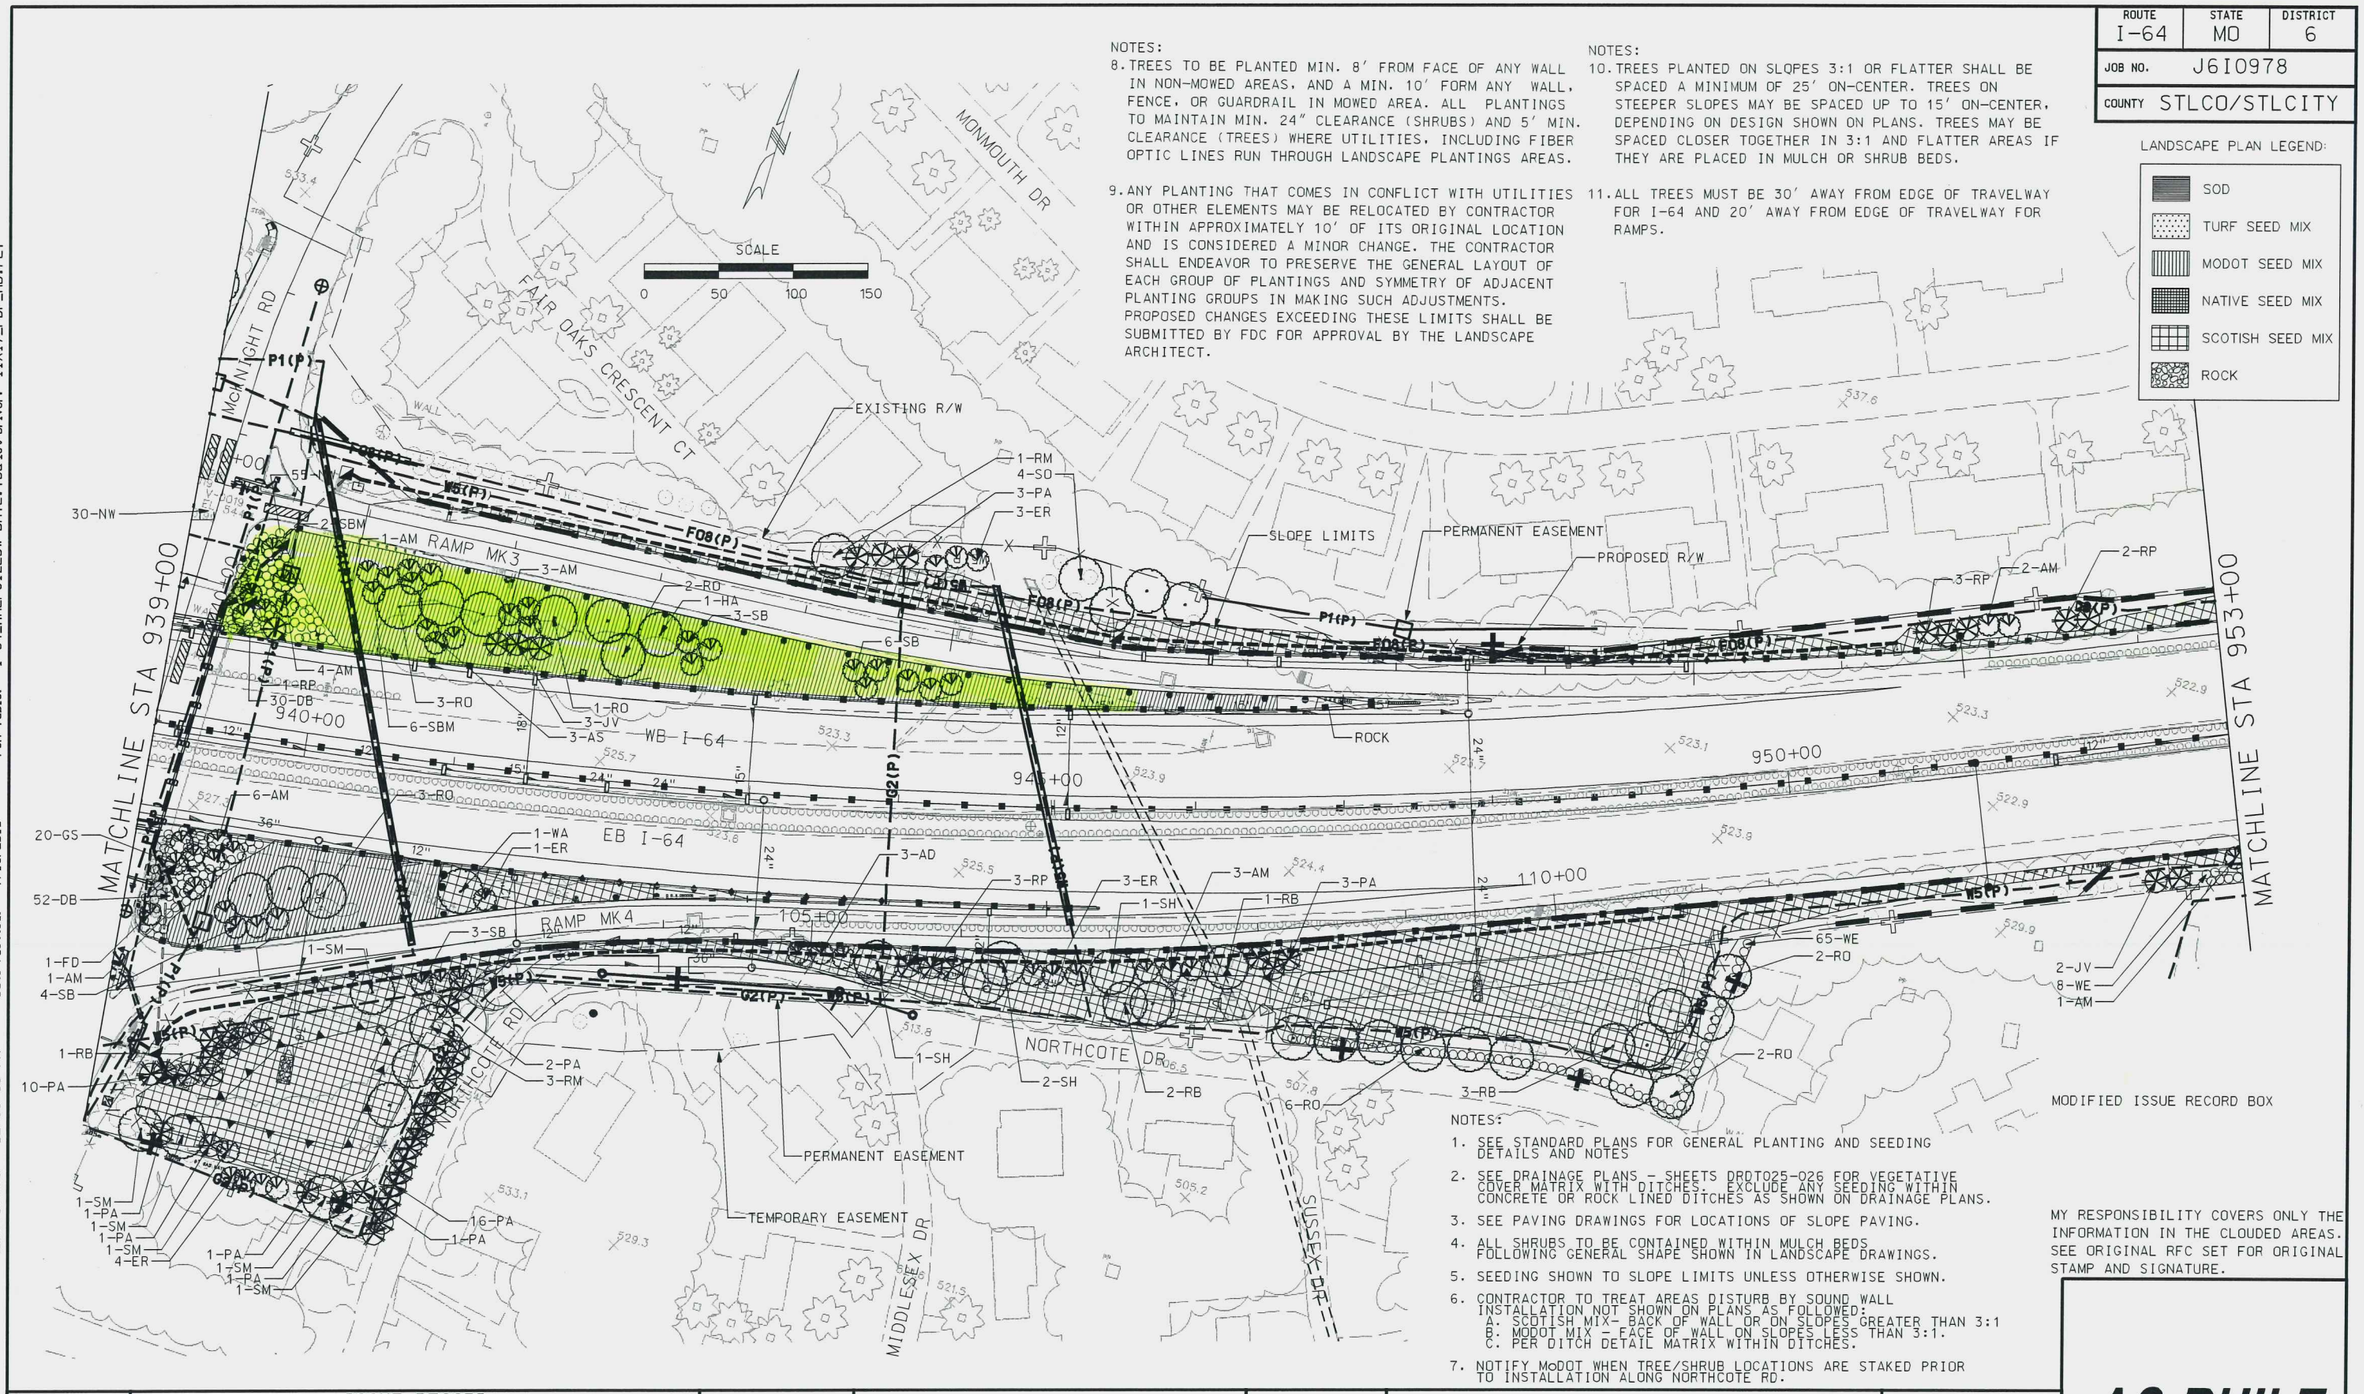

DESIGNED BY: DSJ	ISSUE RECORD		
	NO.	DESCRIPTION	DATE
DRAFTED BY: DSJ	1	RELEASED FOR CONSTRUCTION	12DEC07
	2	"RFC - RCP 064"	07MAR08
	3	RFC FDC 497 ADDITIONAL TREE PLANTINGS	10OCT08
CHECKED BY: JRL	4	RFC FDC 555 ISSUE RECORD REVISION	17OCT08
	AB	AS-BUILT FDC-497, FDC-555	11JUN10

PARSONS
Gateway Constructors
Granite • Fred Weber • Millstone Bangert
THE NEW I-64

THE NEW I-64 PROJECT
SEGMENT 2
LANDSCAPE PLAN
I-64
STA 939+00 TO STA 953+00

MoDOT
DRAWING NUMBER
LPPL004

AS-BUILT

File Name: C:\EXPORT\ITEMP\004_LPPL_I100_S2.DGN
User: PARSONS
Time Plotted: 12:58:36 PM
Date Plotted: 7/16/2010
Pen Table: I-64_HALFSIZEBW-DATE.TBL
Plot Driver: 11X17_PDF_AB.PLT

ROUTE	STATE	DISTRICT
I-64	MO	6
JOB NO.	J6I0978	
COUNTY	STLCO/STLCITY	

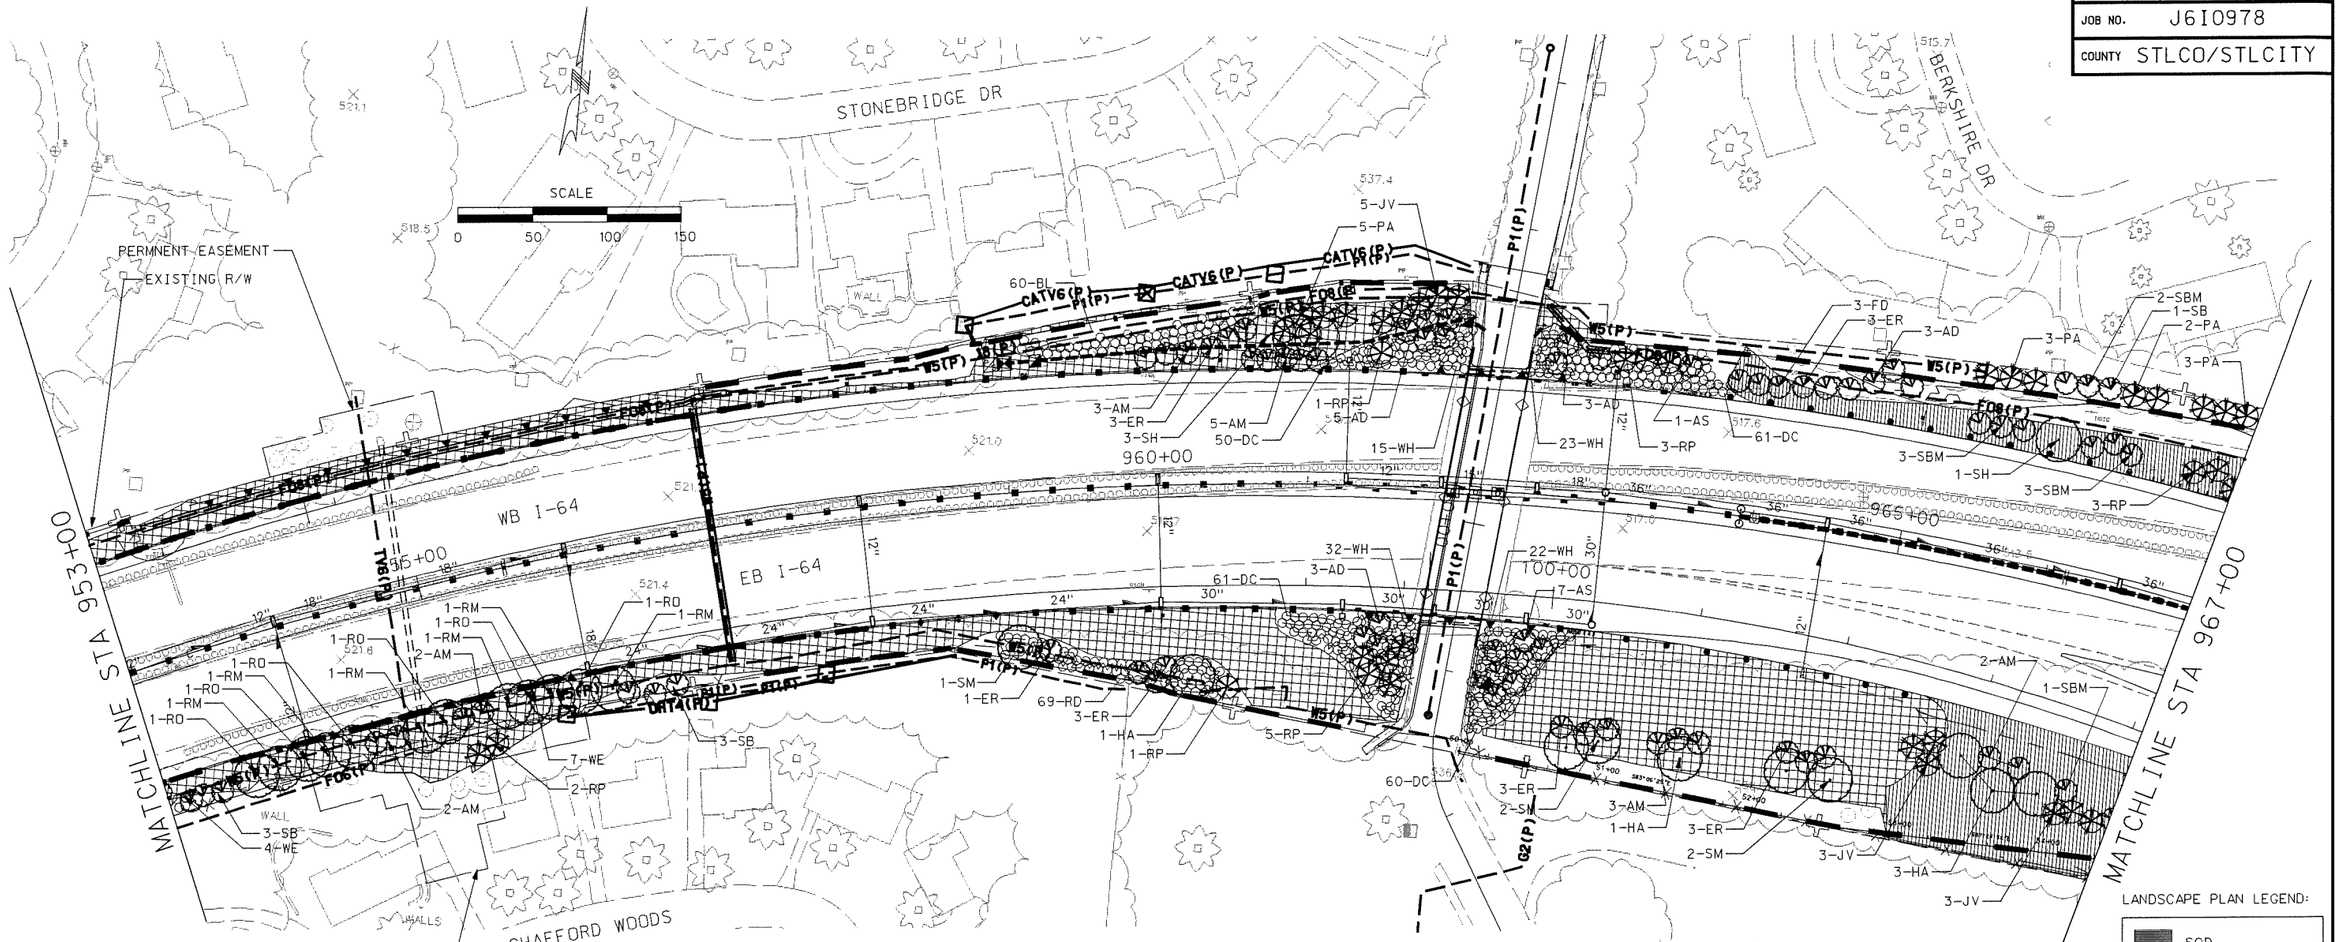

NOTES:

1. SEE STANDARD PLANS FOR GENERAL PLANTING AND SEEDING DETAILS AND NOTES.
2. SEE DRAINAGE PLANS – SHEETS DRDT012-016 FOR VEGATIVE COVER MATRIX WITH DITCHES. EXCLUDE ANY SEEDING WITHIN CONCRETE OR ROCK LINED DITCHES AS SHOWN ON DRAINAGE PLANS
3. SEE PAVING DRAWINGS FOR LOCATIONS OF SLOPE PAVING.
4. ALL SHRUBS TO BE CONTAINED WITHIN MULCH BEDS FOLLOWING GENERAL SHAPE SHOWN IN LANDSCAPE DRAWINGS.
5. SEEDING SHOWN TO SLOPE LIMITS UNLESS OTHERWISE SHOWN.
6. CONTRACTOR TO TREAT AREAS DISTURBED BY SOUND WALL INSTALLATION NOT SHOWN ON PLANS AS FOLLOWED:
   A. SCOTISH MIX – BACK OF WALL OR ON SLOPES GREATER THAN 3:1
   B. MODOT MIX – FACE OF WALL ON SLOPES LESS THAN 3:1
   C. PER DITCH DETAIL MATRIX WITHIN DITCHES.

NOTES:

7. TREES TO BE PLANTED MIN. 8' FROM FACE OF ANY WALL IN NON-MOWED AREAS, AND A MIN. 10' FORM ANY WALL, FENCE, OR GUARDRAIL IN MOWED AREA. ALL PLANTINGS TO MAINTAIN MIN. 24" CLEARANCE (SHRUBS) AND 5' MIN. CLEARANCE (TREES) WHERE UTILITIES, INCLUDING FIBER OPTIC LINES RUN THROUGH LANDSCAPE PLANTINGS AREAS.
8. ANY PLANTING THAT COMES IN CONFLICT WITH UTILITIES OR OTHER ELEMENTS MAY BE RELOCATED BY CONTRACTOR WITHIN APPROXIMATELY 10' OF ITS ORIGINAL LOCATION AND IS CONSIDERED A MINOR CHANGE. THE CONTRACTOR SHALL ENDEAVOR TO PRESERVE THE GENERAL LAYOUT OF EACH GROUP OF PLANTINGS AND SYMMETRY OF ADJACENT PLANTING GROUPS IN MAKING SUCH ADJUSTMENTS. PROPOSED CHANGES EXCEEDING THESE LIMITS SHALL BE SUBMITTED BY FDC FOR APPROVAL BY THE LANDSCAPE ARCHITECT.
9. TREES PLANTED ON SLOPES 3:1 OR FLATTER SHALL BE SPACED A MINIMUM OF 25' ON-CENTER. TREES ON STEEPER SLOPES MAY BE SPACED UP TO 15' ON-CENTER, DEPENDING ON DESIGN SHOWN ON PLANS. TREES MAY BE SPACED CLOSER TOGETHER IN 3:1 AND FLATTER AREAS IF THEY ARE PLACED IN MULCH OR SHRUB BEDS.
10. ALL TREES MUST BE 30' AWAY FROM EDGE OF TRAVELWAY FOR I-64 AND 20' AWAY FROM EDGE OF TRAVELWAY FOR RAMPS.

LANDSCAPE PLAN LEGEND:

- SOD
- TURF SEED MIX
- MODOT SEED MIX
- NATIVE SEED MIX
- SCOTISH SEED MIX
- ROCK

MY RESPONSIBILITY COVERS ONLY THE INFORMATION IN THE CLOUDED AREAS. SEE ORIGINAL RFC SET FOR ORIGINAL STAMP AND SIGNATURE.

DESIGNED BY: DSJ	NO.	DESCRIPTION	DATE
DRAFTED BY: DSJ	B	70% PLAN REVIEW SUBMITTAL	15AUG07
	C	90% FINAL DESIGN	19OCT07
	1	RELEASED FOR CONSTRUCTION	12DEC07
CHECKED BY: JRL	2	RFC FDC 497 ADDITIONAL TREE PLANTINGS	10OCT08
	AB	AS-BUILT FDC-497	11JUN10

ISSUE RECORD

PARSONS

Gateway Constructors
Granite • Fred Weber • Millstone Bangert

THE NEW I-64

THE NEW I-64 PROJECT

SEGMENT 2
LANDSCAPE PLAN
I-64
STA 953+00 TO STA 967+00

MoDOT

DRAWING NUMBER
LPPL005

AS-BUILT

File Name: C:\EXPORT\ITEMP\005_LPPL_I100_S2.DGN
User: PARSONS
Time Plotted: 12:58:50 PM
Date Plotted: 7/16/2010
Pen Tables: I-64_HALFSIZEBW-DATE.TBL
Plot Driver: 11X17_PDF_AB.PLT

ROUTE	STATE	DISTRICT
I-64	MO	6
JOB NO.	J6I0978	
COUNTY	STLCO/STLCITY	

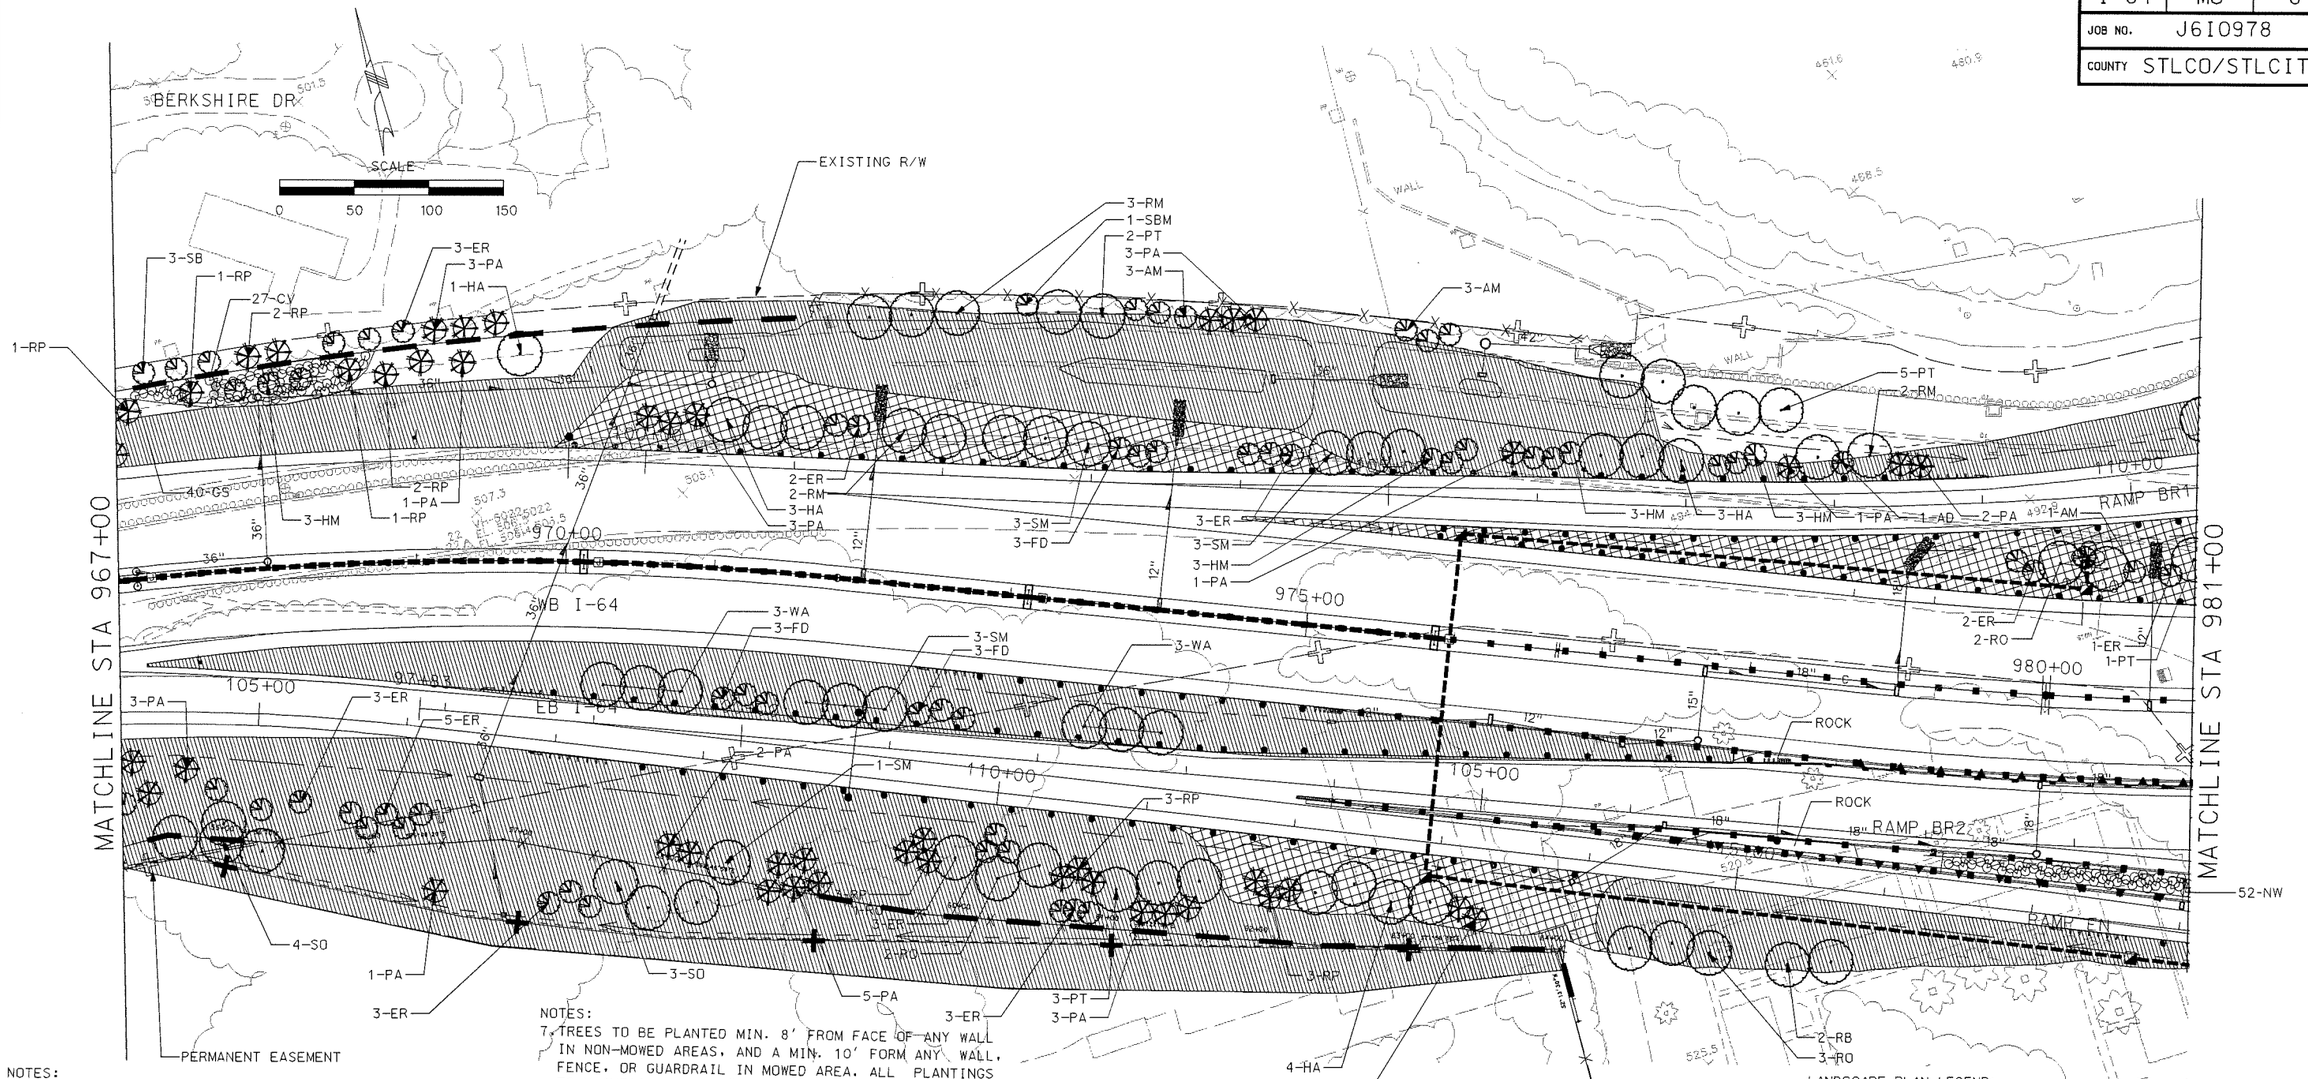

NOTES:
1. SEE STANDARD PLANS FOR GENERAL PLANTING AND SEEDING DETAILS AND NOTES.
2. SEE DRAINAGE PLANS – SHEETS DRDT012-016 FOR VEGATIVE COVER MATRIX WITH DITCHES. EXCLUDE ANY SEEDING WITHIN CONCRETE OR ROCK LINED DITCHES AS SHOWN ON DRAINAGE PLANS
2. SEE PAVING DRAWINGS FOR LOCATIONS OF SLOPE PAVING.
3. ALL SHRUBS TO BE CONTAINED WITHIN MULCH BEDS FOLLOWING GENERAL SHAPE SHOWN IN LANDSCAPE DRAWINGS.
4. SEEDING SHOWN TO SLOPE LIMITS UNLESS OTHERWISE SHOWN.

NOTES:
7. TREES TO BE PLANTED MIN. 8' FROM FACE OF ANY WALL IN NON-MOWED AREAS, AND A MIN. 10' FORM ANY WALL, FENCE, OR GUARDRAIL IN MOWED AREA. ALL PLANTINGS TO MAINTAIN MIN. 24" CLEARANCE (SHRUBS) AND 5' MIN. CLEARANCE (TREES) WHERE UTILITIES, INCLUDING FIBER OPTIC LINES RUN THROUGH LANDSCAPE PLANTINGS AREAS.
8. ANY PLANTING THAT COMES IN CONFLICT WITH UTILITIES OR OTHER ELEMENTS MAY BE RELOCATED BY CONTRACTOR WITHIN APPROXIMATELY 10' OF ITS ORIGINAL LOCATION AND IS CONSIDERED A MINOR CHANGE. THE CONTRACTOR SHALL ENDEAVOR TO PRESERVE THE GENERAL LAYOUT OF EACH GROUP OF PLANTINGS AND SYMMETRY OF ADJACENT PLANTING GROUPS IN MAKING SUCH ADJUSTMENTS. PROPOSED CHANGES EXCEEDING THESE LIMITS SHALL BE SUBMITTED BY FDC FOR APPROVAL BY THE LANDSCAPE ARCHITECT.
9. TREES PLANTED ON SLOPES 3:1 OR FLATTER SHALL BE SPACED A MINIMUM OF 25' ON-CENTER. TREES ON STEEPER SLOPES MAY BE SPACED UP TO 15' ON-CENTER, DEPENDING ON DESIGN SHOWN ON PLANS. TREES MAY BE SPACED CLOSER TOGETHER IN 3:1 AND FLATTER AREAS IF THEY ARE PLACED IN MULCH OR SHRUB BEDS.
10. ALL TREES MUST BE 30' AWAY FROM EDGE OF TRAVELWAY FOR I-64 AND 20' AWAY FROM EDGE OF TRAVELWAY FOR RAMPS.

LANDSCAPE PLAN LEGEND:
- SOD
- TURF SEED MIX
- MODOT SEED MIX
- NATIVE SEED MIX
- SCOTISH SEED MIX
- ROCK

MY RESPONSIBILITY COVERS ONLY THE INFORMATION IN THE CLOUDED AREAS. SEE ORIGINAL RFC SET FOR ORIGINAL STAMP AND SIGNATURE.

DESIGNED BY: DSJ	NO.	DESCRIPTION	DATE
DRAFTED BY: DSJ	B	70% PLAN REVIEW SUBMITTAL	15AUG07
	C	90% FINAL DESIGN	19OCT07
	1	RELEASED FOR CONSTRUCTION	12DEC07
CHECKED BY: JRL	2	RFC FDC 497 ADDITIONAL TREE PLANTINGS	10OCT08
	AB	AS-BUILT FDC-497	11JUN10

PARSONS

Gateway Constructors
Granite • Fred Weber • Millstone Bangert

THE NEW I-64

THE NEW I-64 PROJECT
SEGMENT 2
LANDSCAPE PLAN
I-64
STA 967+00 TO STA 981+00

MoDOT

DRAWING NUMBER
LPPL006

AS-BUILT

File Name: C:\EXPORT\ITEMP\006_LPPL_I100_S2.DGN
User: PARSONS
Time Plotted: 12:59:02 PM
Date Plotted: 7/16/2010
Pen Table: I-64_HALFSIZEBW-DATE.TBL
Plot Driver: 11X17_PDF_AB.PLT

ROUTE	STATE	DISTRICT
I-64	MO	6
JOB NO.	J6I0978	
COUNTY	STLCO/STLCITY	

MATCHLINE BRENTWOOD BLVD STA 107+00

NOTES:

1. SEE STANDARD PLANS FOR GENERAL PLANTING AND SEEDING DETAILS AND NOTES.
2. SEE DRAINAGE PLANS - SHEETS DRDT025-026 FOR VEGETATIVE COVER MATRIX WITH DITCHES. EXCLUDE ANY SEEDING WITHIN CONCRETE OR ROCK LINED DITCHES AS SHOWN ON DRAINAGE PLANS
3. SEE PAVING DRAWINGS FOR LOCATIONS OF SLOPE PAVING.
4. ALL SHRUBS TO BE CONTAINED WITHIN MULCH BEDS FOLLOWING GENERAL SHAPE SHOWN IN LANDSCAPE DRAWINGS.
5. SEEDING SHOWN TO SLOPE LIMITS UNLESS OTHERWISE SHOWN.
6. CONTRACTOR TO TREAT AREAS DISTURBED BY SOUND WALL INSTALLATION NOT SHOWN ON PLANS AS FOLLOWED:
   A. SCOTISH MIX - BACK OF WALL OR ON SLOPES GREATER THAN 3:1
   B. MODOT MIX - FACE OF WALL ON SLOPES LESS THAN 3:1
   C. PER DITCH DETAIL MATRIX WITHIN DITCHES.
7. ALL PLANTINGS SHOWN WITHIN THE INFIELD BOUNDED BY EAGER ROAD, BRENTWOOD BLVD, RAMP BR-HN AND I-170 SB CONNECTOR SHALL BE DELIVERED TO THE CITY OF BRENTWOOD AT PROJECT COMPLETION INSTEAD OF BEING INSTALLED. COORDINATE THE TIMING AND LOCATION OF DELIVERY WITH THE CITY.
8. ENGINEER'S RESPONSIBILITY IS LIMITED TO CLOUDED AREAS.

LANDSCAPE PLAN LEGEND:

- SOD
- TURF SEED MIX
- MODOT SEED MIX
- NATIVE SEED MIX
- SCOTISH SEED MIX
- ROCK

DESIGNED BY: JEN	ISSUE RECORD		
	NO.	DESCRIPTION	DATE
DRAFTED BY: JEN	B	70% PLAN REVIEW SUBMITTAL	15AUG07
	C	90% FINAL DESIGN	19OCT07
	1	RELEASED FOR CONSTRUCTION	12DEC07
CHECKED BY: NTF	2	BRENTWOOD ENHANCEMENTS, FDC 648	13MAR09
	AB	AS-BUILT FDC-648	11JUN10

PARSONS

Gateway Constructors
Granite • Fred Weber • Millstone Bangert

THE NEW I-64

THE NEW I-64 PROJECT
SEGMENT 2
LANDSCAPE PLAN
BRENTWOOD BLVD
BEGINNING TO STA 103+00

MoDOT

DRAWING NUMBER
LPPL007

AS-BUILT

File Name: C:\EXPORT\ITEMP\007_LPPL_I100_S2.DGN
User: PARSONS
Time Plotted: 12:59:14 PM
Date Plotted: 7/16/2010
Pen Table: I-64_HALFSIZEBW-DATE.TBLPlot Driver: 11X17_PDF_AB.PLT

NOTES:
1. SEE STANDARD PLANS FOR GENERAL PLANTING AND SEEDING DETAILS AND NOTES.

2. SEE DRAINAGE PLANS – SHEETS DRDT012-016 FOR VEGATIVE COVER MATRIX WITH DITCHES. EXCLUDE ANY SEEDING WITHIN CONCRETE OR ROCK LINED DITCHES AS SHOWN ON DRAINAGE PLANS

2. SEE PAVING DRAWINGS FOR LOCATIONS OF SLOPE PAVING.

3. ALL SHRUBS TO BE CONTAINED WITHIN MULCH BEDS FOLLOWING GENERAL SHAPE SHOWN IN LANDSCAPE DRAWINGS.

4. SEEDING SHOWN TO SLOPE LIMITS UNLESS OTHERWISE SHOWN.

5. CONTRACTOR TO TREAT AREAS DISTURBED BY SOUND WALL INSTALLATION NOT SHOWN ON PLANS AS FOLLOWED:
   A. SCOTISH MIX – BACK OF WALL OR ON SLOPES GREATER THAN 3:1
   B. MODOT MIX – FACE OF WALL ON SLOPES LESS THAN 3:1
   C. PER DITCH DETAIL MATRIX WITHIN DITCHES.

NOTES:
6. TREES TO BE PLANTED MIN. 8' FROM FACE OF ANY WALL IN NON-MOWED AREAS, AND A MIN. 10' FORM ANY WALL, FENCE, OR GUARDRAIL IN MOWED AREA. ALL PLANTINGS TO MAINTAIN MIN. 24" CLEARANCE (SHRUBS) AND 5' MIN. CLEARANCE (TREES) WHERE UTILITIES, INCLUDING FIBER OPTIC LINES RUN THROUGH LANDSCAPE PLANTINGS AREAS.

8. TREES PLANTED ON SLOPES 3:1 OR FLATTER SHALL BE SPACED A MINIMUM OF 25' ON-CENTER. TREES ON STEEPER SLOPES MAY BE SPACED UP TO 15' ON-CENTER, DEPENDING ON DESIGN SHOWN ON PLANS. TREES MAY BE SPACED CLOSER TOGETHER IN 3:1 AND FLATTER AREAS IF THEY ARE PLACED IN MULCH OR SHRUB BEDS.

9. ALL TREES MUST BE 30' AWAY FROM EDGE OF TRAVELWAY FOR I-64 AND 20' AWAY FROM EDGE OF TRAVELWAY FOR RAMPS.

10. ALL PLANTINGS SHOWN WITHIN THE INFIELD BOUNDED BY EAGER ROAD, BRENTWOOD BLVD, RAMP BR-HN AND I-170 SB CONNECTOR SHALL BE DELIVERED TO THE CITY OF BRENTWOOD AT PROJECT COMPLETION INSTEAD OF BEING INSTALLED. COORDINATE THE TIMING AND LOCATION OF DELIVERY WITH THE CITY.

ROUTE	STATE	DISTRICT
I-64	MO	6
JOB NO.	J6I0978	
COUNTY	STLCO/STLCITY	

SCALE 0 50 100 150

MATCHLINE BRENTWOOD BLVD STA 110+40

MATCHLINE STA 981+00

MATCHLINE STA 995+00

MATCHLINE BRENTWOOD BLVD STA 103+00

RAMP BR1 · RAMP BR2 · RAMP EN · RAMP SW · RAMP BR3 · RAMP HN-BR · RAMP BR-HN · RAMP HN1 · RAMP TW · I-170 SB CONNECTOR · I-170 NB CONNECTOR · WB I-64 · EB I-64 · BRENTWOOD BLVD · EAGER RD

LANDSCAPE PLAN LEGEND:
- SOD
- TURF SEED MIX
- MODOT SEED MIX
- NATIVE SEED MIX
- SCOTISH SEED MIX
- ROCK

7. ANY [illegible] THAT COMES IN CONFLICT WITH UTILITIES OR OTHER ELEMENTS MAY BE RELOCATED BY CONTRACTOR WITHIN APPROXIMATELY 10' OF ITS ORIGINAL LOCATION AND IS CONSIDERED A MINOR CHANGE. THE CONTRACTOR SHALL ENDEAVOR TO PRESERVE THE GENERAL LAYOUT OF EACH GROUP OF PLANTINGS AND SYMMETRY OF ADJACENT PLANTING GROUPS IN MAKING SUCH ADJUSTMENTS. PROPOSED CHANGES EXCEEDING THESE LIMITS SHALL BE SUBMITTED BY FDC FOR APPROVAL BY THE LANDSCAPE ARCHITECT.

NOT PLANTED. FUTURE CITY OF BRENTWOOD ENHANCEMENTS. PLANTINGS TO BE DELIVERED TO CITY AND LOCATED PER CITY ENHANCEMENT PLAN

MY RESPONSIBILITY COVERS ONLY THE INFORMATION IN THE CLOUDED AREAS. SEE ORIGINAL RFC SET FOR ORIGINAL STAMP AND SIGNATURE.

DESIGNED BY: DSJ	ISSUE RECORD		
DRAFTED BY: DSJ	NO.	DESCRIPTION	DATE
	C	90% FINAL DESIGN	19OCT07
	1	RELEASED FOR CONSTRUCTION	12DEC07
	2	RFC FDC 497 ADDITIONAL TREE PLANTINGS	10OCT08
CHECKED BY: JRL	3	BRENTWOOD ENHANCEMENTS, FDC 648	13MAR09
	AB	AS-BUILT FDC-497, FDC-648	11JUN10

PARSONS

Gateway Constructors
Granite • Fred Weber • Millstone Bangert

THE NEW I-64

THE NEW I-64 PROJECT
SEGMENT 2
LANDSCAPE PLAN
I-64
STA 981+00 TO STA 995+00

MoDOT

DRAWING NUMBER
LPPL008

AS-BUILT

File Name: C:\EXPORT\ITEMP\008_LPPL_1100_S2.DGN
User: PARSONS
Time Plotted: 12:59:22 PM
Date Plotted: 7/16/2010
Pen Table: I-64_HALFSIZEBW-DATE.TBL
Plot Driver: 11X17_PDF_AB.PLT

ROUTE	STATE	DISTRICT
I-64	MO	6
JOB NO.	J6I0978	
COUNTY	STLCO/STLCITY	

SCALE
0 50 100 150

NOTES:

1. SEE STANDARD PLANS FOR GENERAL PLANTING AND SEEDING DETAILS AND NOTES
2. SEE DRAINAGE PLANS – SHEETS DRDT025-026 FOR VEGETATIVE COVER MATRIX WITH DITCHES. EXCLUDE ANY SEEDING WITHIN CONCRETE OR ROCK LINED DITCHES AS SHOWN ON DRAINAGE PLANS.
3. SEE PAVING DRAWINGS FOR LOCATIONS OF SLOPE PAVING.
4. ALL SHRUBS TO BE CONTAINED WITHIN MULCH BEDS FOLLOWING GENERAL SHAPE SHOWN IN LANDSCAPE DRAWINGS.
5. SEEDING SHOWN TO SLOPE LIMITS UNLESS OTHERWISE SHOWN.
6. CONTRACTOR TO TREAT AREAS DISTURB BY SOUND WALL INSTALLATION NOT SHOWN ON PLANS AS FOLLOWED:
   A. SCOTISH MIX– BACK OF WALL OR ON SLOPES GREATER THAN 3:1
   B. MODOT MIX – FACE OF WALL ON SLOPES LESS THAN 3:1.
   C. PER DITCH DETAIL MATRIX WITHIN DITCHES.
7. CONTRACTOR TO INSTALL MIN. 10' WIDE ROCK BLANKET UNDER ALL OVERHEAD BRIDGE DRAINS. BLANKET TO RUN CONTINUOUS, MIN' 10' PAST FIRST AND LAST DRAIN.

NOTES:

8. TREES TO BE PLANTED MIN. 8' FROM FACE OF ANY WALL IN NON-MOWED AREAS, AND A MIN. 10' FORM ANY WALL, FENCE, OR GUARDRAIL IN MOWED AREA. ALL PLANTINGS TO MAINTAIN MIN. 24" CLEARANCE (SHRUBS) AND 5' MIN. CLEARANCE (TREES) WHERE UTILITIES, INCLUDING FIBER OPTIC LINES RUN THROUGH LANDSCAPE PLANTINGS AREAS.
9. ANY PLANTING THAT COMES IN CONFLICT WITH UTILITIES OR OTHER ELEMENTS MAY BE RELOCATED BY CONTRACTOR WITHIN APPROXIMATELY 10' OF ITS ORIGINAL LOCATION AND IS CONSIDERED A MINOR CHANGE. THE CONTRACTOR SHALL ENDEAVOR TO PRESERVE THE GENERAL LAYOUT OF EACH GROUP OF PLANTINGS AND SYMMETRY OF ADJACENT PLANTING GROUPS IN MAKING SUCH ADJUSTMENTS. PROPOSED CHANGES EXCEEDING THESE LIMITS SHALL BE SUBMITTED BY FDC FOR APPROVAL BY THE LANDSCAPE ARCHITECT.
10. TREES PLANTED ON SLOPES 3:1 OR FLATTER SHALL BE SPACED A MINIMUM OF 25' ON-CENTER. TREES ON STEEPER SLOPES MAY BE SPACED UP TO 15' ON-CENTER, DEPENDING ON DESIGN SHOWN ON PLANS. TREES MAY BE SPACED CLOSER TOGETHER IN 3:1 AND FLATTER AREAS IF THEY ARE PLACED IN MULCH OR SHRUB BEDS.
11. ALL TREES MUST BE 30' AWAY FROM EDGE OF TRAVELWAY FOR I-64 AND 20' AWAY FROM EDGE OF TRAVELWAY FOR RAMPS.

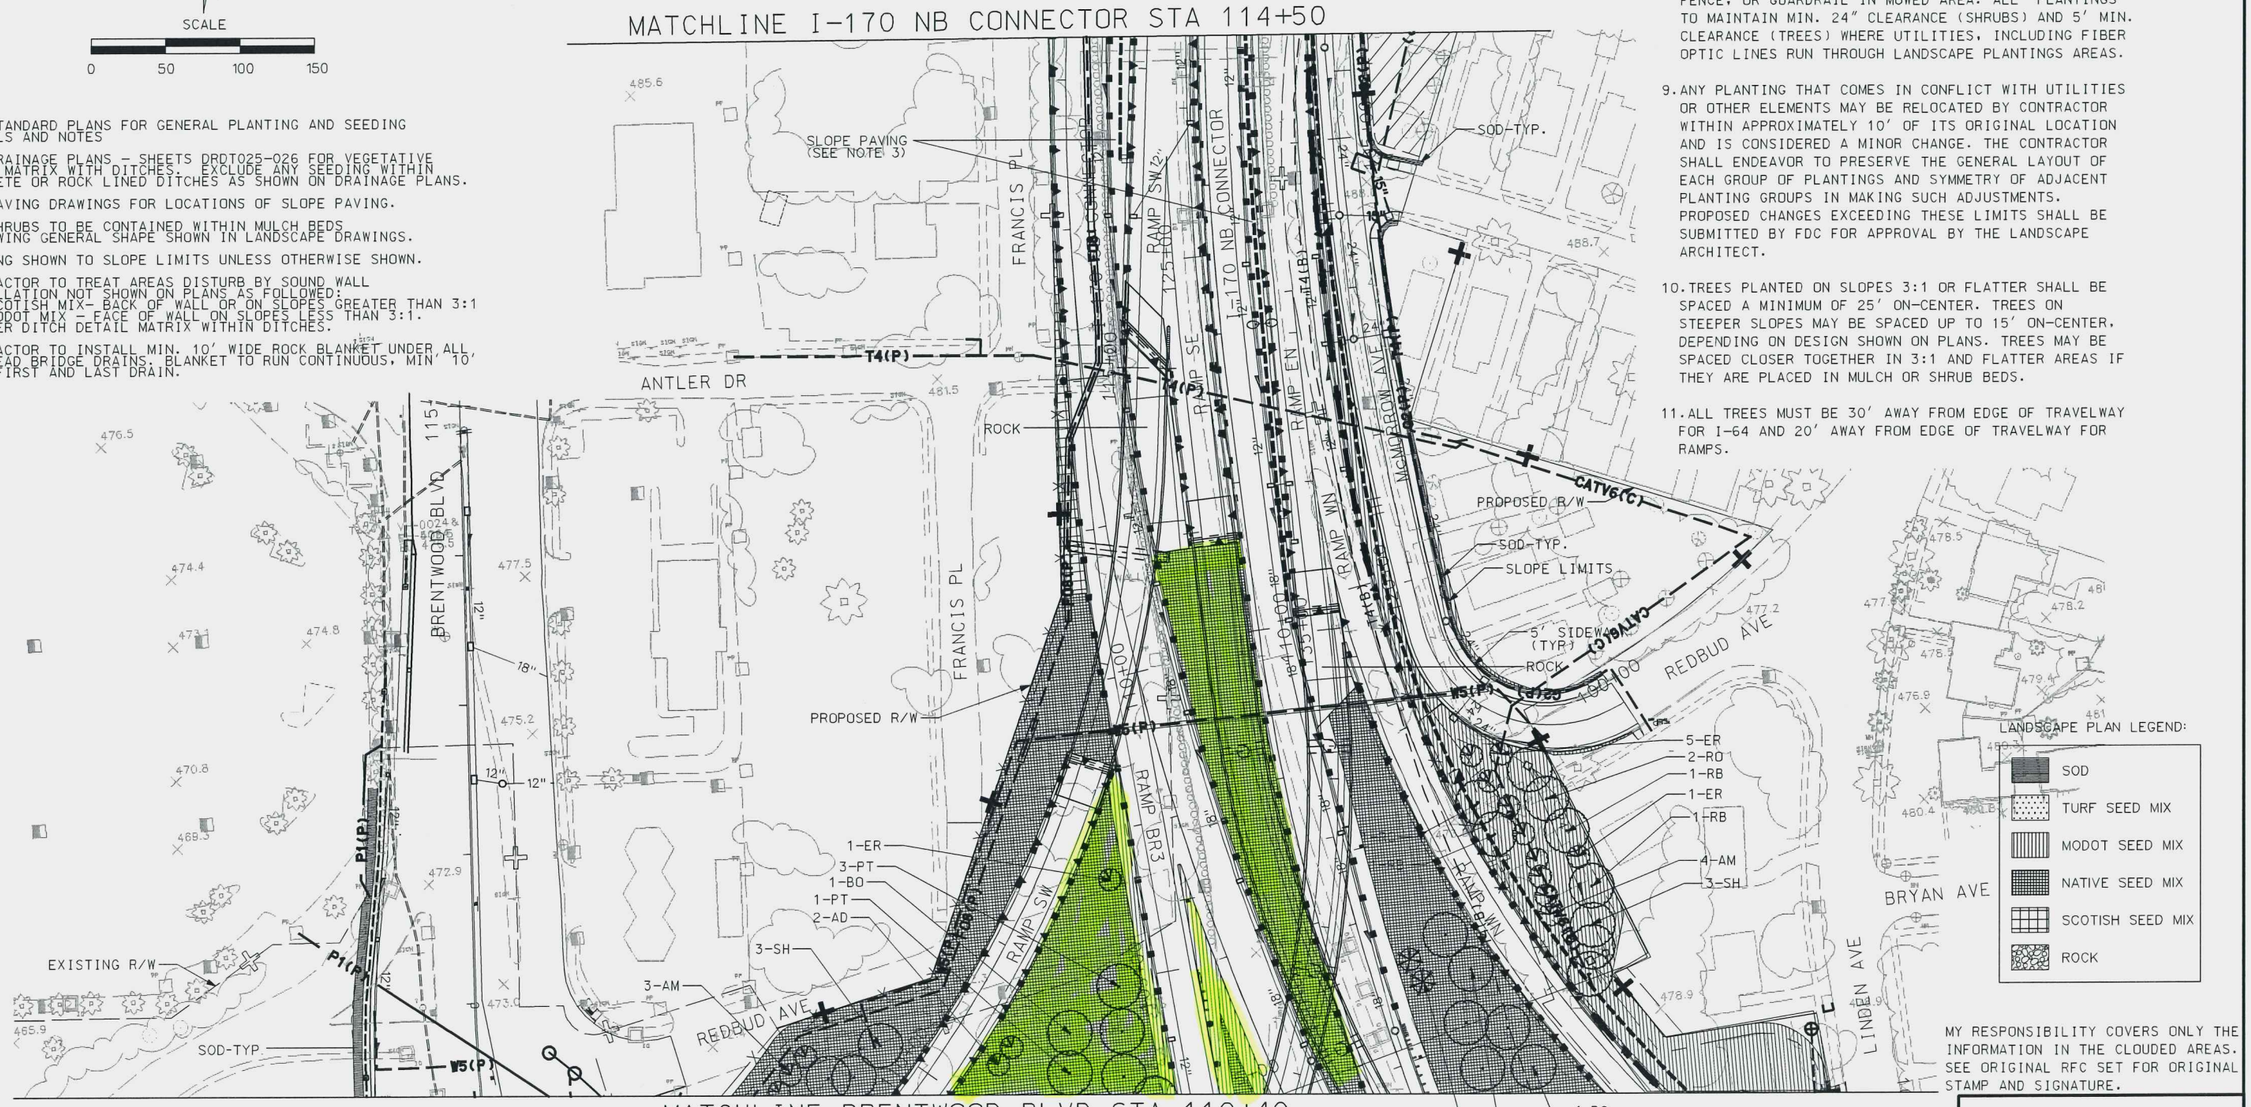

MY RESPONSIBILITY COVERS ONLY THE INFORMATION IN THE CLOUDED AREAS. SEE ORIGINAL RFC SET FOR ORIGINAL STAMP AND SIGNATURE.

DESIGNED BY: DSJ	ISSUE RECORD		
	NO.	DESCRIPTION	DATE
DRAFTED BY: DSJ	B	70% PLAN REVIEW SUBMITTAL	15AUG07
	C	90% FINAL DESIGN	19OCT07
	1	RELEASED FOR CONSTRUCTION	12DEC07
CHECKED BY: JRL	2	RFC FDC 497 ADDITIONAL TREE PLANTINGS	10OCT08
	AB	AS-BUILT FDC-497	11JUN10

PARSONS

Gateway Constructors
Granite • Fred Weber • Millstone Bangert

THE NEW I-64

THE NEW I-64 PROJECT

SEGMENT 2
LANDSCAPE PLAN
I-170 NB CONNECTOR & BRENTWOOD BLVD
STA 110+40 TO STA 114+50

MoDOT

DRAWING NUMBER
LPPL009

AS-BUILT

File Name: C:\EXPORT\ITEMP\009_LPPL_I100_S2.DGN
User: PARSONS
Time Plotted: 12:59:51 PM Date Plotted: 7/16/2010 Pen Table: I-64_HALFSIZEBW-DATE.TBL Plot Driver: 11X17_PDF_AB.PLT

ROUTE	STATE	DISTRICT
I-64	MO	6
JOB NO.	J6I0978	
COUNTY	STLCO/STLCITY	

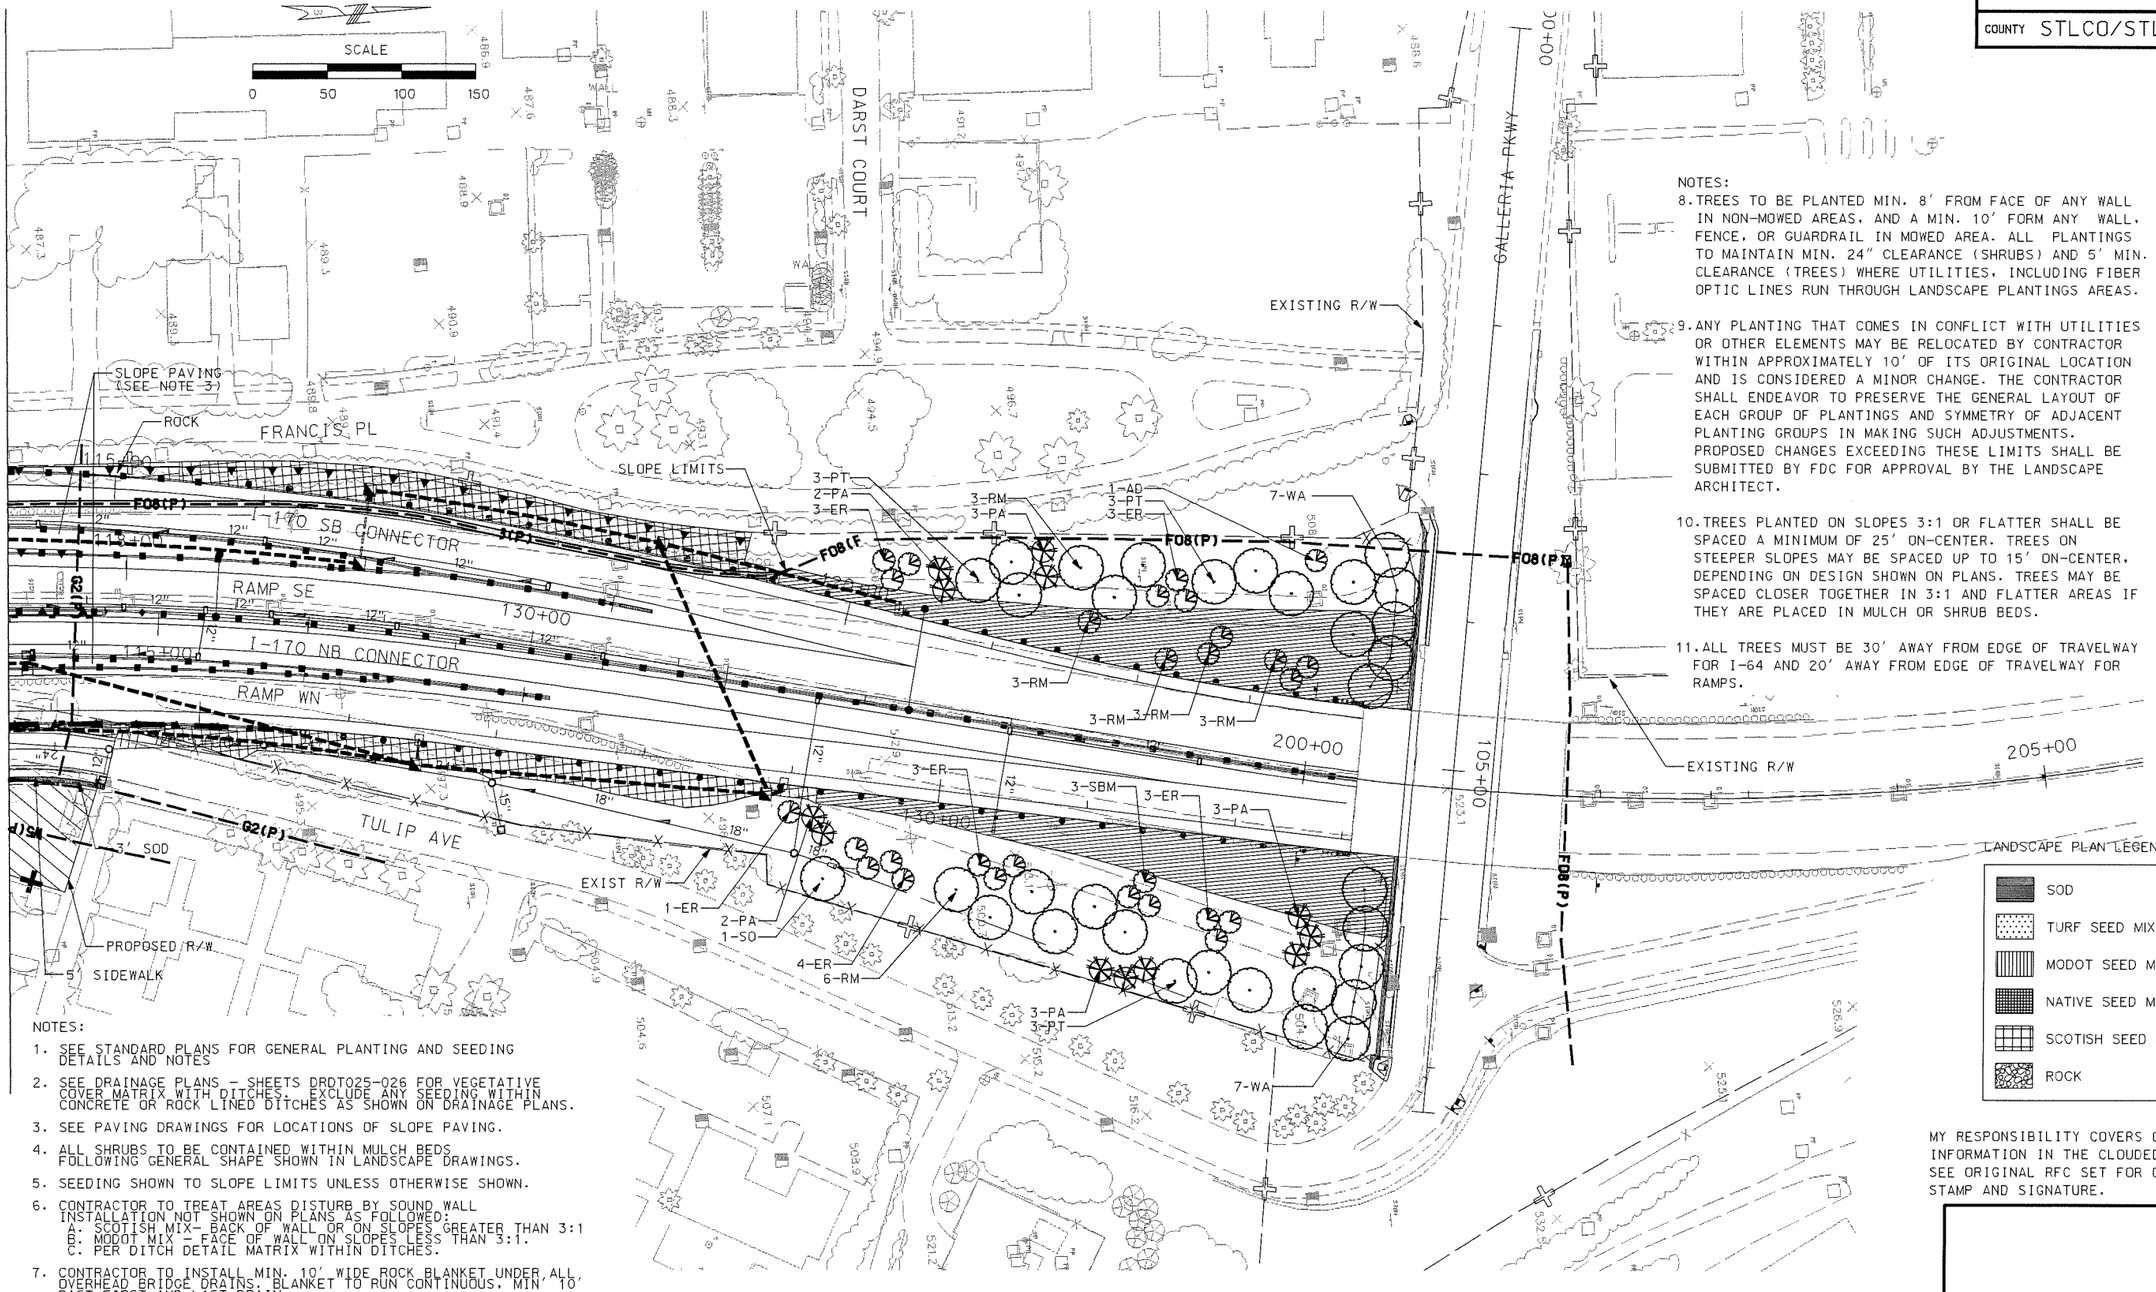

NOTES:

1. SEE STANDARD PLANS FOR GENERAL PLANTING AND SEEDING DETAILS AND NOTES
2. SEE DRAINAGE PLANS - SHEETS DR0T025-026 FOR VEGETATIVE COVER MATRIX WITH DITCHES. EXCLUDE ANY SEEDING WITHIN CONCRETE OR ROCK LINED DITCHES AS SHOWN ON DRAINAGE PLANS.
3. SEE PAVING DRAWINGS FOR LOCATIONS OF SLOPE PAVING.
4. ALL SHRUBS TO BE CONTAINED WITHIN MULCH BEDS FOLLOWING GENERAL SHAPE SHOWN IN LANDSCAPE DRAWINGS.
5. SEEDING SHOWN TO SLOPE LIMITS UNLESS OTHERWISE SHOWN.
6. CONTRACTOR TO TREAT AREAS DISTURB BY SOUND WALL INSTALLATION NOT SHOWN ON PLANS AS FOLLOWED:
   A. SCOTISH MIX- BACK OF WALL OR ON SLOPES GREATER THAN 3:1
   B. MODOT MIX - FACE OF WALL ON SLOPES LESS THAN 3:1.
   C. PER DITCH DETAIL MATRIX WITHIN DITCHES.
7. CONTRACTOR TO INSTALL MIN. 10' WIDE ROCK BLANKET UNDER ALL OVERHEAD BRIDGE DRAINS. BLANKET TO RUN CONTINUOUS. MIN' 10' PAST FIRST AND LAST DRAIN.

NOTES:

8. TREES TO BE PLANTED MIN. 8' FROM FACE OF ANY WALL IN NON-MOWED AREAS. AND A MIN. 10' FORM ANY WALL. FENCE, OR GUARDRAIL IN MOWED AREA. ALL PLANTINGS TO MAINTAIN MIN. 24" CLEARANCE (SHRUBS) AND 5' MIN. CLEARANCE (TREES) WHERE UTILITIES, INCLUDING FIBER OPTIC LINES RUN THROUGH LANDSCAPE PLANTINGS AREAS.
9. ANY PLANTING THAT COMES IN CONFLICT WITH UTILITIES OR OTHER ELEMENTS MAY BE RELOCATED BY CONTRACTOR WITHIN APPROXIMATELY 10' OF ITS ORIGINAL LOCATION AND IS CONSIDERED A MINOR CHANGE. THE CONTRACTOR SHALL ENDEAVOR TO PRESERVE THE GENERAL LAYOUT OF EACH GROUP OF PLANTINGS AND SYMMETRY OF ADJACENT PLANTING GROUPS IN MAKING SUCH ADJUSTMENTS. PROPOSED CHANGES EXCEEDING THESE LIMITS SHALL BE SUBMITTED BY FDC FOR APPROVAL BY THE LANDSCAPE ARCHITECT.
10. TREES PLANTED ON SLOPES 3:1 OR FLATTER SHALL BE SPACED A MINIMUM OF 25' ON-CENTER. TREES ON STEEPER SLOPES MAY BE SPACED UP TO 15' ON-CENTER, DEPENDING ON DESIGN SHOWN ON PLANS. TREES MAY BE SPACED CLOSER TOGETHER IN 3:1 AND FLATTER AREAS IF THEY ARE PLACED IN MULCH OR SHRUB BEDS.
11. ALL TREES MUST BE 30' AWAY FROM EDGE OF TRAVELWAY FOR I-64 AND 20' AWAY FROM EDGE OF TRAVELWAY FOR RAMPS.

LANDSCAPE PLAN LEGEND:

- SOD
- TURF SEED MIX
- MODOT SEED MIX
- NATIVE SEED MIX
- SCOTISH SEED MIX
- ROCK

MY RESPONSIBILITY COVERS ONLY THE INFORMATION IN THE CLOUDED AREAS. SEE ORIGINAL RFC SET FOR ORIGINAL STAMP AND SIGNATURE.

DESIGNED BY: DSJ	ISSUE RECORD		
	NO.	DESCRIPTION	DATE
DRAFTED BY: DSJ	B	70% PLAN REVIEW SUBMITTAL	15AUG07
	C	90% FINAL DESIGN	19OCT07
	1	RELEASED FOR CONSTRUCTION	12DEC07
CHECKED BY: JRL	2	RFC FDC 497 ADDITIONAL TREE PLANTINGS	10OCT08
	AB	AS-BUILT FDC-497	11JUN10

PARSONS

Gateway Constructors
Granite • Fred Weber • Millstone Bangert

THE NEW I-64

THE NEW I-64 PROJECT
SEGMENT 2
LANDSCAPE PLAN
I-170 NB CONNECTOR AND I-170
STA 114+50 TO STA 200+35

MoDOT

DRAWING NUMBER
LPPL010

AS-BUILT

File Name: C:\EXPORT\ITEMP\010_LPPL_I100_S2.DGN
User: PARSONS
Time Plotted: 1:00:05 PM
Date Plotted: 7/16/2010
Pen Table: I-64_HALFSIZEBW-DATE.TBL
Plot Driver: 11X17_PDF_AB.PLT

ROUTE	STATE	DISTRICT
I-64	MO	6
JOB NO.	J6I0978	
COUNTY	STLCO/STLCITY	

NOTES:

8. TREES TO BE PLANTED MIN. 8' FROM FACE OF ANY WALL IN NON-MOWED AREAS, AND A MIN. 10' FORM ANY WALL, FENCE, OR GUARDRAIL IN MOWED AREA. ALL PLANTINGS TO MAINTAIN MIN. 24" CLEARANCE (SHRUBS) AND 5' MIN. CLEARANCE (TREES) WHERE UTILITIES, INCLUDING FIBER OPTIC LINES RUN THROUGH LANDSCAPE PLANTINGS AREAS.

9. ANY PLANTING THAT COMES IN CONFLICT WITH UTILITIES OR OTHER ELEMENTS MAY BE RELOCATED BY CONTRACTOR WITHIN APPROXIMATELY 10' OF ITS ORIGINAL LOCATION AND IS CONSIDERED A MINOR CHANGE. THE CONTRACTOR SHALL ENDEAVOR TO PRESERVE THE GENERAL LAYOUT OF EACH GROUP OF PLANTINGS AND SYMMETRY OF ADJACENT PLANTING GROUPS IN MAKING SUCH ADJUSTMENTS. PROPOSED CHANGES EXCEEDING THESE LIMITS SHALL BE SUBMITTED BY FDC FOR APPROVAL BY THE LANDSCAPE ARCHITECT.

10. TREES PLANTED ON SLOPES 3:1 OR FLATTER SHALL BE SPACED A MINIMUM OF 25' ON-CENTER. TREES ON STEEPER SLOPES MAY BE SPACED UP TO 15' ON-CENTER, DEPENDING ON DESIGN SHOWN ON PLANS. TREES MAY BE SPACED CLOSER TOGETHER IN 3:1 AND FLATTER AREAS IF THEY ARE PLACED IN MULCH OR SHRUB BEDS.

11. ALL TREES MUST BE 30' AWAY FROM EDGE OF TRAVELWAY FOR I-64 AND 20' AWAY FROM EDGE OF TRAVELWAY FOR RAMPS.

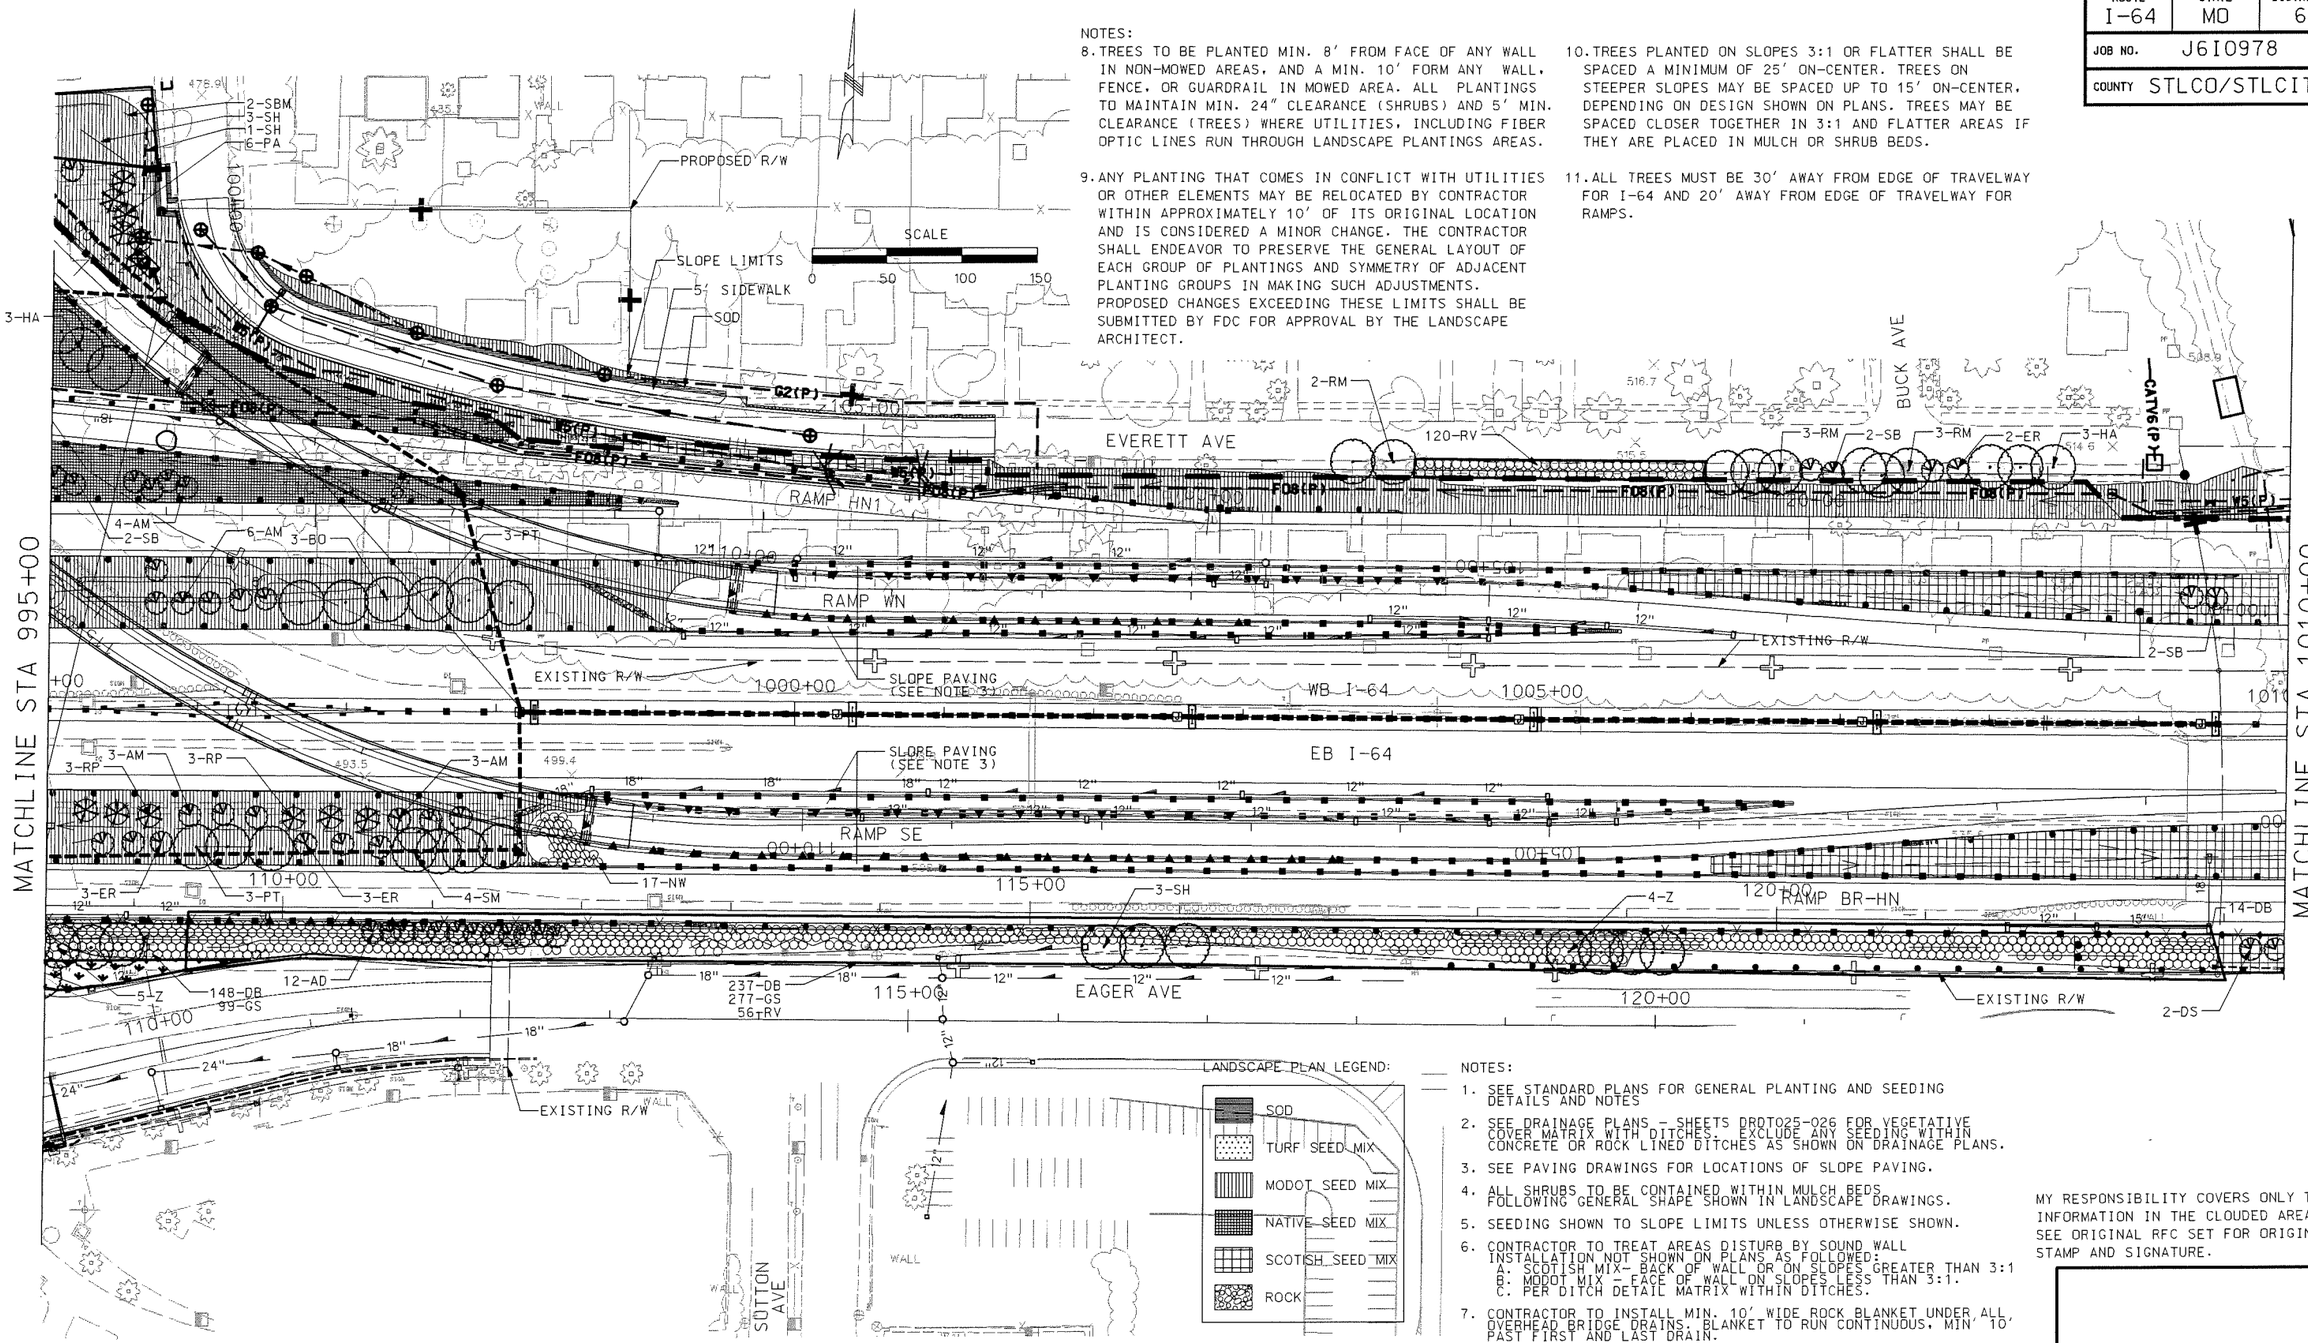

LANDSCAPE PLAN LEGEND:

- SOD
- TURF SEED MIX
- MODOT SEED MIX
- NATIVE SEED MIX
- SCOTTISH SEED MIX
- ROCK

NOTES:

1. SEE STANDARD PLANS FOR GENERAL PLANTING AND SEEDING DETAILS AND NOTES
2. SEE DRAINAGE PLANS - SHEETS DR0T025-026 FOR VEGETATIVE COVER MATRIX WITH DITCHES. EXCLUDE ANY SEEDING WITHIN CONCRETE OR ROCK LINED DITCHES AS SHOWN ON DRAINAGE PLANS.
3. SEE PAVING DRAWINGS FOR LOCATIONS OF SLOPE PAVING.
4. ALL SHRUBS TO BE CONTAINED WITHIN MULCH BEDS FOLLOWING GENERAL SHAPE SHOWN IN LANDSCAPE DRAWINGS.
5. SEEDING SHOWN TO SLOPE LIMITS UNLESS OTHERWISE SHOWN.
6. CONTRACTOR TO TREAT AREAS DISTURB BY SOUND WALL INSTALLATION NOT SHOWN ON PLANS AS FOLLOWED:
   A. SCOTTISH MIX- BACK OF WALL OR ON SLOPES GREATER THAN 3:1
   B. MODOT MIX - FACE OF WALL ON SLOPES LESS THAN 3:1.
   C. PER DITCH DETAIL MATRIX WITHIN DITCHES.
7. CONTRACTOR TO INSTALL MIN. 10' WIDE ROCK BLANKET UNDER ALL OVERHEAD BRIDGE DRAINS. BLANKET TO RUN CONTINUOUS, MIN' 10' PAST FIRST AND LAST DRAIN.

MY RESPONSIBILITY COVERS ONLY THE INFORMATION IN THE CLOUDED AREAS. SEE ORIGINAL RFC SET FOR ORIGINAL STAMP AND SIGNATURE.

AS-BUILT

DESIGNED BY: DSJ	ISSUE RECORD		
	NO.	DESCRIPTION	DATE
DRAFTED BY: DSJ	B	70% PLAN REVIEW SUBMITTAL	15AUG07
	C	90% FINAL DESIGN	19OCT07
	1	RELEASED FOR CONSTRUCTION	12DEC07
CHECKED BY: JRL	2	RFC FDC 497 ADDITIONAL TREE PLANTINGS	10OCT08
	AB	AS-BUILT FDC-497	11JUN10

PARSONS

Gateway Constructors
Granite • Fred Weber • Millstone Bangert

THE NEW I-64

THE NEW I-64 PROJECT
SEGMENT 2
LANDSCAPE PLAN
I-64
STA 995+00 TO STA 1010+00

MoDOT

DRAWING NUMBER
LPPL011

File Name: C:\EXPORT\ITEMP\011_LPPL_I100_S2.DGN
User: PARSONS
Time Plotted: 1:00:20 PM
Date Plotted: 7/16/2010
Pen Table: I-64_HALFSIZEBW-DATE.TBL
Plot Driver: 11X17_PDF_AB.PLT

ROUTE	STATE	DISTRICT
I-64	MO	6
JOB NO.	J6I0978	
COUNTY	STLCO/STLCITY	

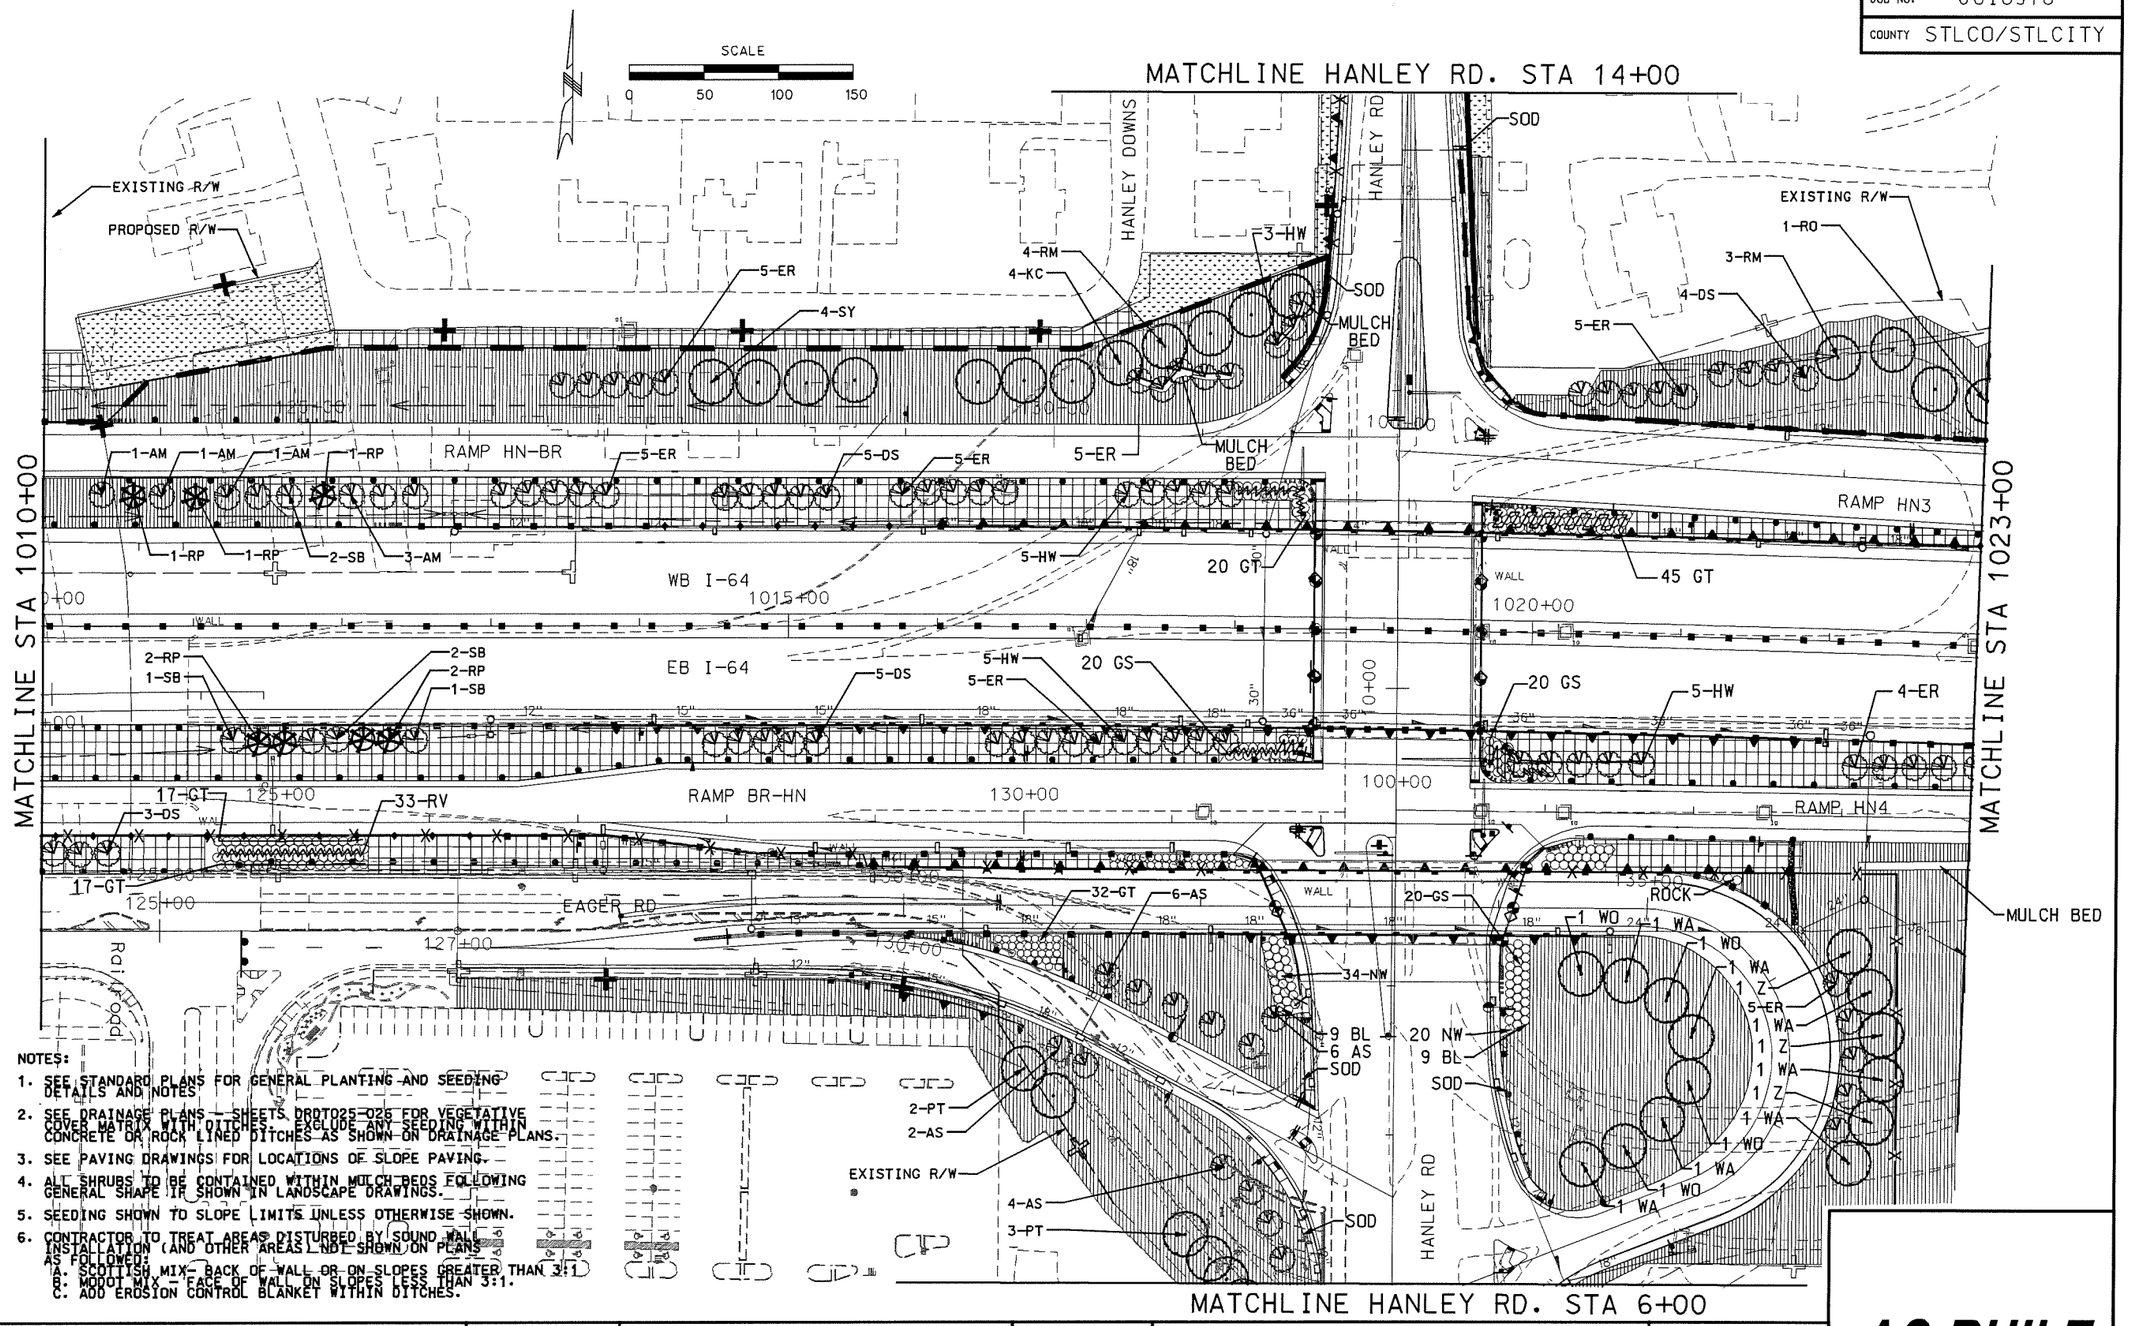

NOTES:

1. SEE STANDARD PLANS FOR GENERAL PLANTING AND SEEDING DETAILS AND NOTES.
2. SEE DRAINAGE PLANS -- SHEETS DR0T025-026 FOR VEGETATIVE COVER MATRIX WITH OTHER EXCLUDE MY SEEDING WITHIN CONCRETE OR ROCK LINED DITCHES AS SHOWN ON DRAINAGE PLANS.
3. SEE PAVING DRAWINGS FOR LOCATIONS OF SLOPE PAVING.
4. ALL SHRUBS TO BE CONTAINED WITHIN MULCH BEDS FOLLOWING GENERAL SHAPE IF SHOWN IN LANDSCAPE DRAWINGS.
5. SEEDING SHOWN TO SLOPE LIMITS UNLESS OTHERWISE SHOWN.
6. CONTRACTOR TO TREAT AREAS DISTURBED BY SOUND WALL INSTALLATION (AND OTHER AREAS NOT SHOWN ON PLANS AS FOLLOWS:
   A. SCOTTISH MIX - BACK OF WALL OR ON SLOPES GREATER THAN 3:1
   B. MODOT MIX - FACE OF WALL ON SLOPES LESS THAN 3:1.
   C. ADD EROSION CONTROL BLANKET WITHIN DITCHES.

DESIGNED BY:	ISSUE RECORD		
	NO.	DESCRIPTION	DATE
DRAFTED BY:	C	90% FINAL DESIGN	19OCT07
	1	RELEASED FOR CONSTRUCTION	12DEC07
	D	HANLEY JUG HANDLE 90% FINAL DESIGN	28JAN08
CHECKED BY:	2	RELEASED FOR CONSTRUCTION	22FEB08
	AB	AS-BUILT	11JUN10

PARSONS

Gateway Constructors
Granite • Fred Weber • Millstone Bangert

THE NEW I-64

THE NEW I-64 PROJECT
SEGMENT 2
LANDSCAPE PLAN
I-64
STA 1010+00 TO STA 1023+00

MoDOT

DRAWING NUMBER
LPPL012

AS-BUILT

File Name: C:\EXPORT\ITEMP\012_LPPL_I100_S2.DGN
User: PARSONS
Time Plotted: 3:15:39 PM
Date Plotted: 7/30/2010
Pen Table: I-64_HALFSIZEBW-DATE.TBL
Plot Driver: 11X17_PDF_AB.PLT

ROUTE	STATE	DISTRICT
I-64	MO	6
JOB NO.	J6I0978	
COUNTY	STLCO/STLCITY	

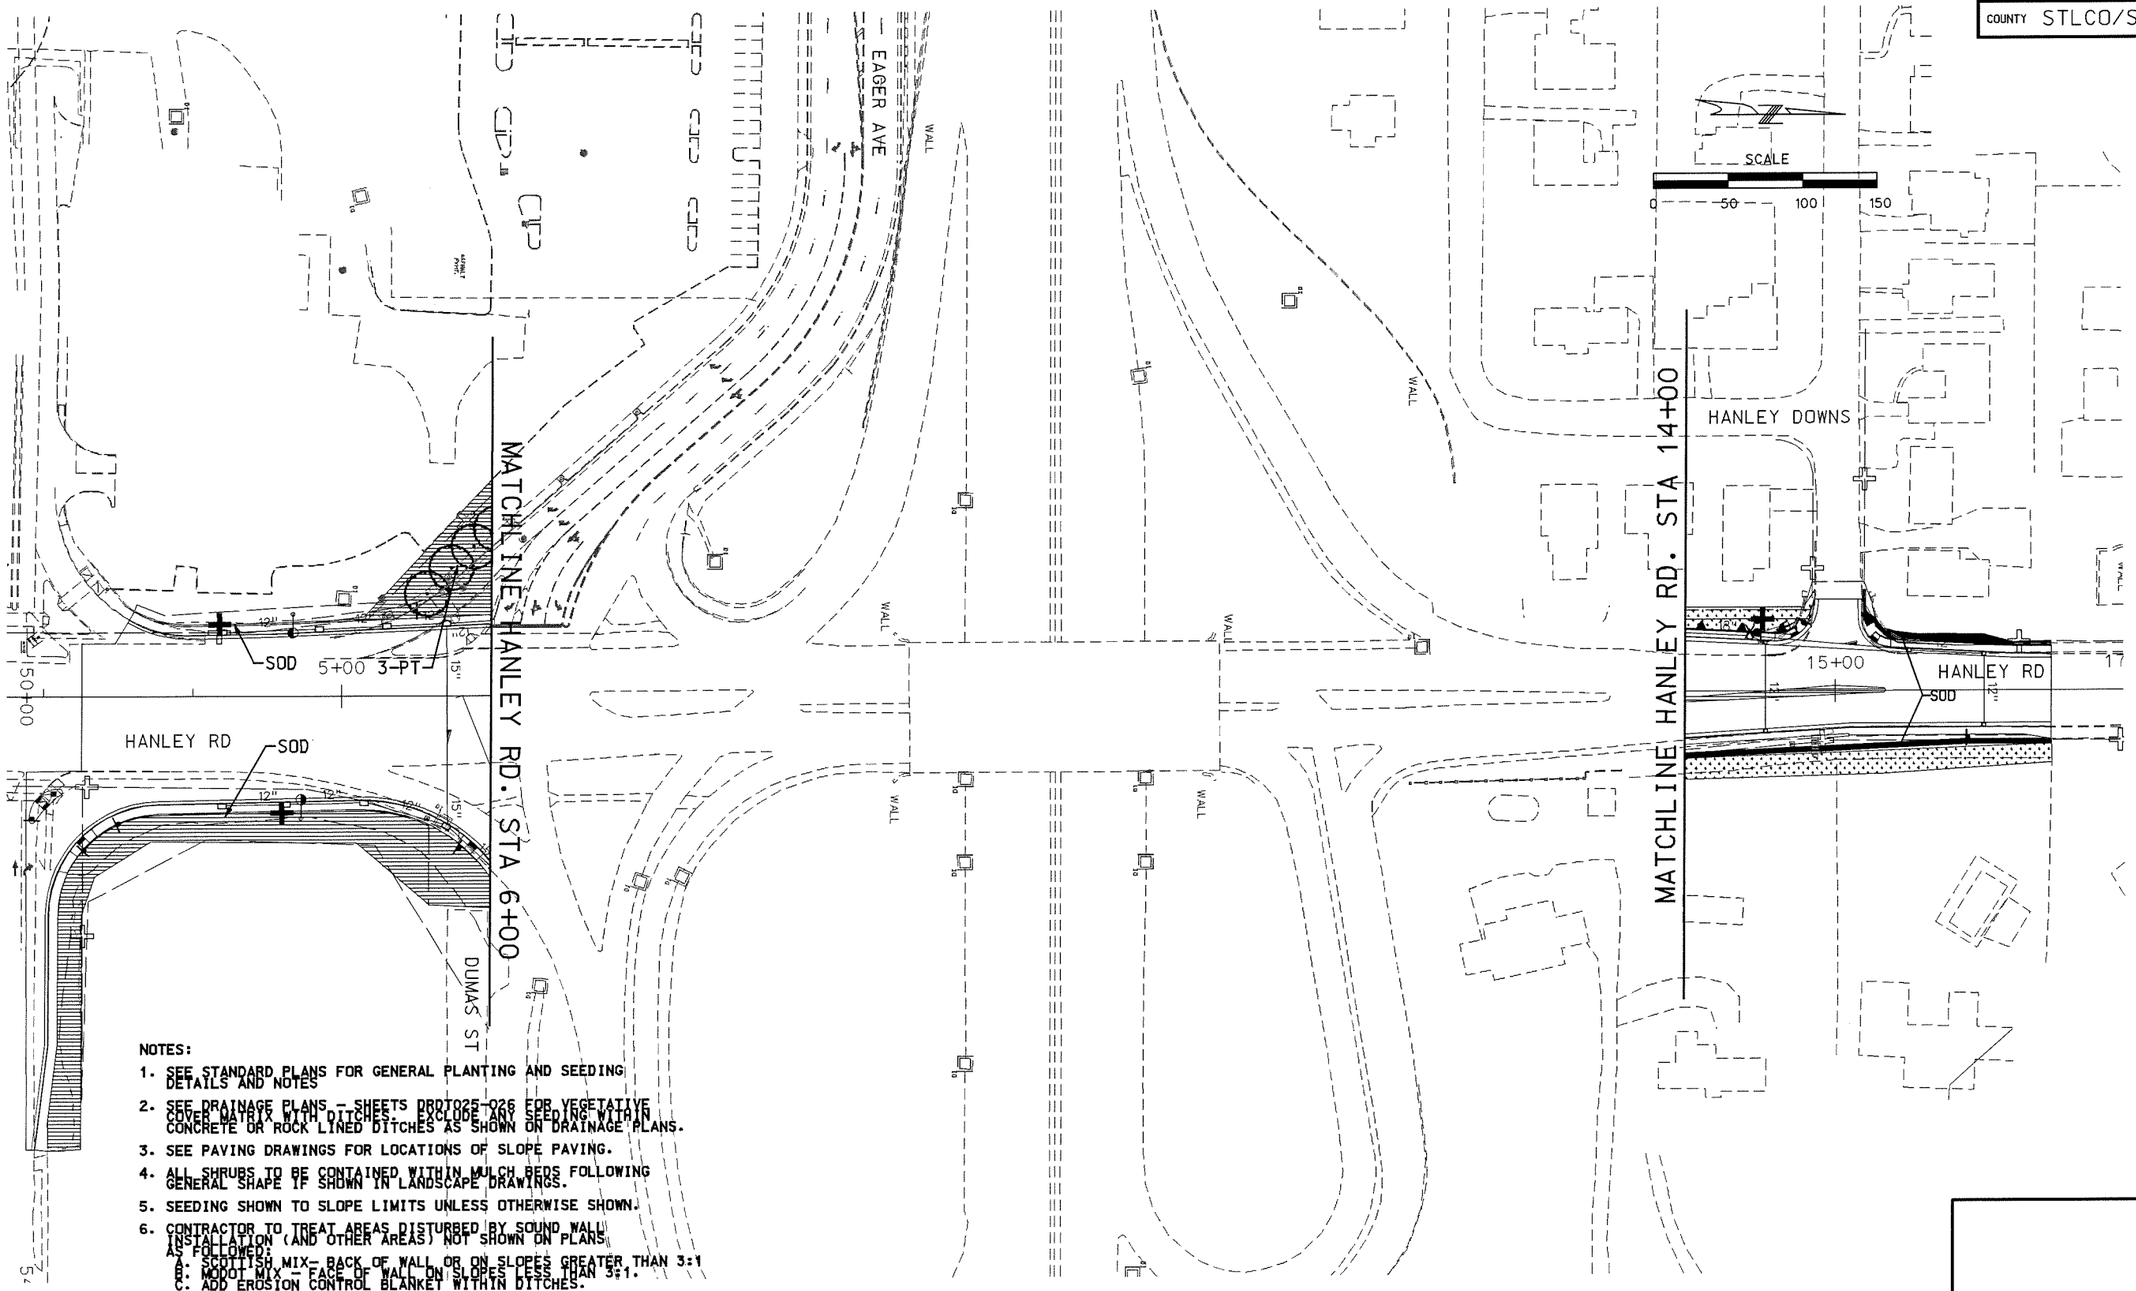

NOTES:

1. SEE STANDARD PLANS FOR GENERAL PLANTING AND SEEDING DETAILS AND NOTES
2. SEE DRAINAGE PLANS - SHEETS DRDT025-026 FOR VEGETATIVE COVER MATRIX WITH DITCHES. EXCLUDE ANY SEEDING WITHIN CONCRETE OR ROCK LINED DITCHES AS SHOWN ON DRAINAGE PLANS.
3. SEE PAVING DRAWINGS FOR LOCATIONS OF SLOPE PAVING.
4. ALL SHRUBS TO BE CONTAINED WITHIN MULCH BEDS FOLLOWING GENERAL SHAPE IF SHOWN IN LANDSCAPE DRAWINGS.
5. SEEDING SHOWN TO SLOPE LIMITS UNLESS OTHERWISE SHOWN.
6. CONTRACTOR TO TREAT AREAS DISTURBED BY SOUND WALL INSTALLATION (AND OTHER AREAS) NOT SHOWN ON PLANS AS FOLLOWED:
   A. SCOTTISH MIX- BACK OF WALL OR ON SLOPES GREATER THAN 3:1
   B. MODOT MIX - FACE OF WALL ON SLOPES LESS THAN 3:1.
   C. ADD EROSION CONTROL BLANKET WITHIN DITCHES.

DESIGNED BY:	ISSUE RECORD		
	NO.	DESCRIPTION	DATE
DRAFTED BY:	C	90% FINAL DESIGN	19OCT07
	1	RELEASED FOR CONSTRUCTION	12DEC07
	D	HANLEY JUG HANDLE 90% FINAL DESIGN	28JAN07
CHECKED BY:	2	RELEASED FOR CONSTRUCTION	22FEB07
	AB	AS-BUILT	11JUN10

PARSONS

Gateway Constructors
Granite • Fred Weber • Millstone Bangert

THE NEW I-64

THE NEW I-64 PROJECT
SEGMENT 2
LANDSCAPE PLAN
HANLEY ROAD
BEGINNING TO END

MoDOT

DRAWING NUMBER
LPPL013

AS-BUILT

File Name: C:\EXPORT\TEMP\013_LPPL_1100_S2.DGN
User: PARSONS
Time Plotted: 1:00:56 PM
Date Plotted: 7/16/2010
Pen Table: I-64_HALFSIZEBW-DATE.TBLPlot Driver: 11X17_PDF_AB.PLT

ROUTE	STATE	DISTRICT
I-64	MO	6
JOB NO.	J6I0978	
COUNTY	STLCO/STLCITY	

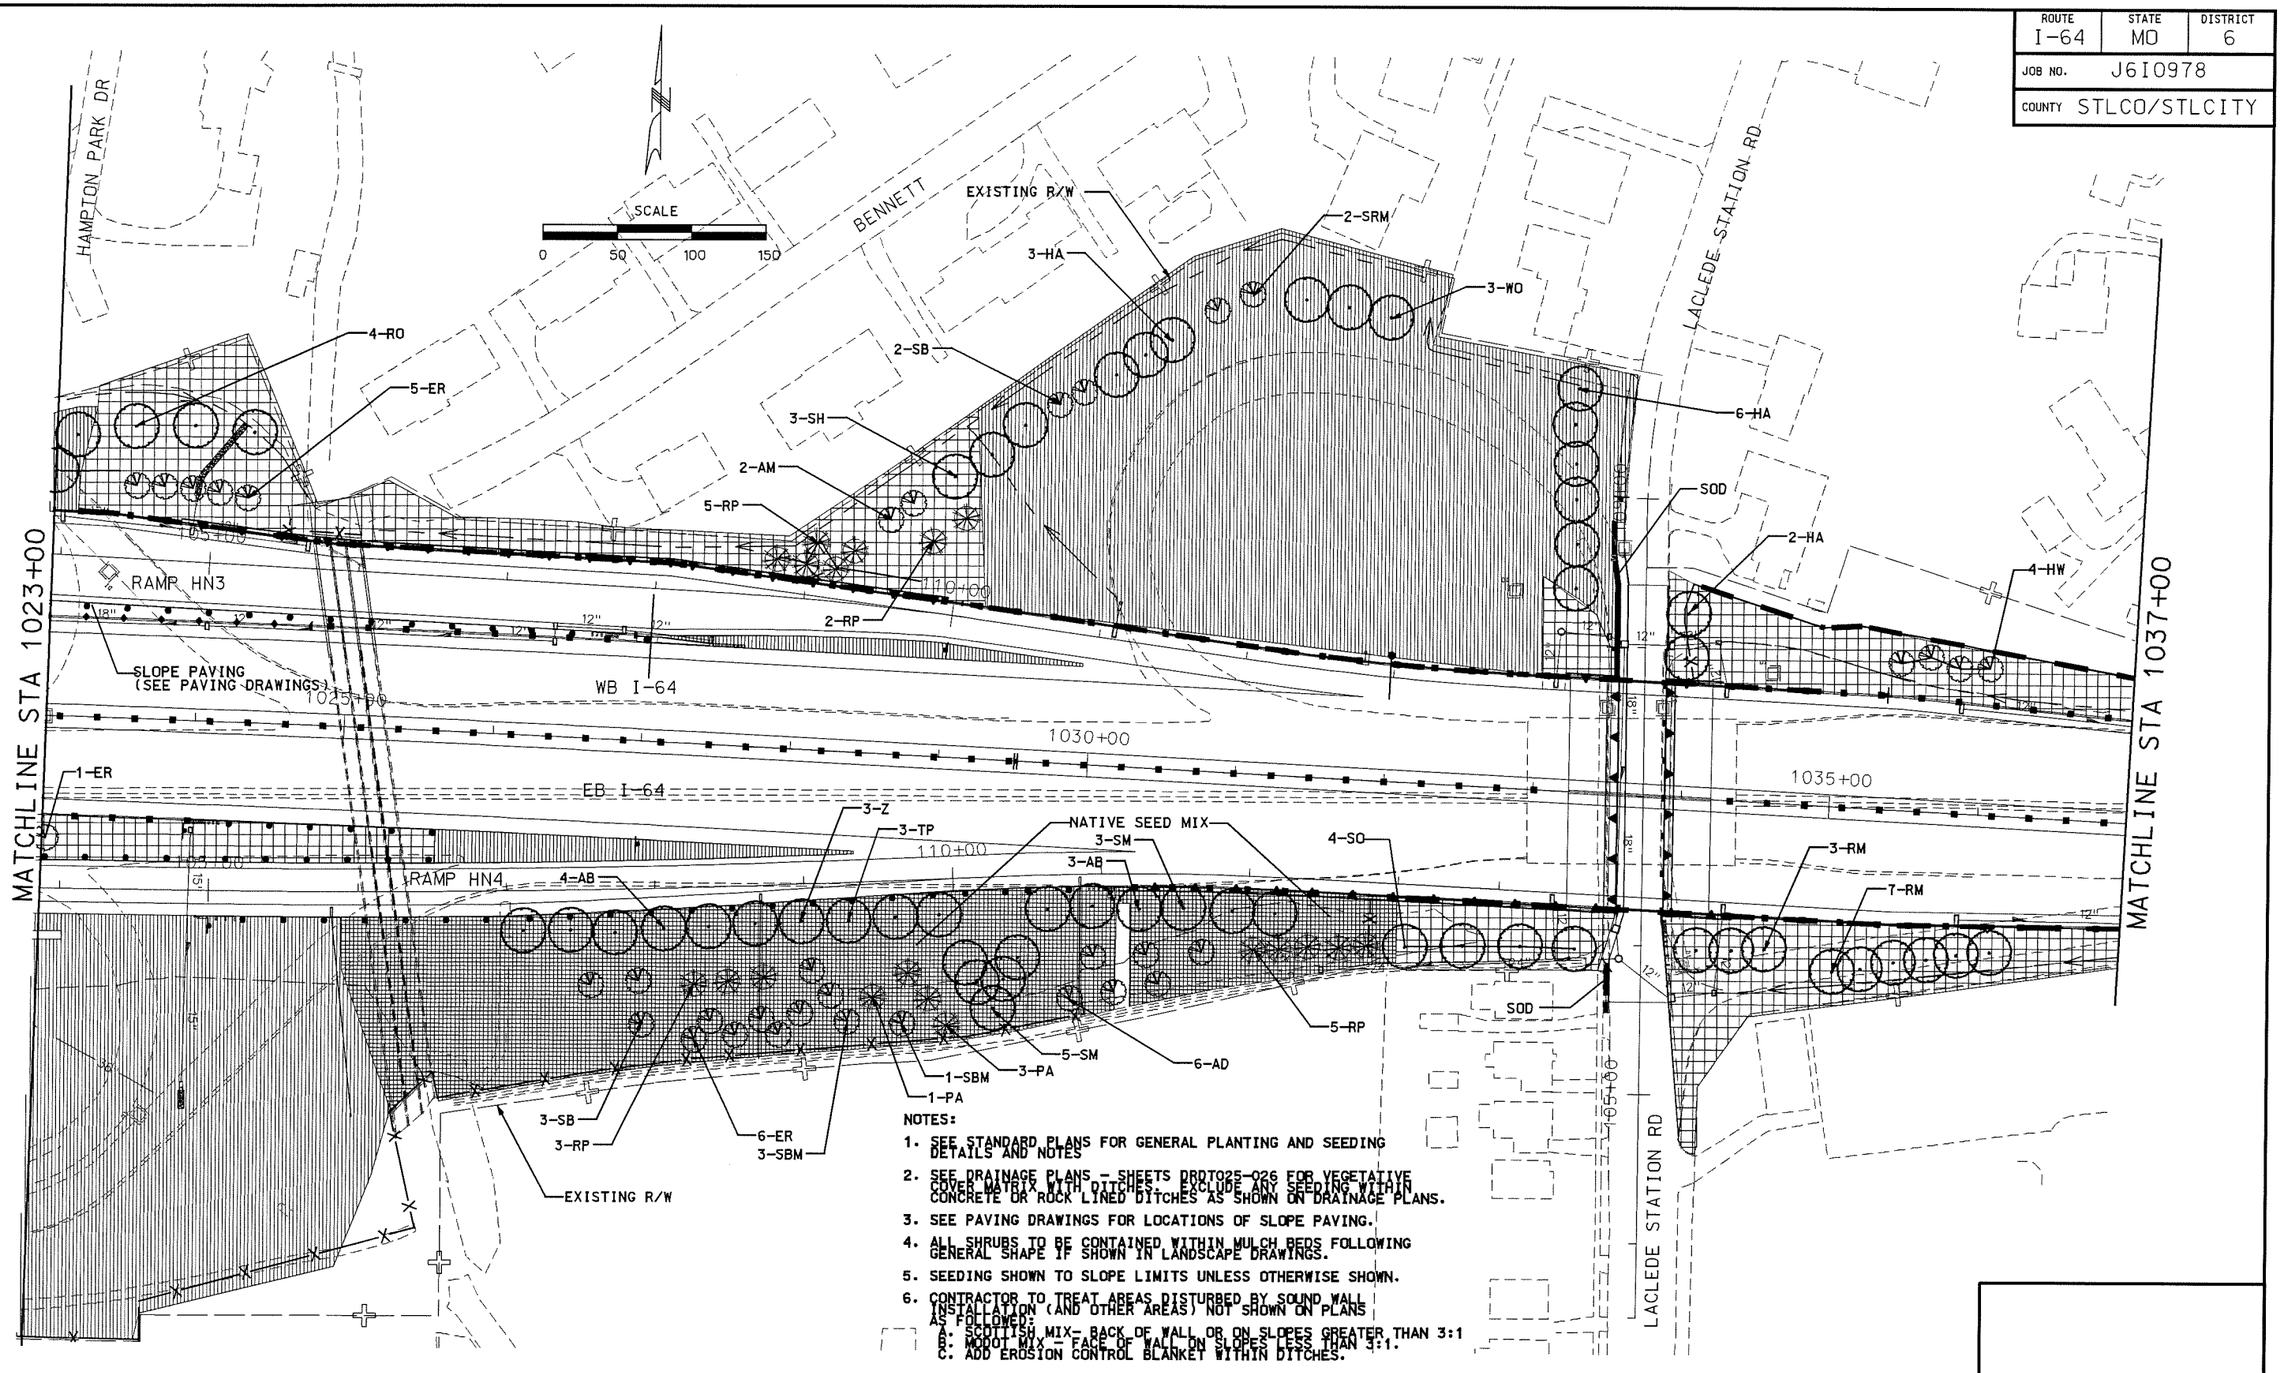

NOTES:

1. SEE STANDARD PLANS FOR GENERAL PLANTING AND SEEDING DETAILS AND NOTES
2. SEE DRAINAGE PLANS - SHEETS DR0T025-026 FOR VEGETATIVE COVER MATRIX WITH DITCHES. EXCLUDE ANY SEEDING WITHIN CONCRETE OR ROCK LINED DITCHES AS SHOWN ON DRAINAGE PLANS.
3. SEE PAVING DRAWINGS FOR LOCATIONS OF SLOPE PAVING.
4. ALL SHRUBS TO BE CONTAINED WITHIN MULCH BEDS FOLLOWING GENERAL SHAPE IF SHOWN IN LANDSCAPE DRAWINGS.
5. SEEDING SHOWN TO SLOPE LIMITS UNLESS OTHERWISE SHOWN.
6. CONTRACTOR TO TREAT AREAS DISTURBED BY SOUND WALL INSTALLATION (AND OTHER AREAS) NOT SHOWN ON PLANS AS FOLLOWS:
   A. SCOTTISH MIX- BACK OF WALL OR ON SLOPES GREATER THAN 3:1
   B. MODOT MIX - FACE OF WALL ON SLOPES LESS THAN 3:1.
   C. ADD EROSION CONTROL BLANKET WITHIN DITCHES.

DESIGNED BY:	AT
DRAFTED BY:	BQ
CHECKED BY:	JC

ISSUE RECORD

NO.	DESCRIPTION	DATE
C	90% FINAL DESIGN	19OCT07
1	RELEASED FOR CONSTRUCTION	12DEC07
D	HANLEY JUG HANDLE 90% FINAL DESIGN	28JAN08
2	RELEASED FOR CONSTRUCTION	22FEB08
AB	AS-BUILT	11JUN10

PARSONS

Gateway Constructors
Granite • Fred Weber • Millstone Bangert

THE NEW I-64

THE NEW I-64 PROJECT
SEGMENT 2
LANDSCAPE PLAN
I-64
STA 1023+00 TO STA 1037+00

MoDOT

DRAWING NUMBER
LPPL014

AS-BUILT

File Name: C:\EXPORT\ITEMP\014_LPPL_I100_S2.DGN
User: PARSONS
Time Plotted: 1:01:03 PM
Date Plotted: 7/16/2010
Pen Table: I-64_HALFSIZEBW-DATE.TBL
Plot Driver: 11X17_PDF_AB.PLT

ROUTE	STATE	DISTRICT
I-64	MO	6
JOB NO.	J6I0978	
COUNTY	STLCO/STLCITY	

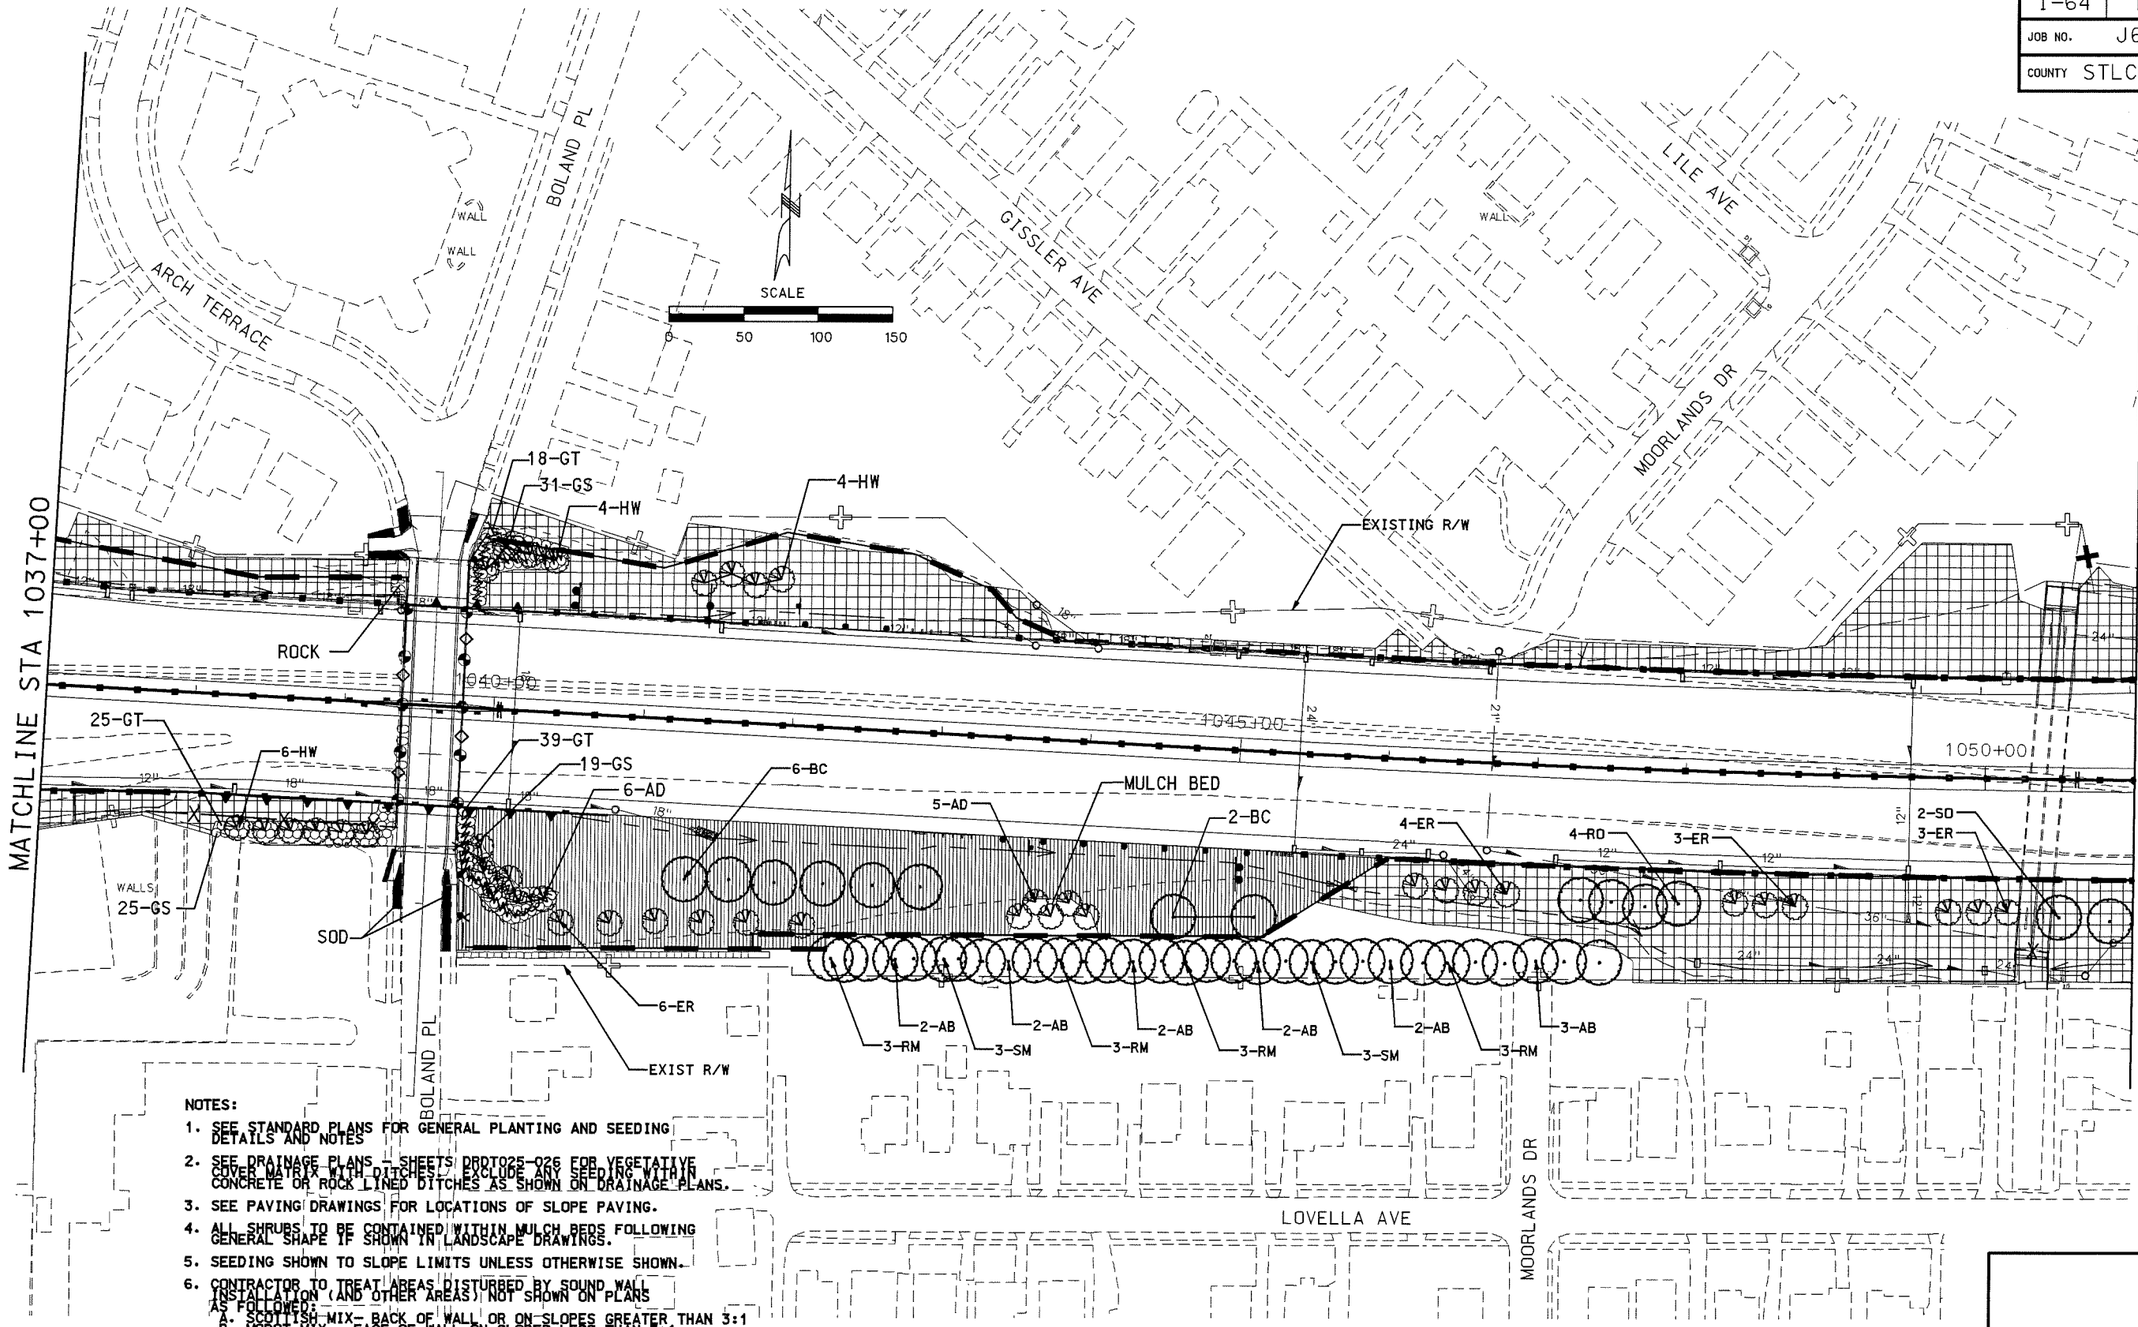

NOTES:

1. SEE STANDARD PLANS FOR GENERAL PLANTING AND SEEDING DETAILS AND NOTES
2. SEE DRAINAGE PLANS -- SHEETS DRDT025-026 FOR VEGETATIVE COVER MATRIX WITH DITCHES. EXCLUDE ANY SEEDING WITHIN CONCRETE OR ROCK LINED DITCHES AS SHOWN ON DRAINAGE PLANS.
3. SEE PAVING DRAWINGS FOR LOCATIONS OF SLOPE PAVING.
4. ALL SHRUBS TO BE CONTAINED WITHIN MULCH BEDS FOLLOWING GENERAL SHAPE IF SHOWN IN LANDSCAPE DRAWINGS.
5. SEEDING SHOWN TO SLOPE LIMITS UNLESS OTHERWISE SHOWN.
6. CONTRACTOR TO TREAT AREAS DISTURBED BY SOUND WALL INSTALLATION (AND OTHER AREAS) NOT SHOWN ON PLANS AS FOLLOWED:
   A. SCOTTISH MIX- BACK OF WALL OR ON SLOPES GREATER THAN 3:1
   B. MODOT MIX - FACE OF WALL ON SLOPES LESS THAN 3:1.
   C. ADD EROSION CONTROL BLANKET WITHIN DITCHES.

DESIGNED BY:	DRAFTED BY:	CHECKED BY:

ISSUE RECORD

NO.	DESCRIPTION	DATE
A	50% PLAN REVIEW SUBMITTAL	08JUN07
B	70% PLAN REVIEW SUBMITTAL	15AUG07
C	90% FINAL DESIGN	19OCT07
1	RELEASED FOR CONSTRUCION	12DEC07
AB	AS-BUILT	11JUN10

PARSONS

Gateway Constructors
Granite • Fred Weber • Millstone Bangert

THE NEW I-64

THE NEW I-64 PROJECT
SEGMENT 2
LANDSCAPE PLAN
I-64
STA 1037+00 TO STA 1051+00

MoDOT

DRAWING NUMBER
LPPL015

AS-BUILT

File Name: C:\EXPORT\ITEMP\015_LPPL_I100_S2.DGN
User: PARSONS
Time Plotted: 1:01:12 PM
Date Plotted: 7/16/2010
Pen Table: I-64_HALFSIZEBW-DATE_TBUPlot Driver: 11X17_PDF_AB.PLT

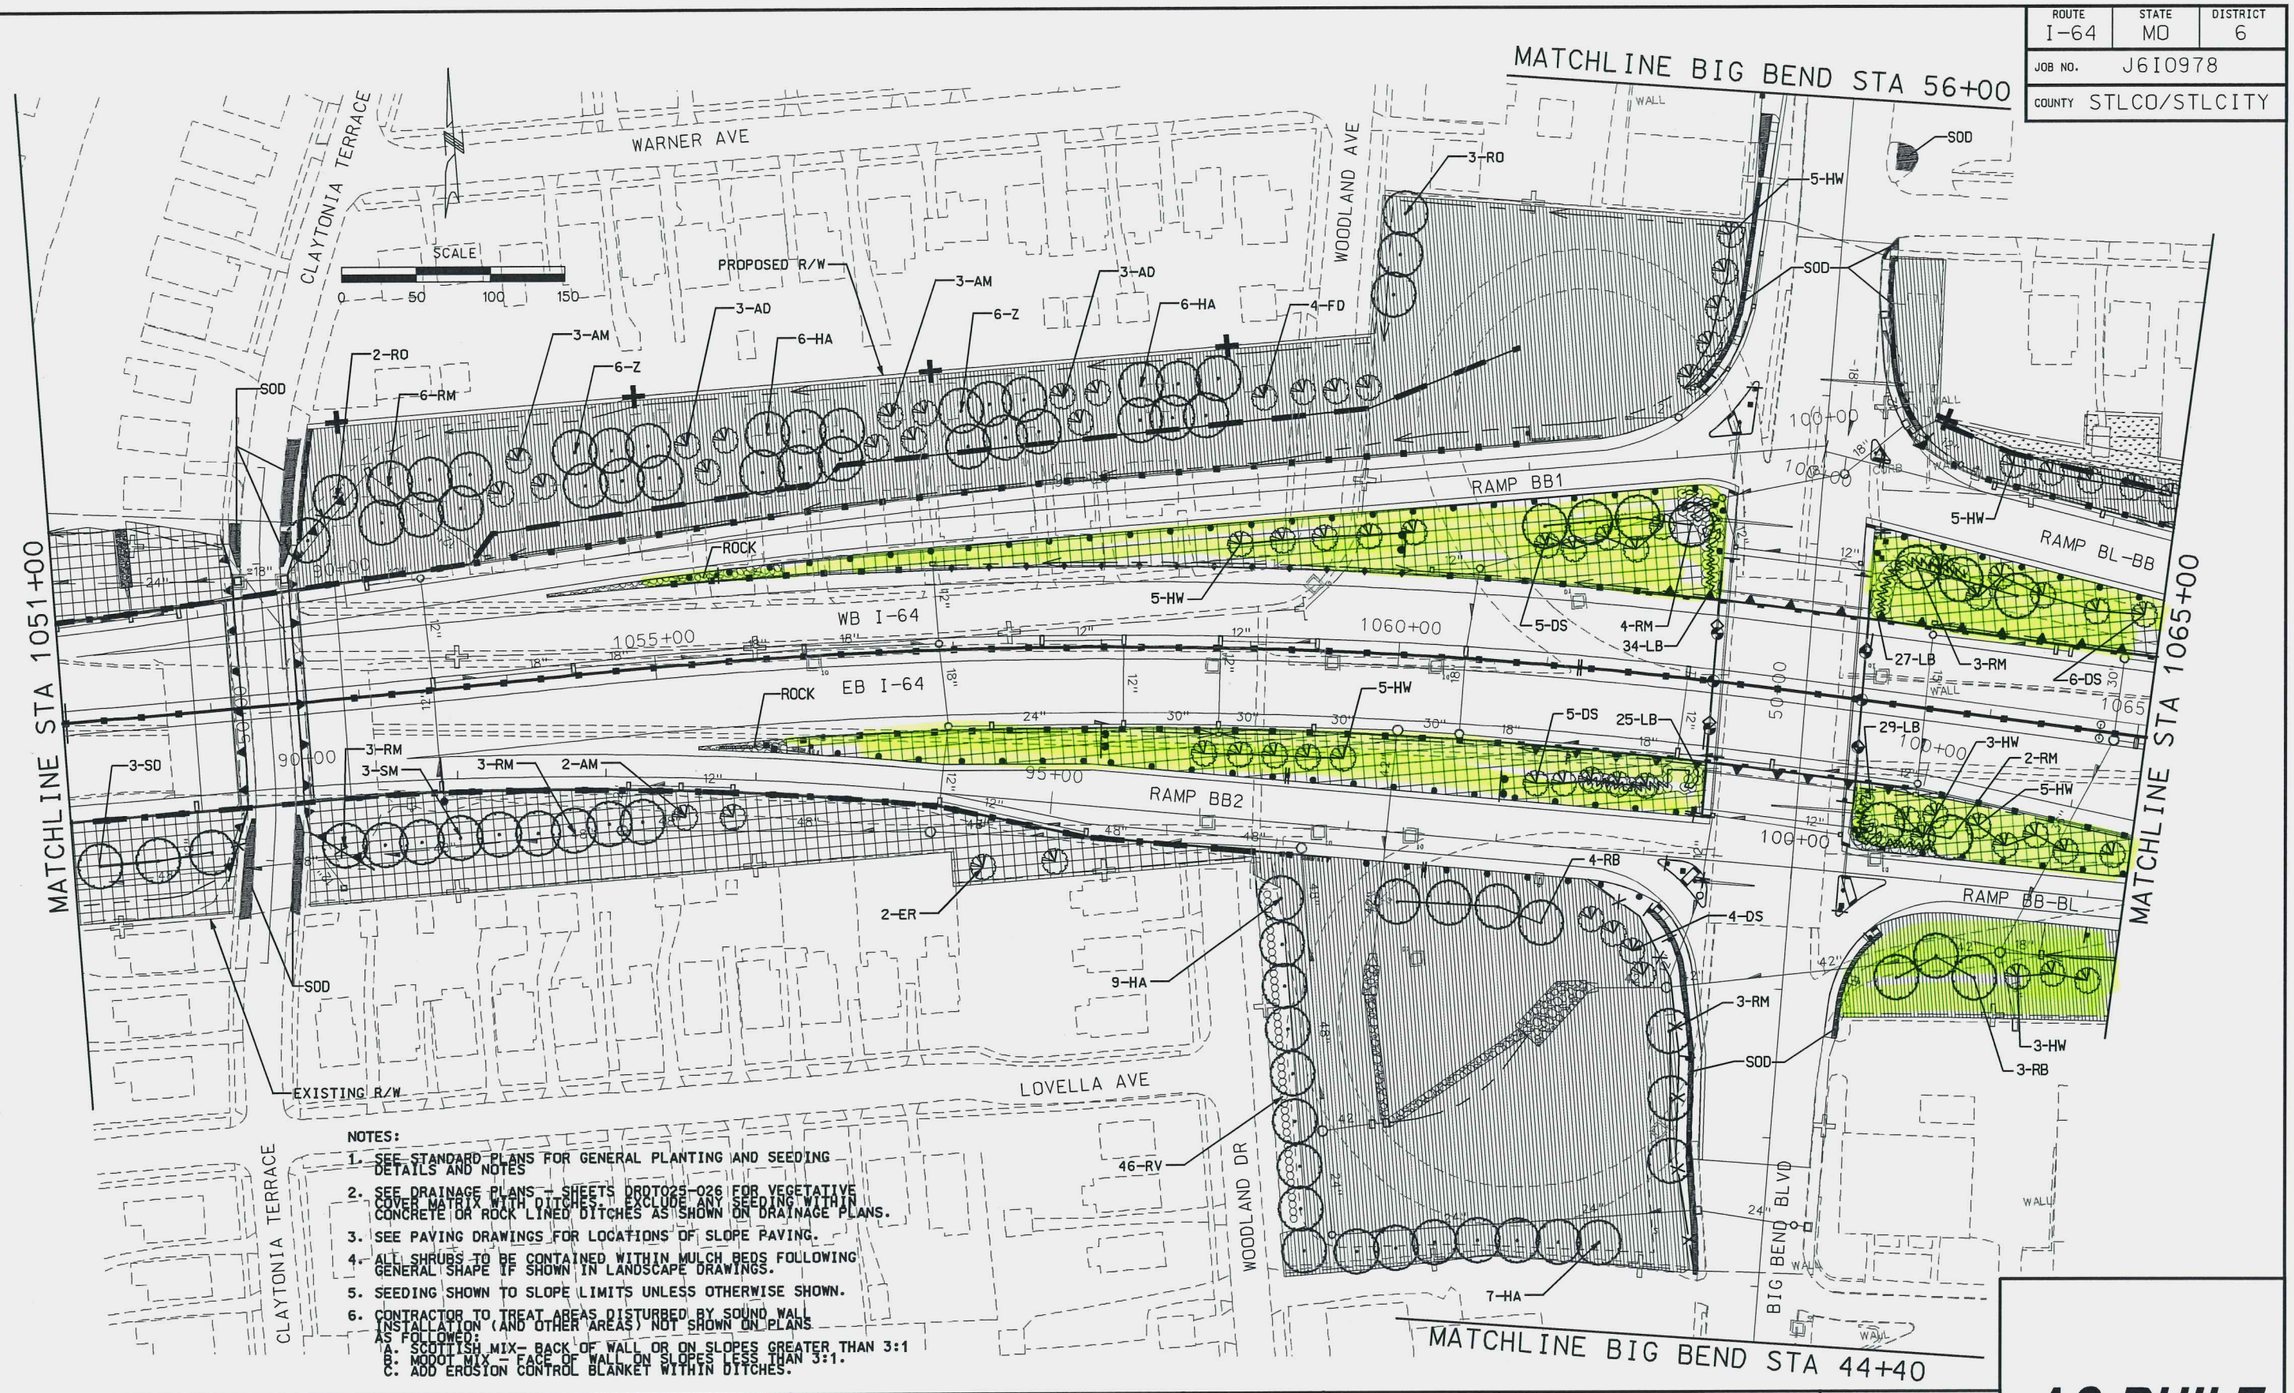

NOTES:

1. SEE STANDARD PLANS FOR GENERAL PLANTING AND SEEDING DETAILS AND NOTES
2. SEE DRAINAGE PLANS – SHEETS DR0T023-026 FOR VEGETATIVE COVER MATRIX WITH DITCHES. EXCLUDE ANY SEEDING WITHIN CONCRETE OR ROCK LINED DITCHES AS SHOWN ON DRAINAGE PLANS.
3. SEE PAVING DRAWINGS FOR LOCATIONS OF SLOPE PAVING.
4. ALL SHRUBS TO BE CONTAINED WITHIN MULCH BEDS FOLLOWING GENERAL SHAPE IF SHOWN IN LANDSCAPE DRAWINGS.
5. SEEDING SHOWN TO SLOPE LIMITS UNLESS OTHERWISE SHOWN.
6. CONTRACTOR TO TREAT AREAS DISTURBED BY SOUND WALL INSTALLATION (AND OTHER AREAS) NOT SHOWN ON PLANS AS FOLLOWS:
   A. SCOTTISH MIX– BACK OF WALL OR ON SLOPES GREATER THAN 3:1
   B. MODOT MIX – FACE OF WALL ON SLOPES LESS THAN 3:1.
   C. ADD EROSION CONTROL BLANKET WITHIN DITCHES.

ROUTE	STATE	DISTRICT
I-64	MO	6

JOB NO. J6I0978

COUNTY STLCO/STLCITY

DESIGNED BY:	ISSUE RECORD		
	NO.	DESCRIPTION	DATE
DRAFTED BY:	A	50% PLAN REVIEW SUBMITTAL	08JUN07
	B	70% PLAN REVIEW SUBMITTAL	15AUG07
	C	90% FINAL DESIGN	19OCT07
CHECKED BY:	1	RELEASED FOR CONSTRUCTION	12DEC07
	AB	AS-BUILT	11JUN10

PARSONS

Gateway Constructors
Granite • Fred Weber • Millstone Bangert

THE NEW I-64

THE NEW I-64 PROJECT
SEGMENT 2
LANDSCAPE PLAN
I-64
STA 1051+00 TO STA 1065+00

MoDOT

DRAWING NUMBER
LPPL016

AS-BUILT

File Name: C:\PW_WORKING\P0034418\DMS06264\016_LPPL_I100_S2.DGN
User: PARSONS
Time Plotted: 8:20:48 AM
Date Plotted: 8/2/2010
Pen Table: I-64_HALFSIZEBW-DATE.TBLPlot Driver: 11X17_PDF_AB.PLT

ROUTE	STATE	DISTRICT
I-64	MO	6
JOB NO.	J6I0978	
COUNTY	STLCO/STLCITY	

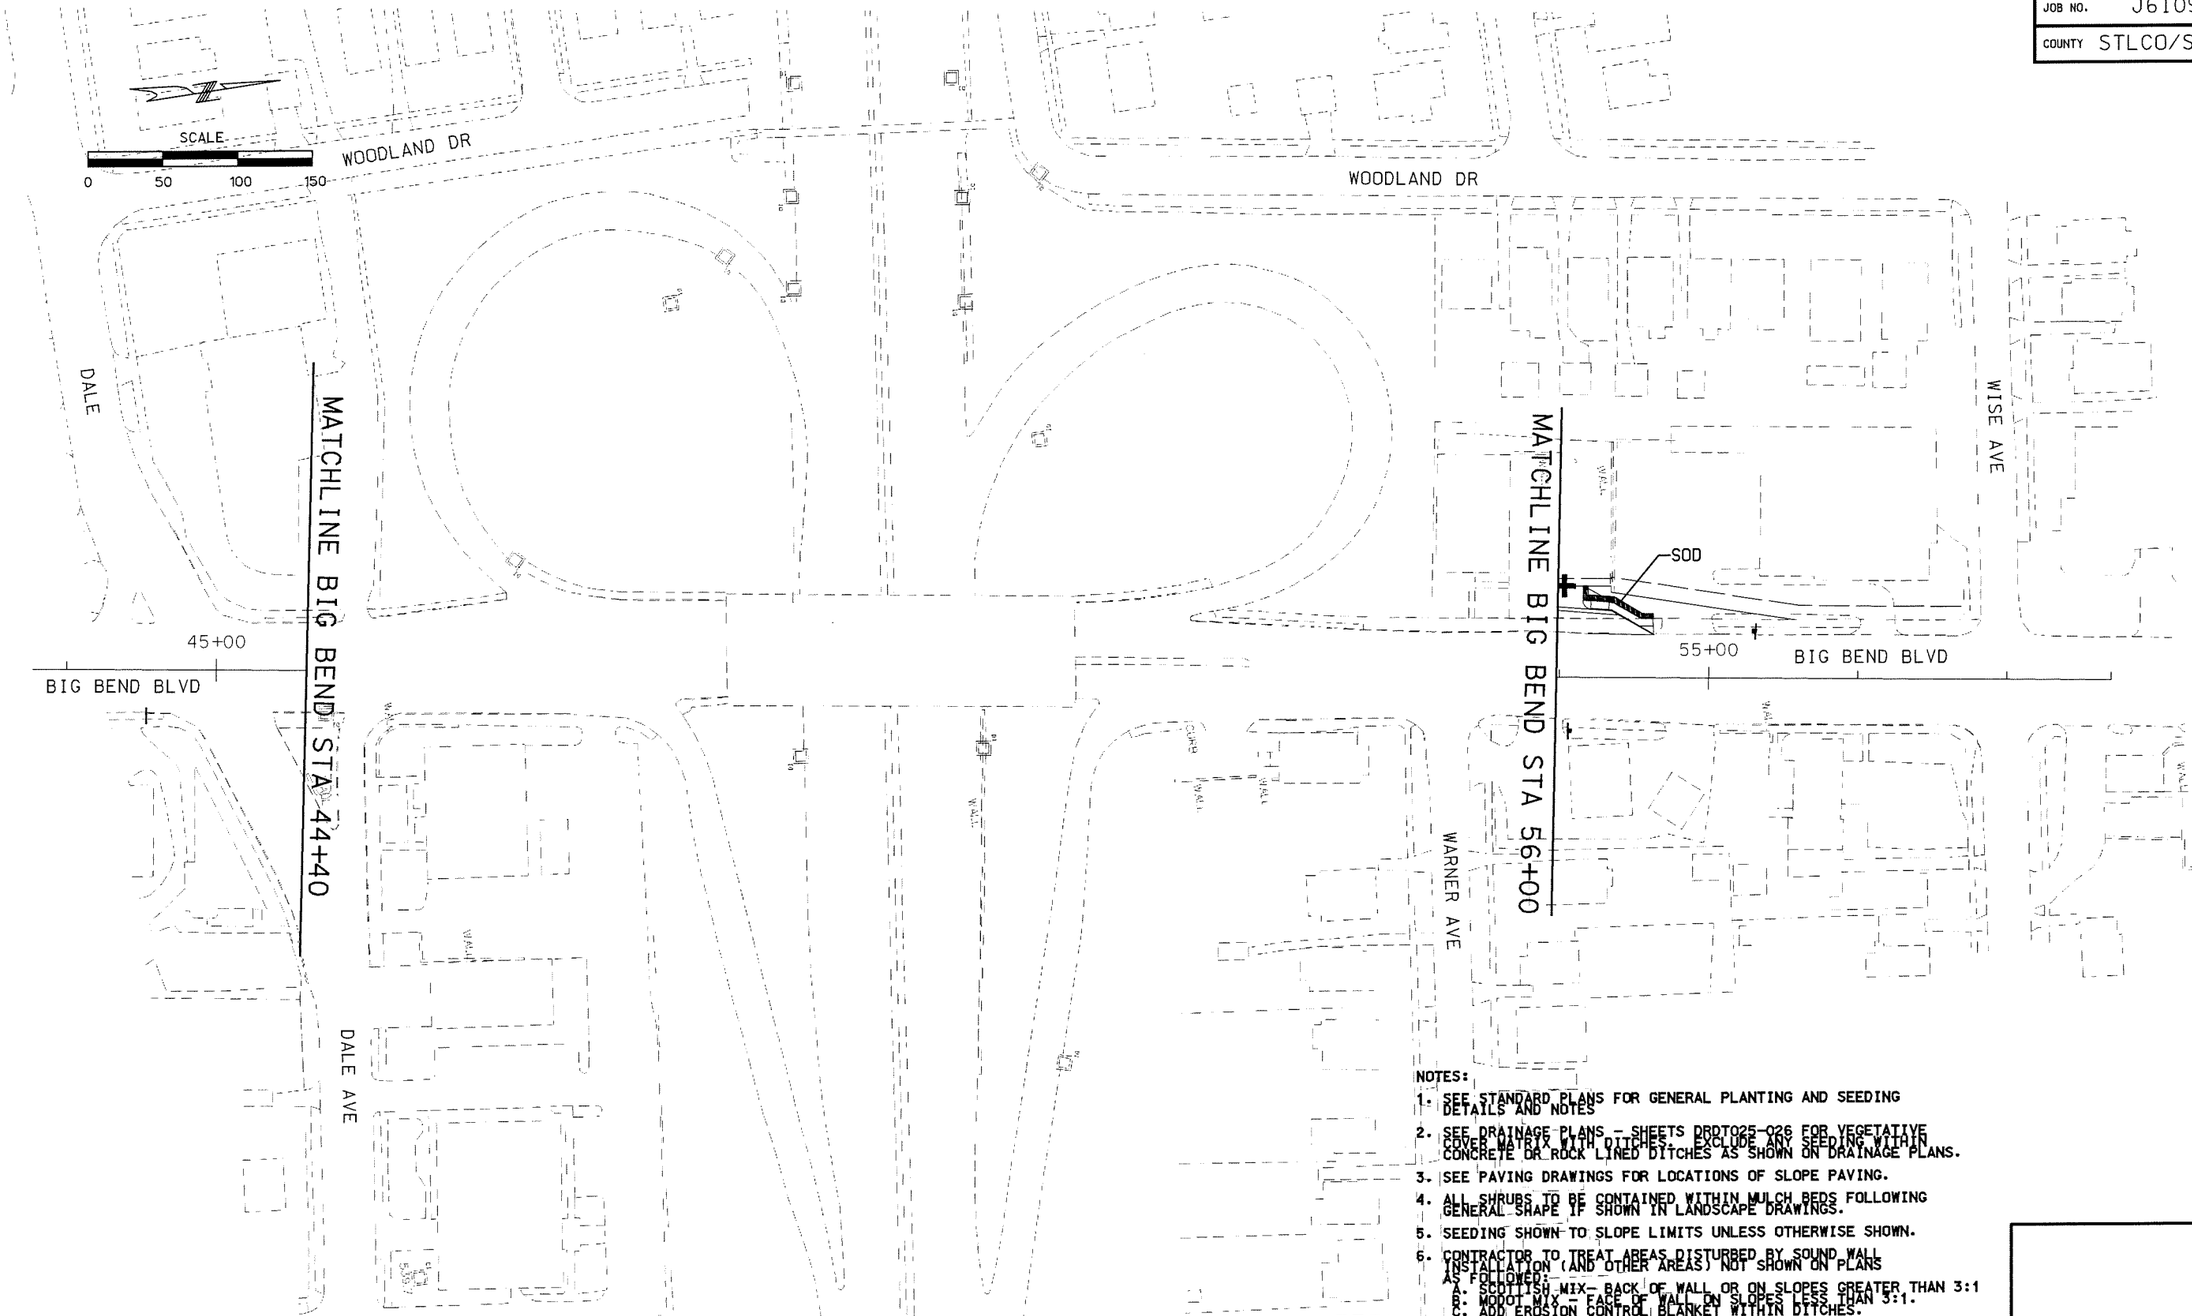

NOTES:

1. SEE STANDARD PLANS FOR GENERAL PLANTING AND SEEDING DETAILS AND NOTES
2. SEE DRAINAGE PLANS - SHEETS DRDT025-026 FOR VEGETATIVE COVER MATRIX FOR DITCHES. EXCLUDE ANY SEEDING WITHIN CONCRETE OR ROCK LINED DITCHES AS SHOWN ON DRAINAGE PLANS.
3. SEE PAVING DRAWINGS FOR LOCATIONS OF SLOPE PAVING.
4. ALL SHRUBS TO BE CONTAINED WITHIN MULCH BEDS FOLLOWING GENERAL SHAPE IF SHOWN IN LANDSCAPE DRAWINGS.
5. SEEDING SHOWN TO SLOPE LIMITS UNLESS OTHERWISE SHOWN.
6. CONTRACTOR TO TREAT AREAS DISTURBED BY SOUND WALL INSTALLATION (AND OTHER AREAS) NOT SHOWN ON PLANS AS FOLLOWED:
   A. SCOTTISH MIX- BACK OF WALL OR ON SLOPES GREATER THAN 3:1
   B. MODOT MIX - FACE OF WALL ON SLOPES LESS THAN 3:1.
   C. ADD EROSION CONTROL BLANKET WITHIN DITCHES.

DESIGNED BY:	ISSUE RECORD		
	NO.	DESCRIPTION	DATE
DRAFTED BY:	A	50% PLAN REVIEW SUBMITTAL	08JUN07
	B	70% PLAN REVIEW SUBMITTAL	15AUG07
	C	90% FINAL DESIGN	19OCT07
CHECKED BY:	1	RELEASED FOR CONSTRUCTION	12DEC07
	AB	AS-BUILT	11JUN10

PARSONS

Gateway Constructors
Granite • Fred Weber • Millstone Bangert

THE NEW I-64

THE NEW I-64 PROJECT
SEGMENT 2
LANDSCAPE PLAN
BIG BEND BLVD
BEGINNING TO END

MoDOT

DRAWING NUMBER
LPPL017

AS-BUILT

File Name: C:\EXPORT\ITEMP\017_LPPL_I100_S2.DGN
User: PARSONS
Time Plotted: 1:01:35 PM
Date Plotted: 7/16/2010
Pen Table: I-64_HALFSIZEBW-DATE.TBLPlot Driver: 11X17_PDF_AB.PLT

ROUTE	STATE	DISTRICT
I-64	MO	6
JOB NO.	J6I0978	
COUNTY	STLCO/STLCITY	

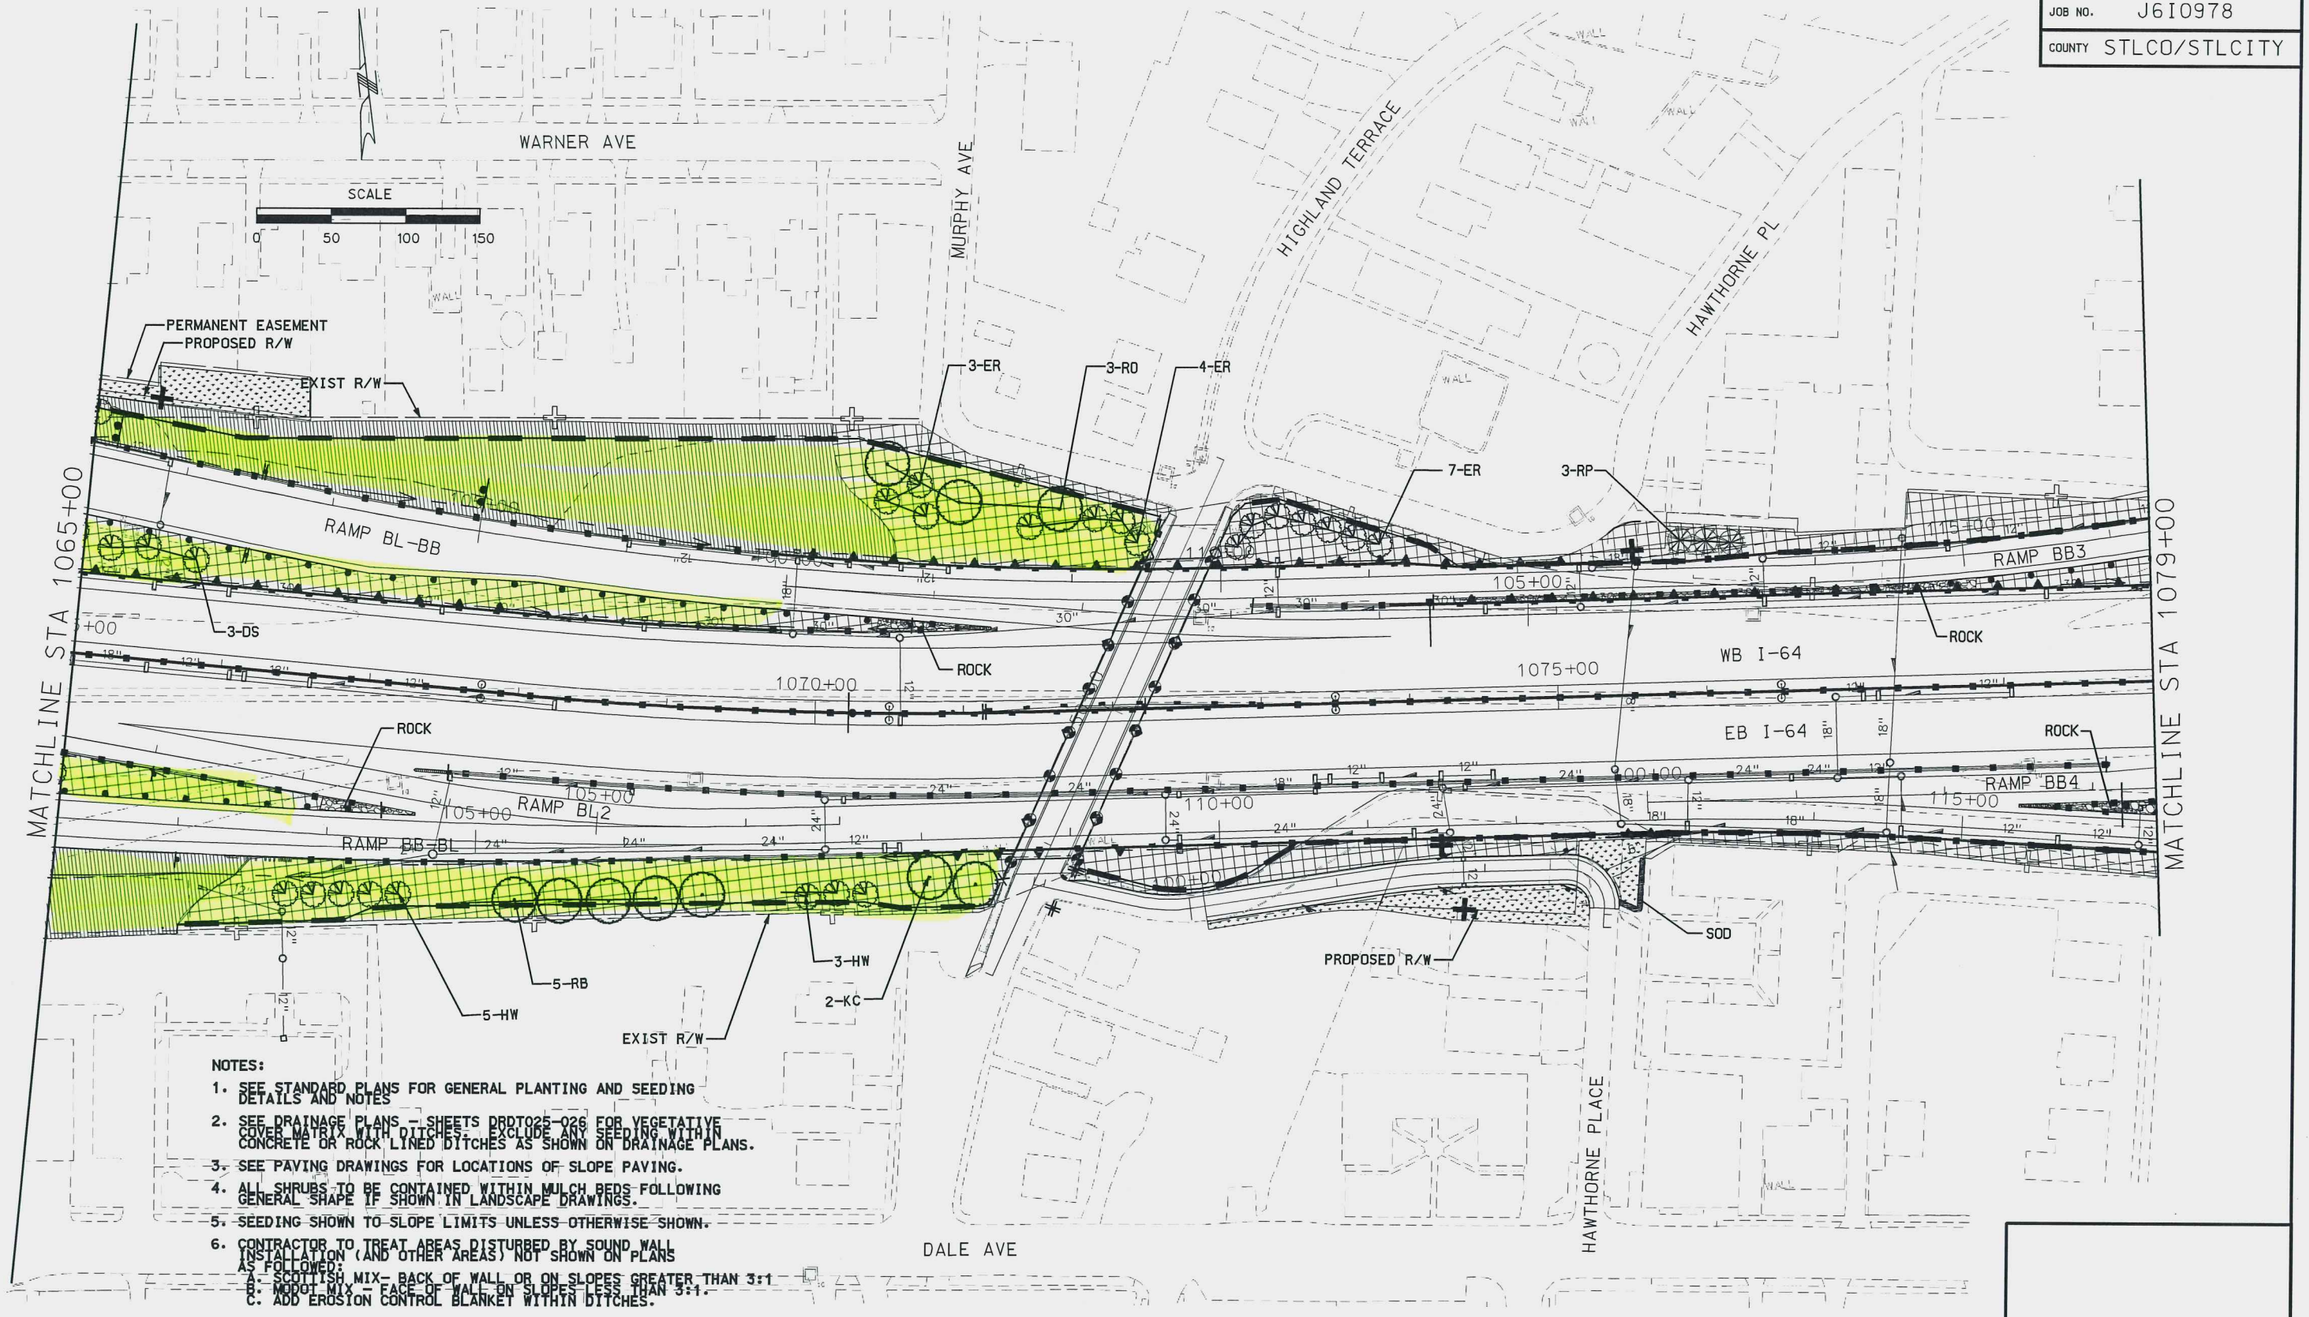

NOTES:

1. SEE STANDARD PLANS FOR GENERAL PLANTING AND SEEDING DETAILS AND NOTES
2. SEE DRAINAGE PLANS - SHEETS DRDT052-026 FOR VEGETATIVE COVER MATRIX FOR DITCHES. EXCLUDE ANY SEEDING WITHIN CONCRETE OR ROCK LINED DITCHES AS SHOWN ON DRAINAGE PLANS.
3. SEE PAVING DRAWINGS FOR LOCATIONS OF SLOPE PAVING.
4. ALL SHRUBS TO BE CONTAINED WITHIN MULCH BEDS FOLLOWING GENERAL SHAPE IF SHOWN IN LANDSCAPE DRAWINGS.
5. SEEDING SHOWN TO SLOPE LIMITS UNLESS OTHERWISE SHOWN.
6. CONTRACTOR TO TREAT AREAS DISTURBED BY SOUND WALL INSTALLATION (AND OTHER AREAS) NOT SHOWN ON PLANS AS FOLLOWED:
   A. SCOTTISH MIX- BACK OF WALL OR ON SLOPES GREATER THAN 3:1
   B. MODOT MIX - FACE OF WALL ON SLOPES LESS THAN 3:1.
   C. ADD EROSION CONTROL BLANKET WITHIN DITCHES.

DESIGNED BY:	ISSUE RECORD		
	NO.	DESCRIPTION	DATE
DRAFTED BY:	A	50% PLAN REVIEW SUBMITTAL	08JUNE07
	B	70% PLAN REVIEW SUBMITTAL	15AUG07
	C	90% FINAL DESIGN	19OCT07
CHECKED BY:	1	RELEASED FOR CONSTRUCTION	12DEC07
	AB	AS-BUILT	11JUN10

PARSONS

Gateway Constructors
Granite • Fred Weber • Millstone Bangert

THE NEW I-64

THE NEW I-64 PROJECT
SEGMENT 2
LANDSCAPE PLAN
I-64
STA 1065+00 TO STA 1079+00

MoDOT

DRAWING NUMBER
LPPL018

AS-BUILT

File Name: C:\EXPORT\ITEMP\018_LPPL_I100_S2.DGN
User: PARSONS
Time Plotted: 1:01:40 PM
Date Plotted: 7/16/2010
Pen Table: I-64_HALFSIZEBW-DATE.TBL
Plot Driver: 11X17_PDF_AB.PLT

ROUTE	STATE	DISTRICT
I-64	MO	6
JOB NO.	J6I0978	
COUNTY	STLCO/STLCITY	

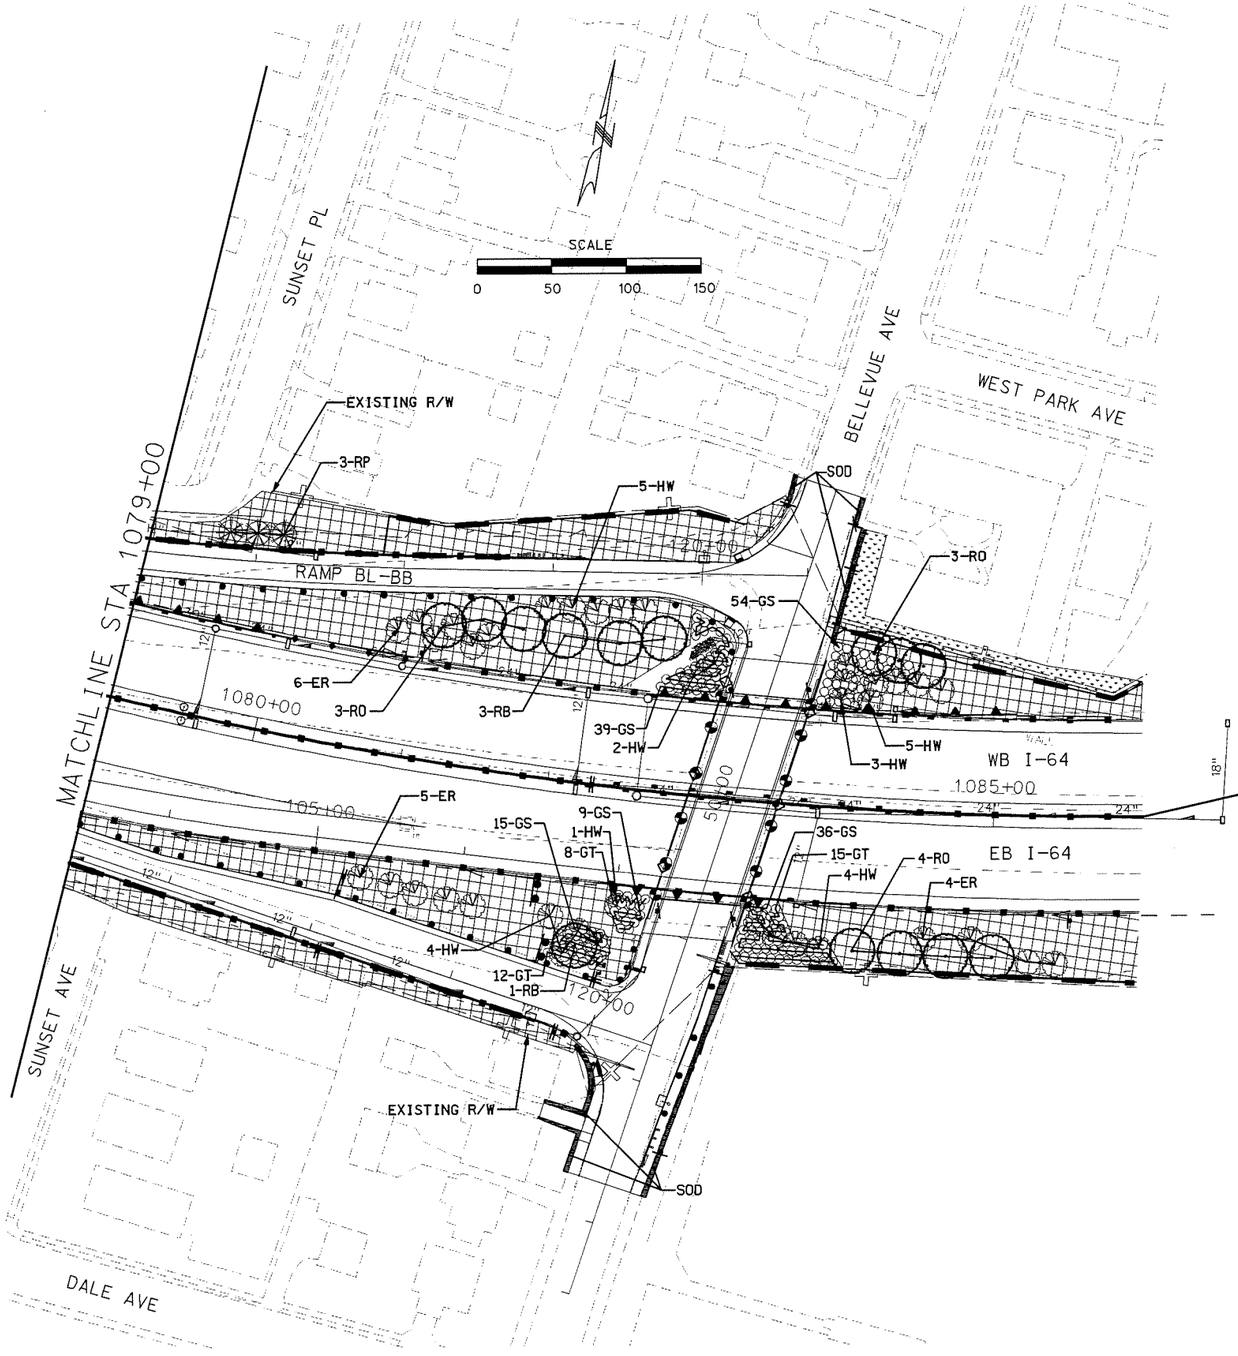

END SEGMENT 2
STA 1086+00 BK

BEGIN SEGMENT 3
STA AH

NOTES:

1. SEE STANDARD PLANS FOR GENERAL PLANTING AND SEEDING DETAILS AND NOTES
2. SEE DRAINAGE PLANS - SHEETS DRDT025-026 FOR VEGETATIVE COVER MATRIX WITH DITCHES. EXCLUDE ANY SEEDING WITHIN CONCRETE OR ROCK LINED DITCHES AS SHOWN ON DRAINAGE PLANS.
3. SEE PAVING DRAWINGS FOR LOCATIONS OF SLOPE PAVING.
4. ALL SHRUBS TO BE CONTAINED WITHIN MULCH BEDS FOLLOWING GENERAL SHAPE IF SHOWN IN LANDSCAPE DRAWINGS.
5. SEEDING SHOWN TO SLOPE LIMITS UNLESS OTHERWISE SHOWN.
6. CONTRACTOR TO TREAT AREAS DISTURBED BY SOUND WALL INSTALLATION (AND OTHER AREAS) NOT SHOWN ON PLANS AS FOLLOWS:
   A. SCOTTISH MIX- BACK OF WALL OR ON SLOPES GREATER THAN 3:1
   B. MODOT MIX - FACE OF WALL ON SLOPES LESS THAN 3:1.
   C. ADD EROSION CONTROL BLANKET WITHIN DITCHES.

DESIGNED BY:	ISSUE RECORD		
	NO.	DESCRIPTION	DATE
DRAFTED BY:	A	50% PLAN REVIEW SUBMITTAL	08JUNE07
	B	70% PLAN REVIEW SUBMITTAL	15AUG07
	C	90% FINAL DESIGN	19OCT07
CHECKED BY:	1	RELEASED FOR CONSTRUCTION	12DEC07
	AB	AS-BUILT	11JUN10

PARSONS

Gateway Constructors
Granite • Fred Weber • Millstone Bangert

THE NEW I-64

THE NEW I-64 PROJECT
SEGMENT 2
LANDSCAPE PLAN
I-64
STA 1079+00 TO STA 1086+00

MoDOT

DRAWING NUMBER
LPPL019

AS-BUILT

File Name: C:\EXPORT\ITEMP\019_LPPL_I100_S2.DGN
User: PARSONS
Time Plotted: 1:01:49 PM
Date Plotted: 7/16/2010
Pen Table: I-64_HALFSIZEBW-DATE.TBLPlot Driver: 11X17_PDF_AB.PLT

ROUTE	STATE	DISTRICT
I-64	MO	6
JOB NO.	J6I0978	
COUNTY	STLCO/STLCITY	

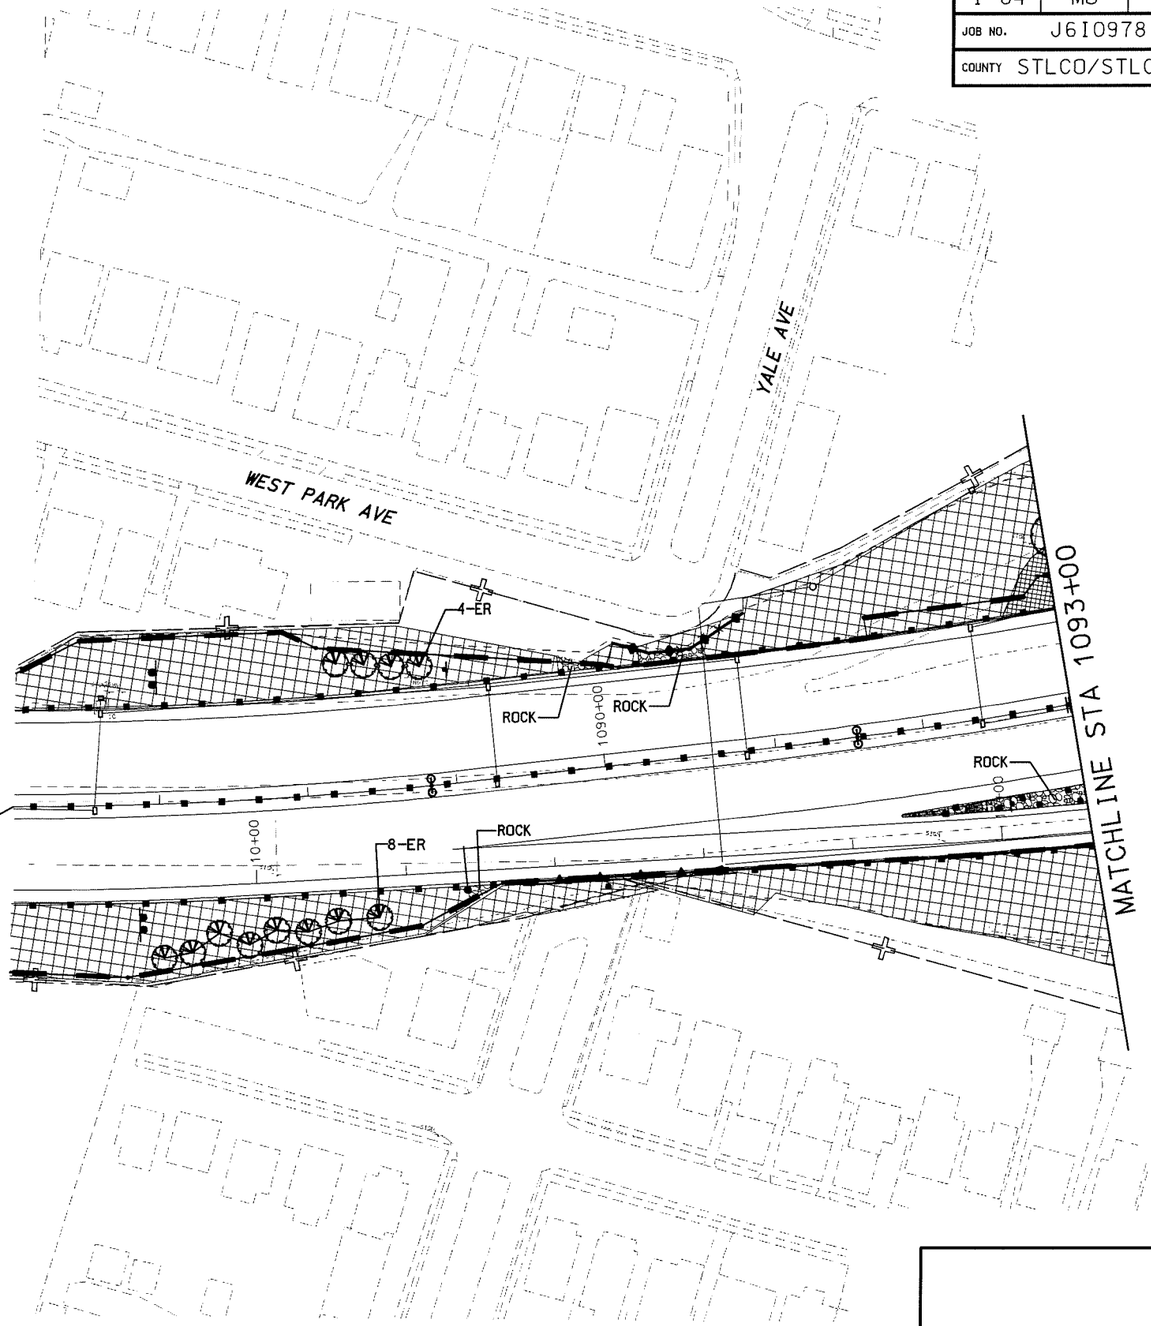

END SEGMENT 2
STA 1086+00 BK

BEGIN SEGMENT 3
STA 1086+03.10 AH

LANDSCAPE PLAN LEGEND:

- SOD
- TURF SEED MIX
- MODOT SEED MIX
- NATIVE SEED MIX
- SCOTISH SEED MIX
- ROCK

NOTES:

1. SEE STANDARD PLANS FOR GENERAL PLANTING AND SEEDING DETAILS AND NOTES
2. EXCLUDE ANY SEEDING WITHIN CONCRETE OR ROCK LINED DITCHES AS SHOWN ON DRAINAGE PLANS.
2. SEE PAVING DRAWINGS FOR LOCATIONS OF SLOPE PAVING.
3. ALL SHRUBS TO BE CONTAINED WITHIN MULCH BEDS FOLLOWING GENERAL SHAPE IF SHOWN IN LANDSCAPE DRAWINGS.
4. SEEDING SHOWN TO SLOPE LIMITS UNLESS OTHERWISE SHOWN.
5. CONTRACTOR TO TREAT AREAS DISTURBED BY SOUND WALL INSTALLATION (AND OTHER AREAS) NOT SHOWN ON PLANS AS FOLLOWED:
   A. SCOTTISH MIX- BACK OF WALL OR ON SLOPES GREATER THAN 3:1
   B. MODOT MIX - FACE OF WALL ON SLOPES LESS THAN 3:1.
   C. ADD EROSION CONTROL BLANKET WITHIN DITCHES.

DESIGNED BY: AT
DRAFTED BY: BQ
CHECKED BY: JC

ISSUE RECORD

NO.	DESCRIPTION	DATE
1	RELEASED FOR CONSTRUCTION	30NOV07
AB	AS-BUILT	14JUN10

PARSONS

Gateway Constructors
Granite • Fred Weber • Millstone Bangert

THE NEW I-64

THE NEW I-64 PROJECT
SEGMENT 3
LANDSCAPE PLAN
I-64/40
STA 1086+03.10 TO STA 1093+00.00

MoDOT

DRAWING NUMBER
LPPL001

AS-BUILT

Pen Table: I-64_HALFSIZEBW-DATE.TBL Plot Driver: 11X17_PDF_AB.PLT
Date Plotted: 7/16/2010
Time Plotted: 2:04:07 PM
File Name: C:\EXPORT\TEMP\001_LPPL_1100_S3.DGN
User: PARSONS

ROUTE	STATE	DISTRICT
I-64	MO	6
JOB NO.	J6I0978	
COUNTY	STLCO/STLCITY	

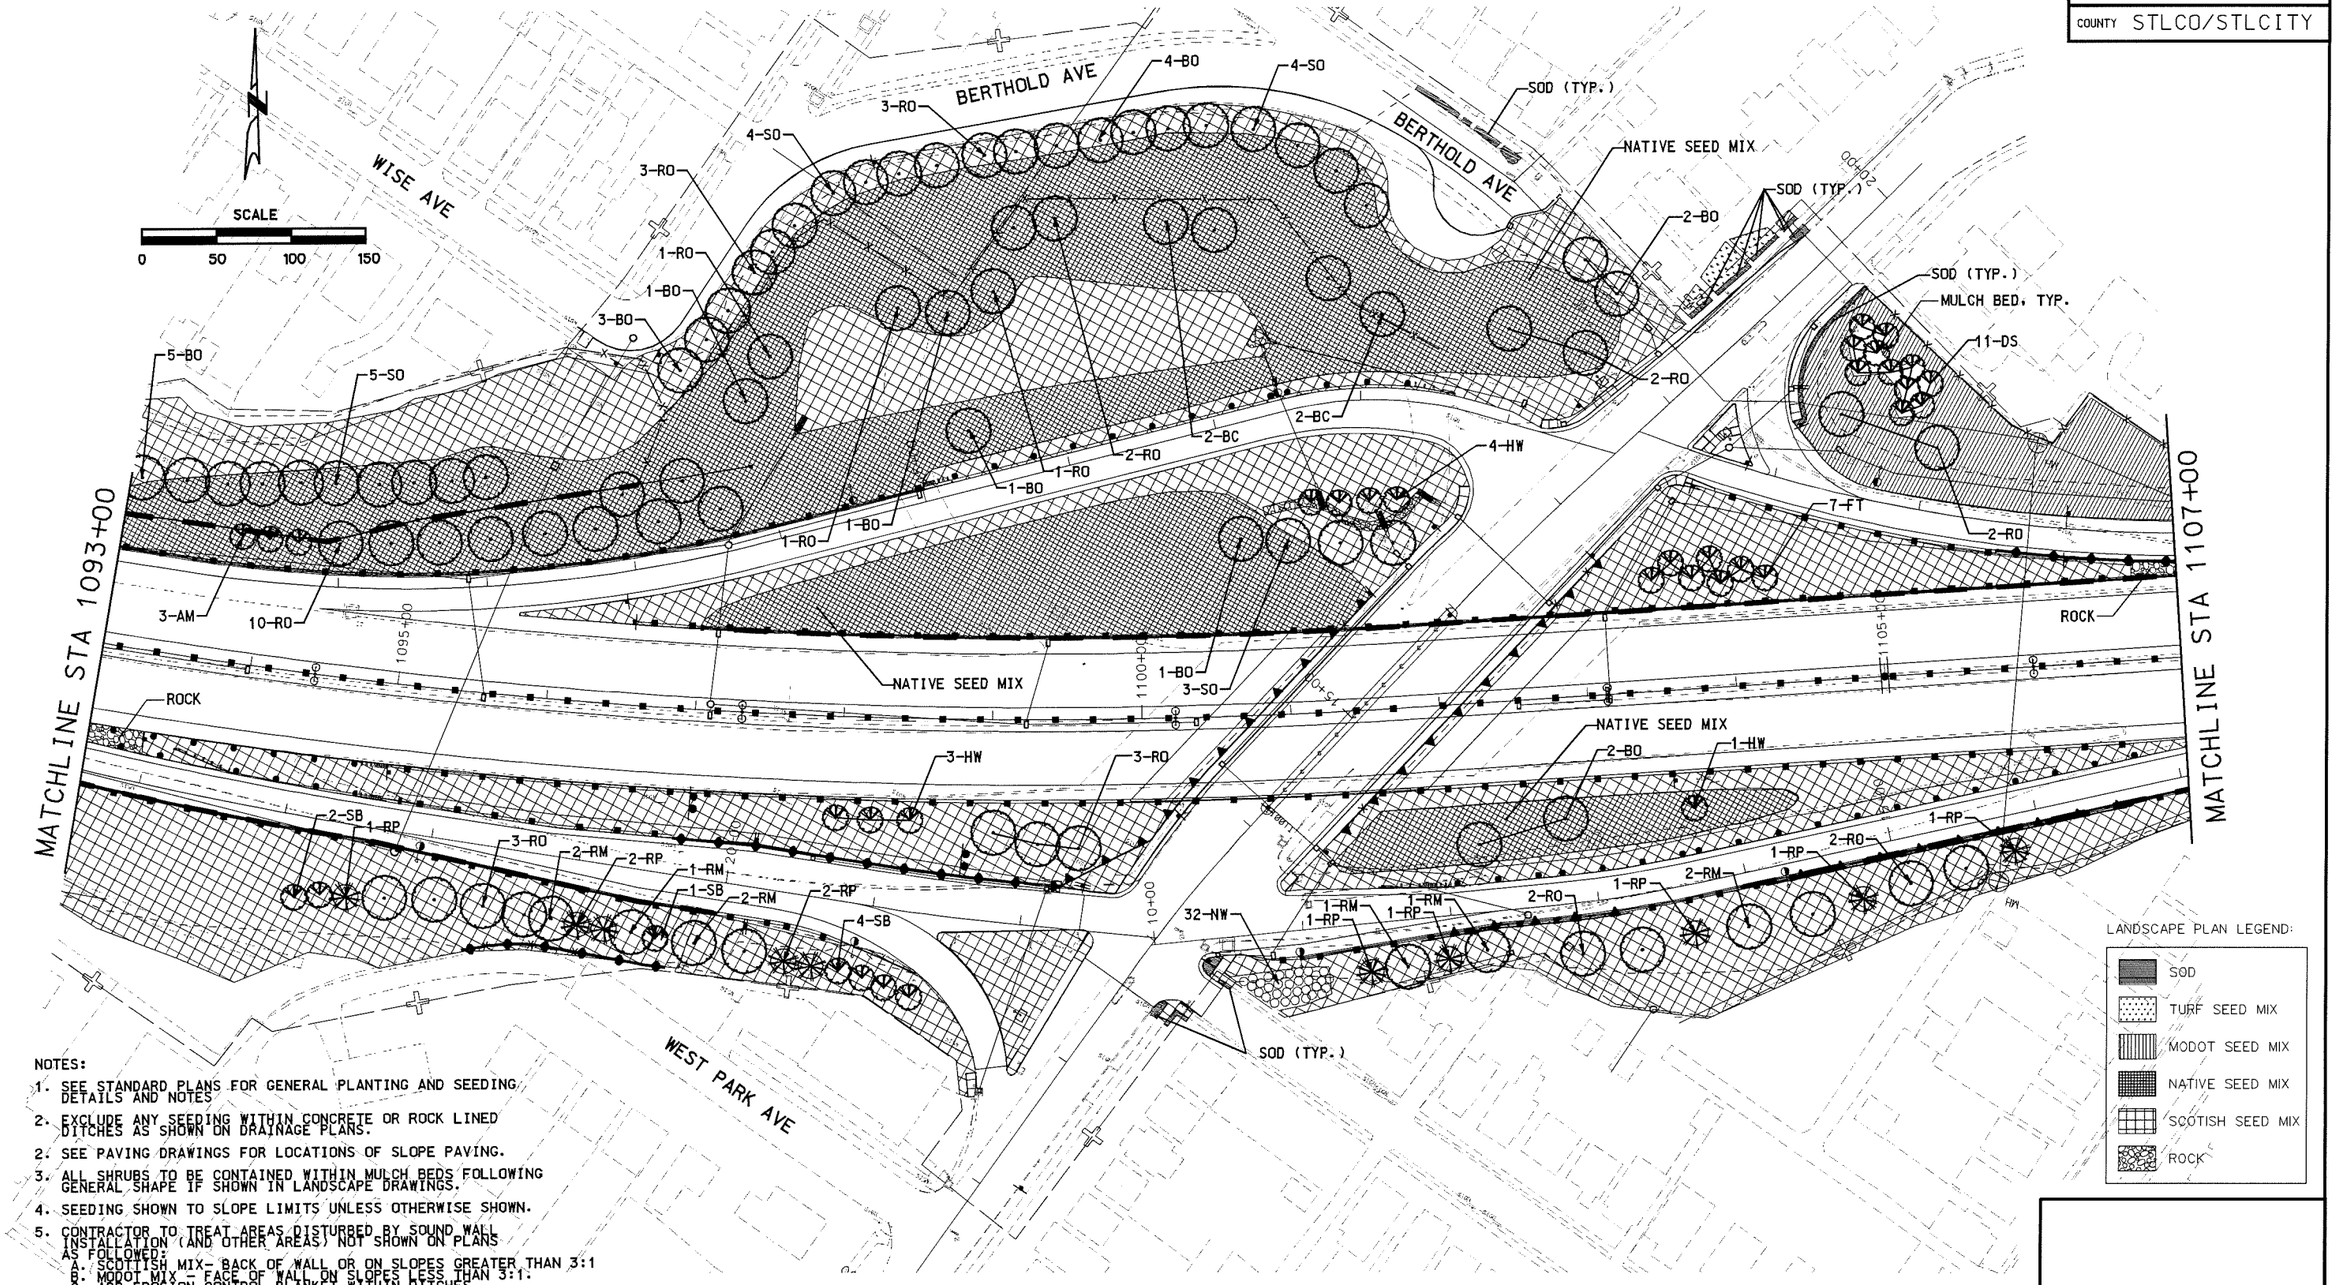

LANDSCAPE PLAN LEGEND:

- SOD
- TURF SEED MIX
- MODOT SEED MIX
- NATIVE SEED MIX
- SCOTTISH SEED MIX
- ROCK

NOTES:

1. SEE STANDARD PLANS FOR GENERAL PLANTING AND SEEDING DETAILS AND NOTES
2. EXCLUDE ANY SEEDING WITHIN CONCRETE OR ROCK LINED DITCHES AS SHOWN ON DRAINAGE PLANS.
2. SEE PAVING DRAWINGS FOR LOCATIONS OF SLOPE PAVING.
3. ALL SHRUBS TO BE CONTAINED WITHIN MULCH BEDS FOLLOWING GENERAL SHAPE IF SHOWN IN LANDSCAPE DRAWINGS.
4. SEEDING SHOWN TO SLOPE LIMITS UNLESS OTHERWISE SHOWN.
5. CONTRACTOR TO TREAT AREAS DISTURBED BY SOUND WALL INSTALLATION (AND OTHER AREAS) NOT SHOWN ON PLANS AS FOLLOWED:
   A. SCOTTISH MIX- BACK OF WALL OR ON SLOPES GREATER THAN 3:1
   B. MODOT MIX - FACE OF WALL ON SLOPES LESS THAN 3:1.
   C. ADD EROSION CONTROL BLANKET WITHIN DITCHES.

DESIGNED BY:	AT
DRAFTED BY:	BQ
CHECKED BY:	JC

ISSUE RECORD

NO.	DESCRIPTION	DATE
1	RELEASED FOR CONSTRUCTION	30NOVOT
AB	AS-BUILT	14JUN10

PARSONS

Gateway Constructors
Granite • Fred Weber • Millstone Bangert

THE NEW I-64

THE NEW I-64 PROJECT
SEGMENT 3
LANDSCAPE PLAN
I-64/40
STA 1093+00.00 TO STA 1107+00.00

MoDOT

DRAWING NUMBER
LPPL002

AS-BUILT

File Name: C:\EXPORT\ITEMP\002_LPPL_I100_S3.DGN
User: PARSONS
Time Plotted: 2:04:13 PM
Date Plotted: 7/16/2010
Pen Table: I-64_HALFSIZEBW-DATE.TBL
Plot Driver: 11X17_PDF_AB.PLT

ROUTE	STATE	DISTRICT
I-64	MO	6
JOB NO.	J6I0978	
COUNTY	STLCO/STLCITY	

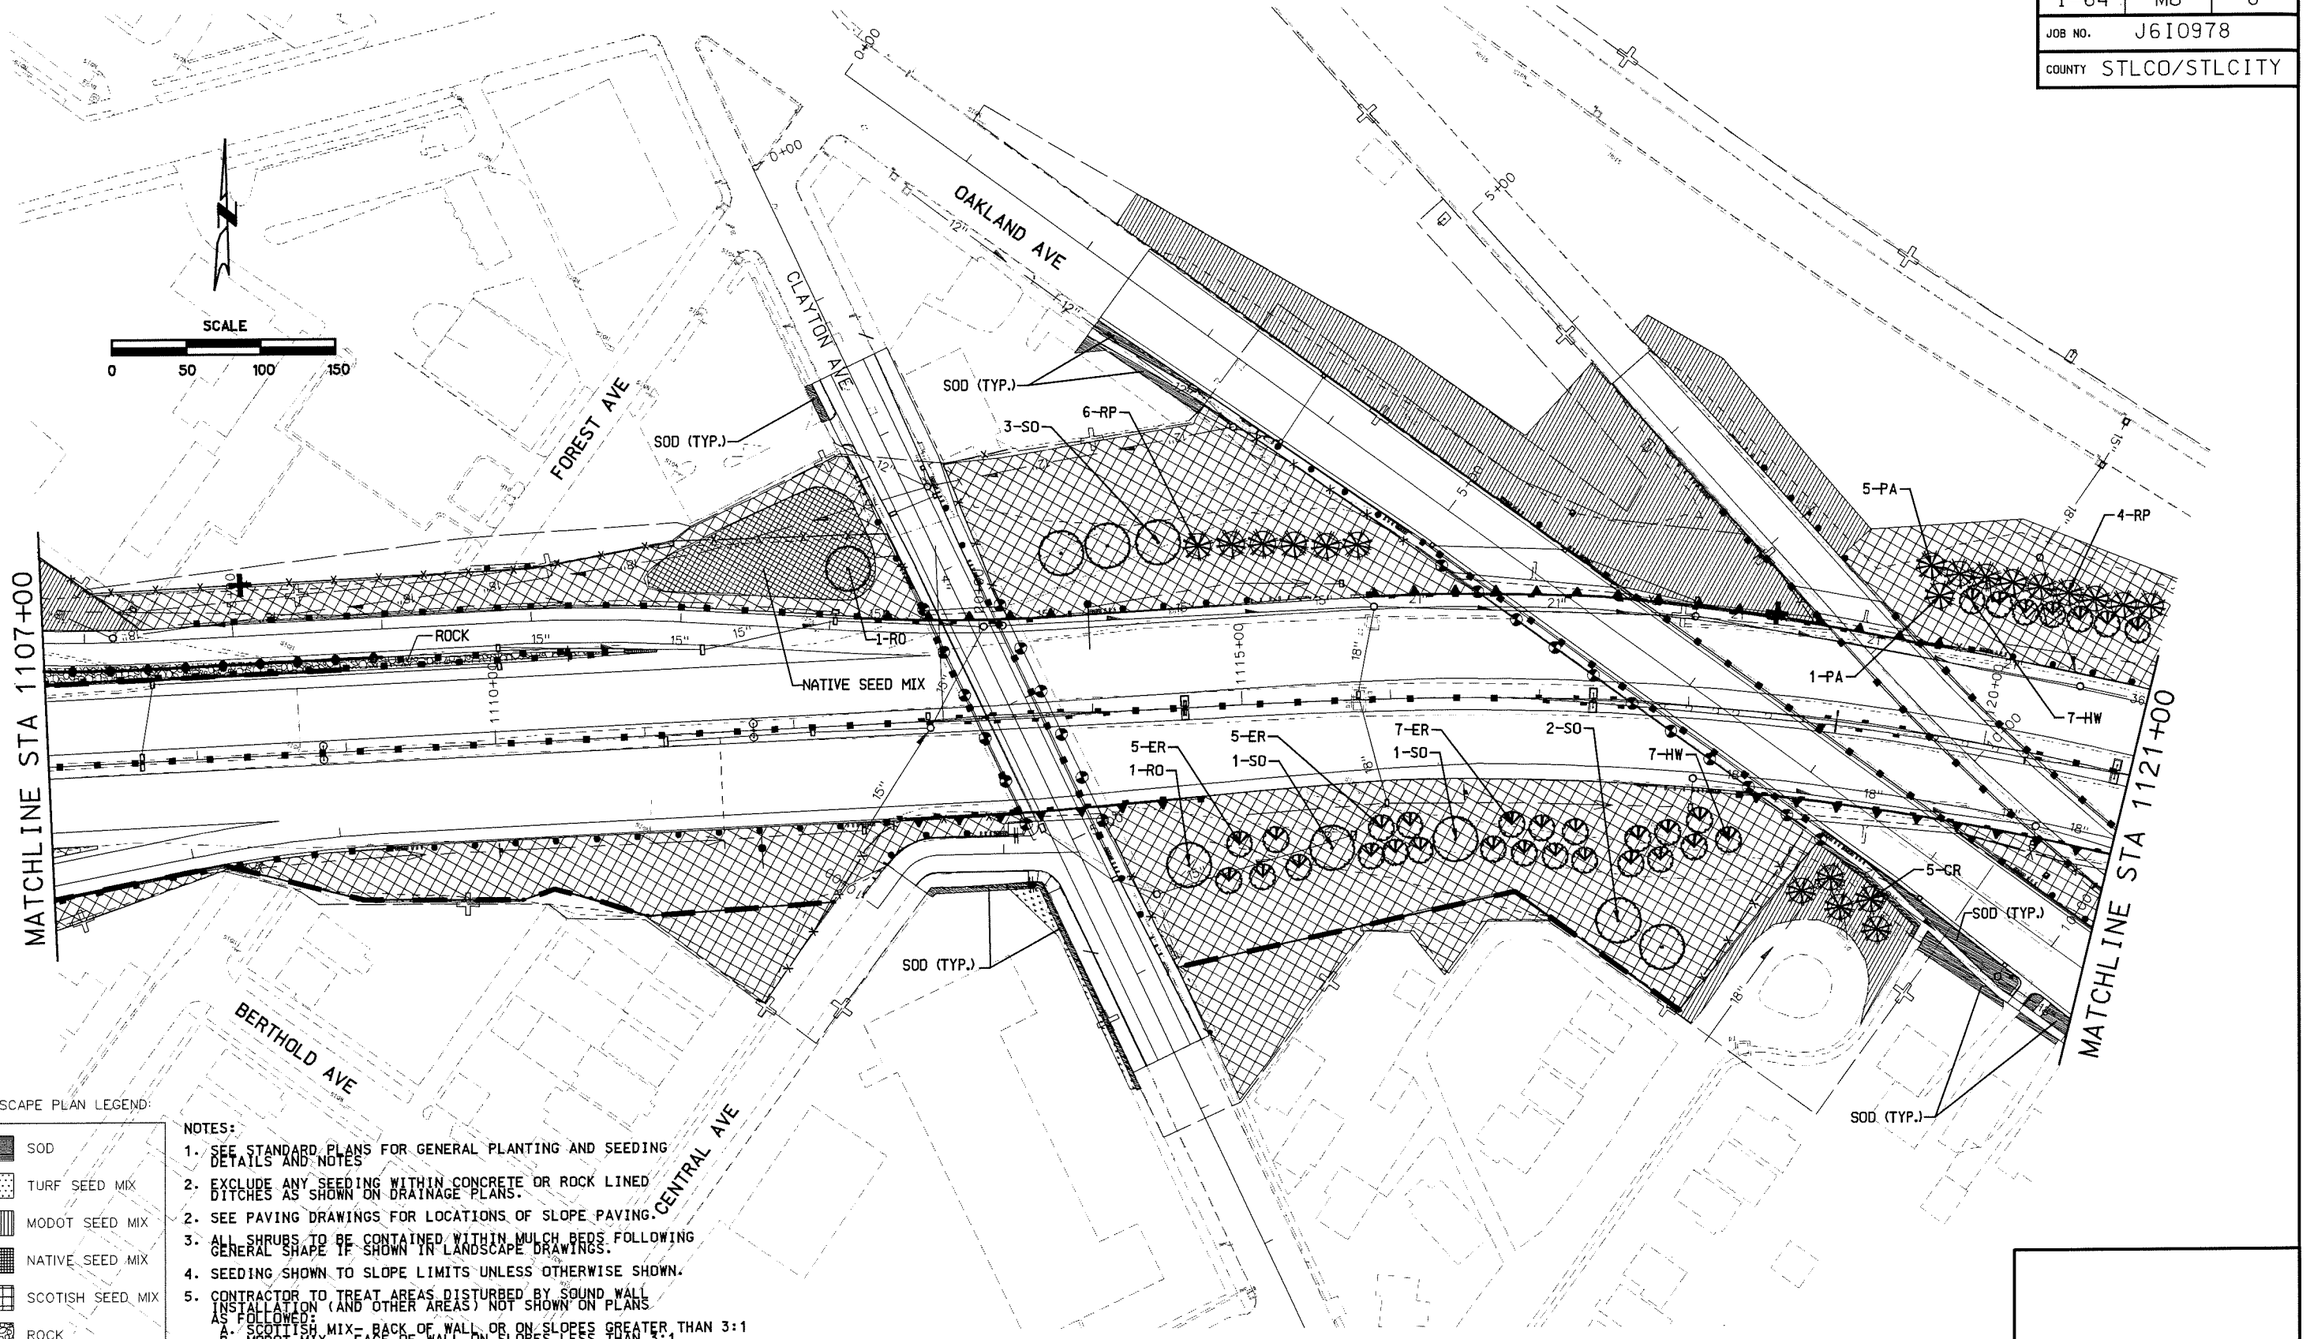

LANDSCAPE PLAN LEGEND:

- SOD
- TURF SEED MIX
- MODOT SEED MIX
- NATIVE SEED MIX
- SCOTISH SEED MIX
- ROCK

NOTES:

1. SEE STANDARD PLANS FOR GENERAL PLANTING AND SEEDING DETAILS AND NOTES
2. EXCLUDE ANY SEEDING WITHIN CONCRETE OR ROCK LINED DITCHES AS SHOWN ON DRAINAGE PLANS.
2. SEE PAVING DRAWINGS FOR LOCATIONS OF SLOPE PAVING.
3. ALL SHRUBS TO BE CONTAINED WITHIN MULCH BEDS FOLLOWING GENERAL SHAPE IF SHOWN IN LANDSCAPE DRAWINGS.
4. SEEDING SHOWN TO SLOPE LIMITS UNLESS OTHERWISE SHOWN.
5. CONTRACTOR TO TREAT AREAS DISTURBED BY SOUND WALL INSTALLATION (AND OTHER AREAS) NOT SHOWN ON PLANS AS FOLLOWED:
   A. SCOTTISH MIX- BACK OF WALL OR ON SLOPES GREATER THAN 3:1
   B. MODOT MIX - FACE OF WALL ON SLOPES LESS THAN 3:1.
   C. ADD EROSION CONTROL BLANKET WITHIN DITCHES.

DESIGNED BY: AT	ISSUE RECORD		
DRAFTED BY: BQ	NO.	DESCRIPTION	DATE
CHECKED BY: JC	1	RELEASED FOR CONSTRUCTION	30NOV07
	AB	AS-BUILT	14JUN10

PARSONS

Gateway Constructors
Granite • Fred Weber • Millstone Bangert

THE NEW I-64

THE NEW I-64 PROJECT
SEGMENT 3
LANDSCAPE PLAN
I-64/40
STA 1107+00.00 TO STA 1121+00.00

MoDOT

DRAWING NUMBER
LPPL003

AS-BUILT

File Name: C:\EXPORT\ITEMP\003_LPPL_I100_S3.DGN
User: PARSONS
Pen Table: 1-64_HALFSIZEBW-DATE.TBL Plot Driver: 11X17_PDF_AB.PLT
Time Plotted: 2:04:24 PM
Date Plotted: 7/16/2010

ROUTE	STATE	DISTRICT
I-64	MO	6
JOB NO.	J6I0978	
COUNTY	STLCO/STLCITY	

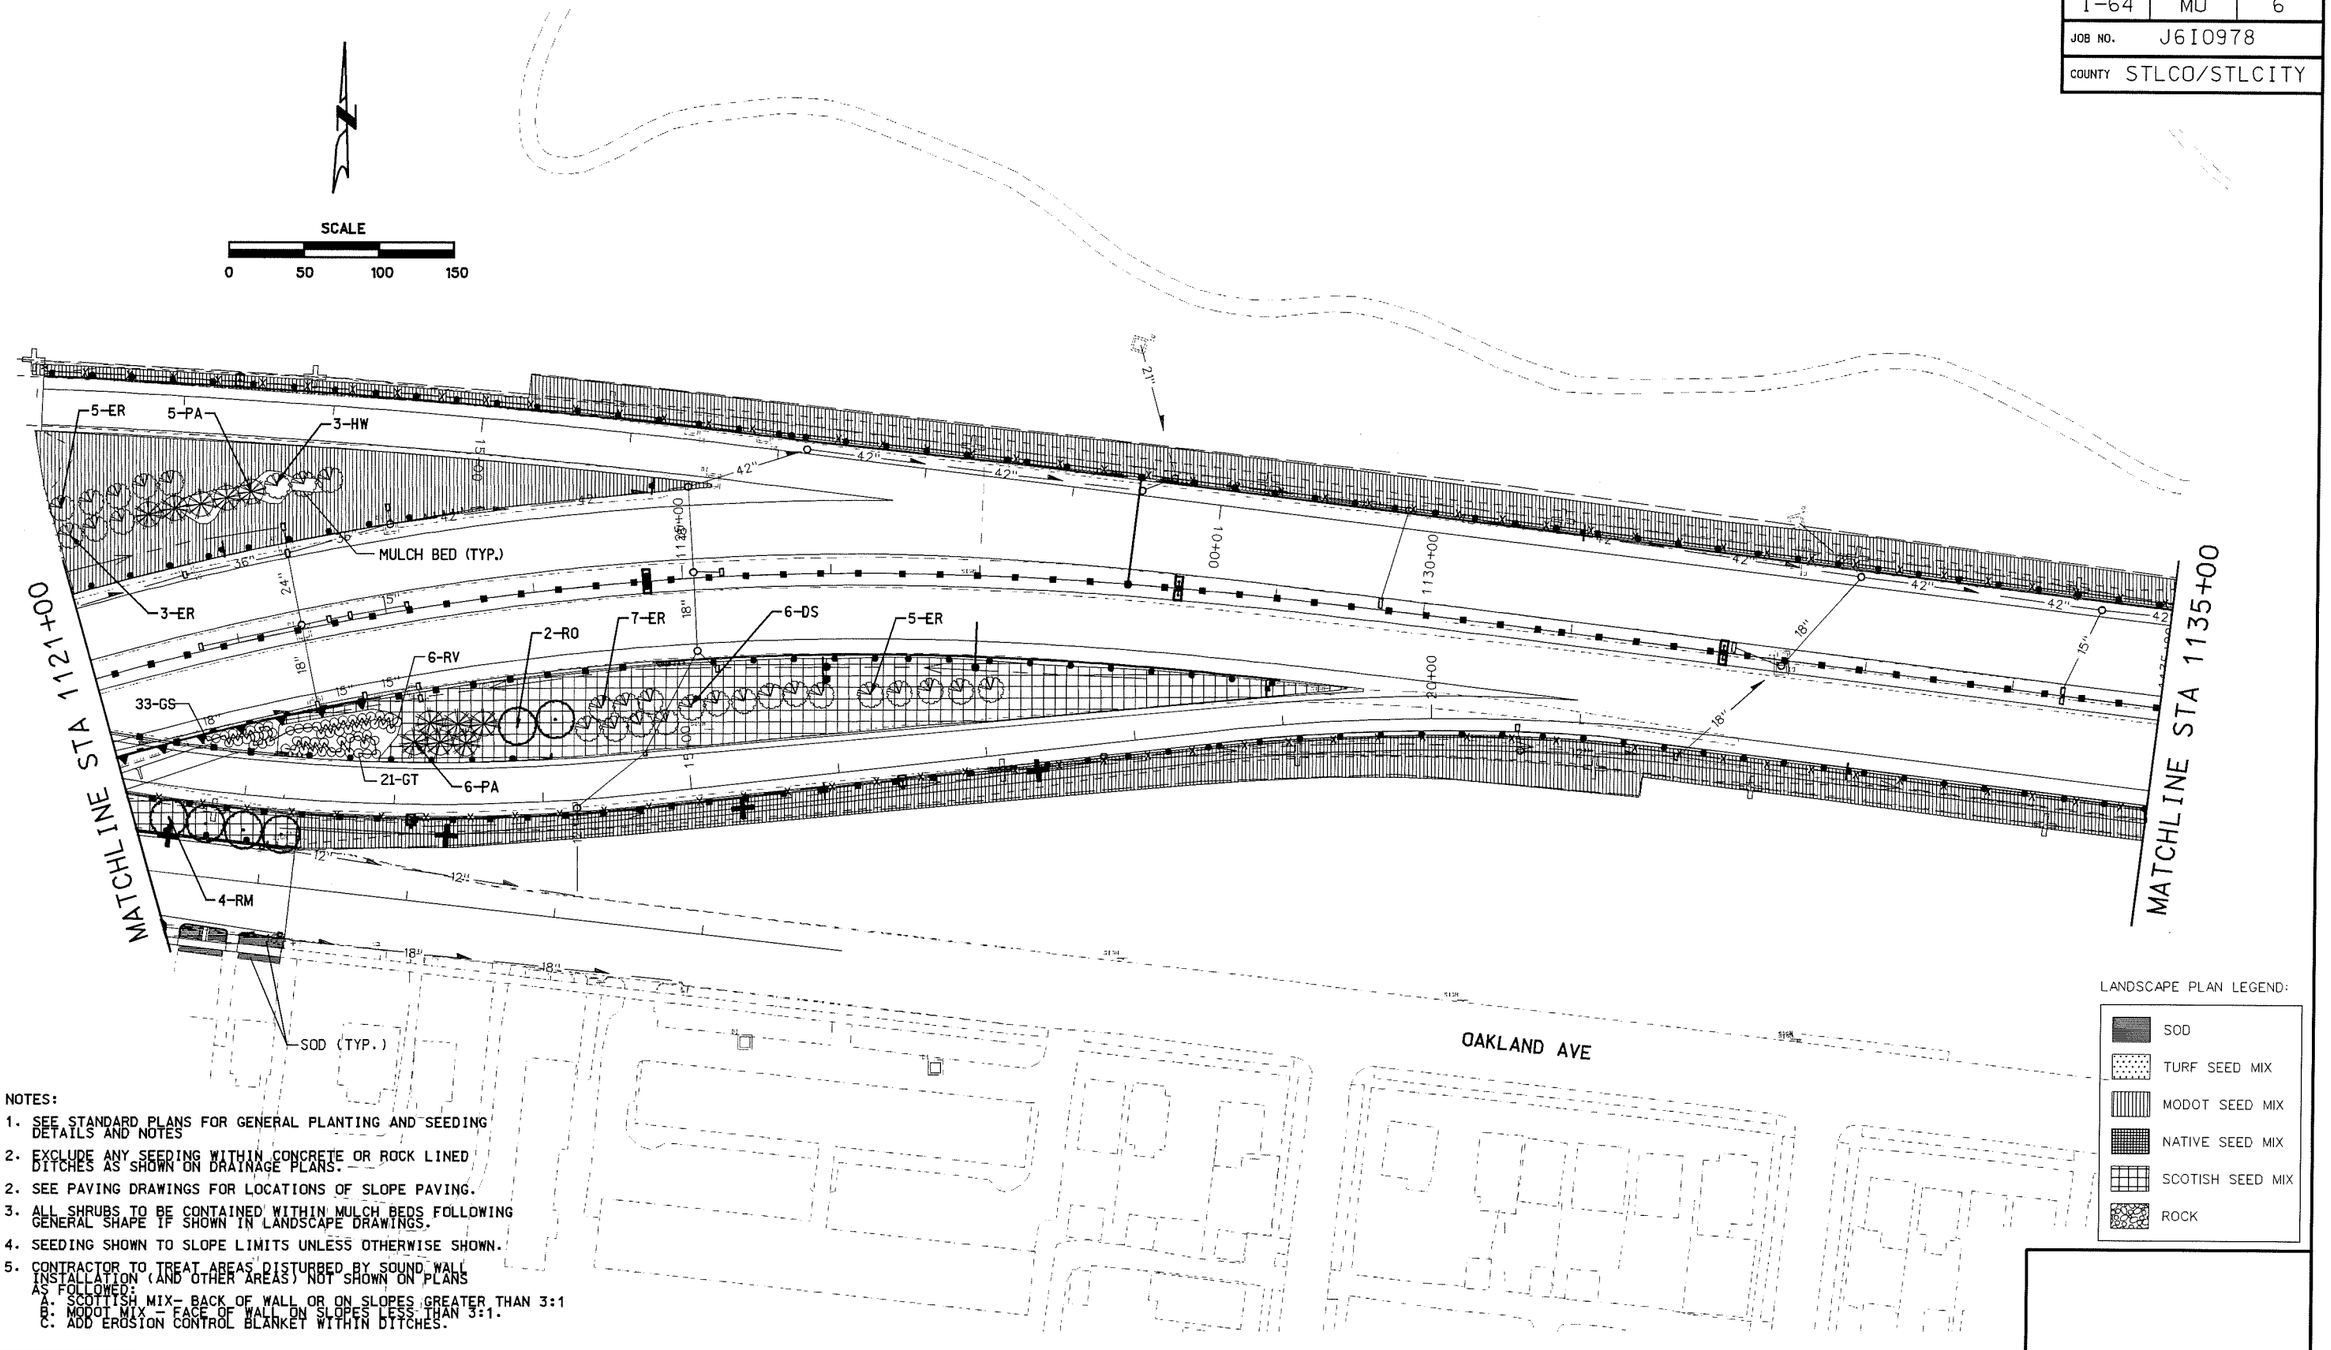

NOTES:

1. SEE STANDARD PLANS FOR GENERAL PLANTING AND SEEDING DETAILS AND NOTES
2. EXCLUDE ANY SEEDING WITHIN CONCRETE OR ROCK LINED DITCHES AS SHOWN ON DRAINAGE PLANS.
2. SEE PAVING DRAWINGS FOR LOCATIONS OF SLOPE PAVING.
3. ALL SHRUBS TO BE CONTAINED WITHIN MULCH BEDS FOLLOWING GENERAL SHAPE IF SHOWN IN LANDSCAPE DRAWINGS.
4. SEEDING SHOWN TO SLOPE LIMITS UNLESS OTHERWISE SHOWN.
5. CONTRACTOR TO TREAT AREAS DISTURBED BY SOUND WALL INSTALLATION (AND OTHER AREAS) NOT SHOWN ON PLANS AS FOLLOWED:
   A. SCOTTISH MIX- BACK OF WALL OR ON SLOPES GREATER THAN 3:1
   B. MODOT MIX - FACE OF WALL OR ON SLOPES LESS THAN 3:1.
   C. ADD EROSION CONTROL BLANKET WITHIN DITCHES.

LANDSCAPE PLAN LEGEND:

- SOD
- TURF SEED MIX
- MODOT SEED MIX
- NATIVE SEED MIX
- SCOTISH SEED MIX
- ROCK

DESIGNED BY: AT	ISSUE RECORD		
	NO.	DESCRIPTION	DATE
DRAFTED BY: BQ	1	RELEASED FOR CONSTRUCTION	30NOV07
	AB	AS-BUILT	14JUN10
CHECKED BY: JC			

PARSONS

Gateway Constructors
Granite • Fred Weber • Millstone Bangert

THE NEW I-64

THE NEW I-64 PROJECT
SEGMENT 3
LANDSCAPE PLAN
I-64/40
STA 1121+00.00 TO STA 1135+00.00

MoDOT

DRAWING NUMBER
LPPL004

AS-BUILT

File Name: C:\EXPORT\ITEMP\004_LPPL_I100_S3.DGN
User: PARSONS
Time Plotted: 2:04:34 PM
Date Plotted: 7/16/2010
Pen Table: I-64_HALFSIZEBW-DATE.TBL
Plot Driver: 11X17_PDF_AB.PLT

ROUTE	STATE	DISTRICT
I-64	MO	6
JOB NO.	J6I0978	
COUNTY	STLCO/STLCITY	

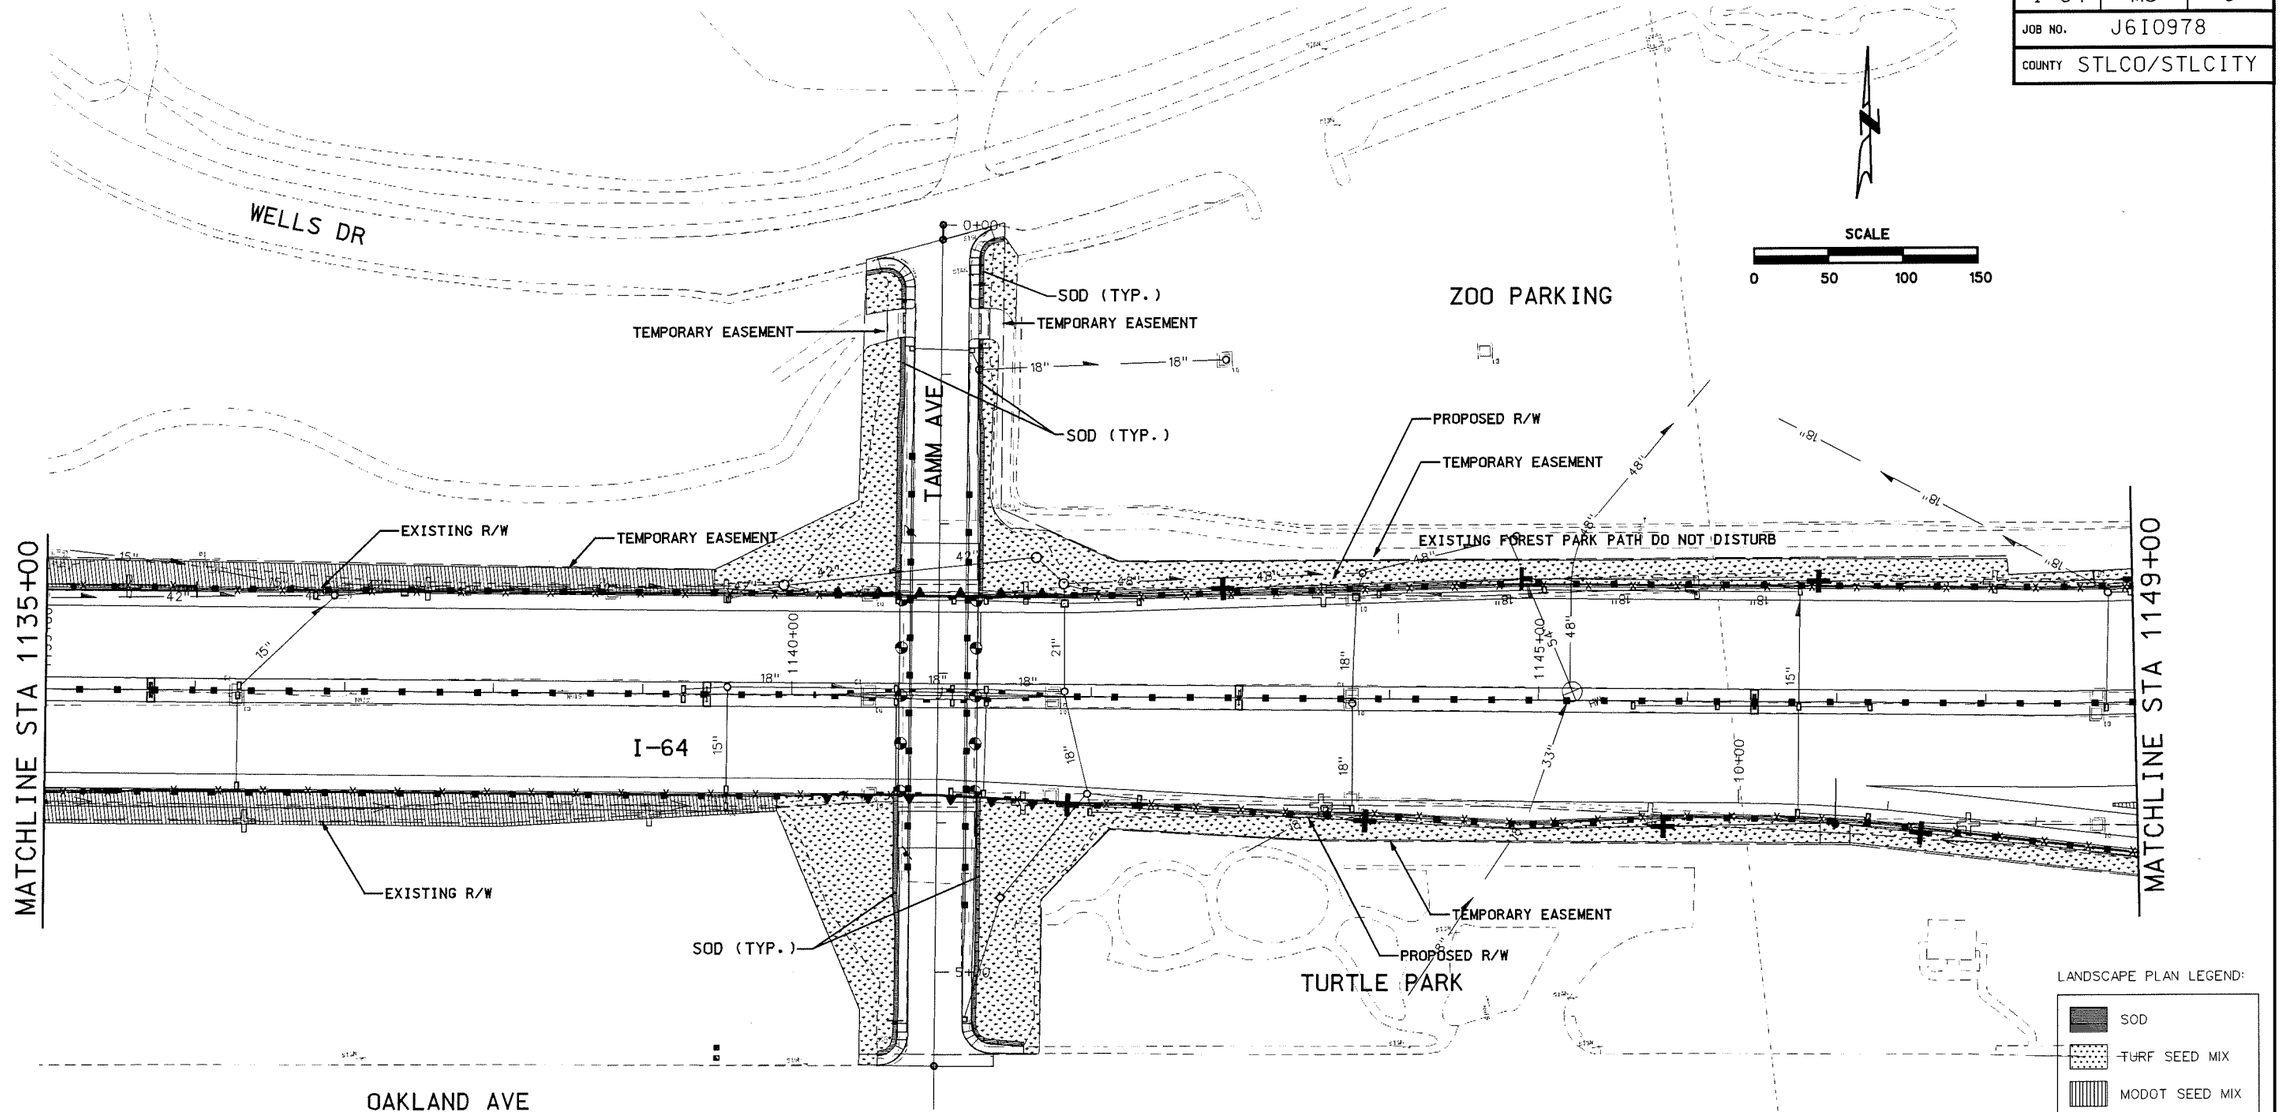

LANDSCAPE PLAN LEGEND:

- SOD
- TURF SEED MIX
- MODOT SEED MIX
- NATIVE SEED MIX
- SCOTISH SEED MIX
- ROCK

NOTES:

1. SEE STANDARD PLANS FOR GENERAL PLANTING AND SEEDING DETAILS AND NOTES
2. EXCLUDE ANY SEEDING WITHIN CONCRETE OR ROCK LINED DITCHES AS SHOWN ON DRAINAGE PLANS.
2. SEE PAVING DRAWINGS FOR LOCATIONS OF SLOPE PAVING.
3. ALL SHRUBS TO BE CONTAINED WITHIN MULCH BEDS FOLLOWING GENERAL SHAPE IF SHOWN IN LANDSCAPE DRAWINGS.
4. SEEDING SHOWN TO SLOPE LIMITS UNLESS OTHERWISE SHOWN.
5. CONTRACTOR TO TREAT AREAS DISTURBED BY SOUND WALL INSTALLATION (AND OTHER AREAS) NOT SHOWN ON PLANS AS FOLLOWED:
   A. SCOTTISH MIX- BACK OF WALL OR ON SLOPES GREATER THAN 3:1
   B. MODOT MIX - FACE OF WALL ON SLOPES LESS THAN 3:1.
   C. ADD EROSION CONTROL BLANKET WITHIN DITCHES.

DESIGNED BY:	AT
DRAFTED BY:	BQ
CHECKED BY:	JC

ISSUE RECORD

NO.	DESCRIPTION	DATE
1	RELEASED FOR CONSTRUCTION	30NOV07
AB	AS-BUILT	14JUN10

PARSONS

Gateway Constructors
Granite • Fred Weber • Millstone Bangert

THE NEW I-64

THE NEW I-64 PROJECT
SEGMENT 3
LANDSCAPE PLAN
I-64
STA 1135+00 TO STA 1149+00

MoDOT

DRAWING NUMBER
LPPL005

AS-BUILT

File Name: C:\EXPORT\ITEMP\005_LPPL_I100_S3.DGN
User: PARSONS
Time Plotted: 2:04:43 PM
Date Plotted: 7/16/2010
Pen Table: I-64_HALFSIZEBW-DATE.TBL Plot Driver: 11X17_PDF_AB.PLT

ROUTE	STATE	DISTRICT
I-64	MO	6
JOB NO.	J6I0978	
COUNTY	STLCO/STLCITY	

IRRIGATION SLEEVE (IS) LOCATION TABLE							
SLEEVE #	HCL	STATION	OFFSET	SLEEVE #	HCL	STATION	OFFSET
1	RAMP5	54+14.84	29.0' LT	9	HAMPTON	12+58.23	100.8' RT
	RAMP5	54.14.84	20.0' RT		HAMPTON	12+19.44	139.3' RT
2	HAMPTON	9+44.53	88.9' LT	10	HAMPTON	12+47.07	66.0' LT
	HAMPTON	8+82.27	115.1' LT		HAMPTON	12+46.94	65.2' RT
3	HAMPTON	9+97.79	126.7' LT	11	HAMPTON	12+91.86	125.3' LT
	HAMPTON	9+62.62	92.3' LT		HAMPTON	12+55.97	106.3' LT
4	HAMPTON	9+65.54	64.7' LT	12	HAMPTON	13+76.15	108.4' RT
	HAMPTON	9+65.54	68.9' RT		HAMPTON	13+22.08	97.5' RT
5	HAMPTON	9+95.23	125.3' RT	13	HAMPTON	13+86.35	103.1' LT
	HAMPTON	9+51.75	98.0' RT		HAMPTON	14+21.10	51.2' RT
6	HAMPTON	9+46.17	96.3' RT	14	HAMPTON	14+53.76	105.6' LT
	HAMPTON	9+05.49	122.2' RT		HAMPTON	14+29.54	91.5' LT
7	RAMP5	61+70.89	29.0' LT	15	HAMPTON	15+23.31	98.5' RT
	RAMP5	61+70.89	18.0' RT		HAMPTON	14+97.86	114.4' RT
8	HAMPTON	12+42.91	107.6' LT	16	I-64	1163+75.53	76.0' LT
	HAMPTON	12+06.25	138.8' LT		I-64	1163+79.07	76.5' RT

NOTE: EACH IRRIGATION SLEEVE # REPRESENTS 2 - 6" SCHEDULE 40 PVC SLEEVES.

* ISLAND CENTERS SHALL BE GRADED TO A DEPTH OF 18" BELOW TOP OF CURB TO ALLOW FOR FUTURE LANDSCAPING

SCALE
0 50 100 150

MATCHLINE STA 1149+00

MATCHLINE STA 1163+00

MATCHLINE HAMPTON AVE STA 15+05

MATCHLINE HAMPTON AVE STA 07+45

OAKLAND AVE

CURB MEDIAN WITH PLANTINGS BY OTHERS

IS #1 IS #2 IS #3 IS #4 IS #5 IS #6 IS #8 IS #9 IS #10 IS #11 IS #12 IS #13 IS #14

7-ER 3-ER 3-ER 4-RO 4-RO 5-DS 3-TP 3-TP 5-TP 4-HW 4-HW 4-HW 4-HW 4-HW 4-HW 1-HW 1-HW 2-HW 3-HW 4-GT 10-GS 12-GT 14-GS 20-GS 24-GS 23-GS 19-GS 27-GT 25-GT 21-GS 16-GS 30-GT 33-GT 34-LP 37-GT 43-GT 66-GS SOD

LANDSCAPE PLAN LEGEND:

- SOD
- TURF SEED MIX
- MODOT SEED MIX
- NATIVE SEED MIX
- SCOTISH SEED MIX
- ROCK

NOTES:

1. SEE STANDARD PLANS FOR GENERAL PLANTING AND SEEDING DETAILS AND NOTES
2. EXCLUDE ANY SEEDING WITHIN CONCRETE OR ROCK LINED DITCHES AS SHOWN ON DRAINAGE PLANS.
2. SEE PAVING DRAWINGS FOR LOCATIONS OF SLOPE PAVING.
3. ALL SHRUBS TO BE CONTAINED WITHIN MULCH BEDS FOLLOWING GENERAL SHAPE IF SHOWN IN LANDSCAPE DRAWINGS.
4. SEEDING SHOWN TO SLOPE LIMITS UNLESS OTHERWISE SHOWN.
5. CONTRACTOR TO TREAT AREAS DISTURBED BY SOUND WALL INSTALLATION (AND OTHER AREAS) NOT SHOWN ON PLANS AS FOLLOWED:
   A. SCOTTISH MIX- BACK OF WALL OR ON SLOPES GREATER THAN 3:1
   B. MODOT MIX - FACE OF WALL ON SLOPES LESS THAN 3:1.
   C. ADD EROSION CONTROL BLANKET WITHIN DITCHES.

DESIGNED BY: AT	ISSUE RECORD		
	NO.	DESCRIPTION	DATE
DRAFTED BY: BQ	1	RELEASED FOR CONSTRUCTION	30NOV07
	AB	AS-BUILT FDC-204, FDC-702	14JUN10
CHECKED BY: JC			

PARSONS

Gateway Constructors
Granite • Fred Weber • Millstone Bangert

THE NEW I-64

THE NEW I-64 PROJECT

SEGEMENT 3
LANDSCAPE PLAN
I-64/40
STA 1149+00.00 TO STA 1163+00.00

MoDOT

DRAWING NUMBER
LPPL006

AS-BUILT

File Name: C:\EXPORT\ITEMP\006_LPPL_I100_S3.DGN
User: PARSONS
Time Plotted: 2:04:54 PM
Date Plotted: 7/16/2010
Pen Table: I-64_HALFSIZEBW-DATE.TBL
Plot Driver: 11X17_PDF_AB.PLT

ROUTE	STATE	DISTRICT
I-64	MO	6
JOB NO.	J6I0978	
COUNTY	STLCO/STLCITY	

SCALE
0 50 100 150

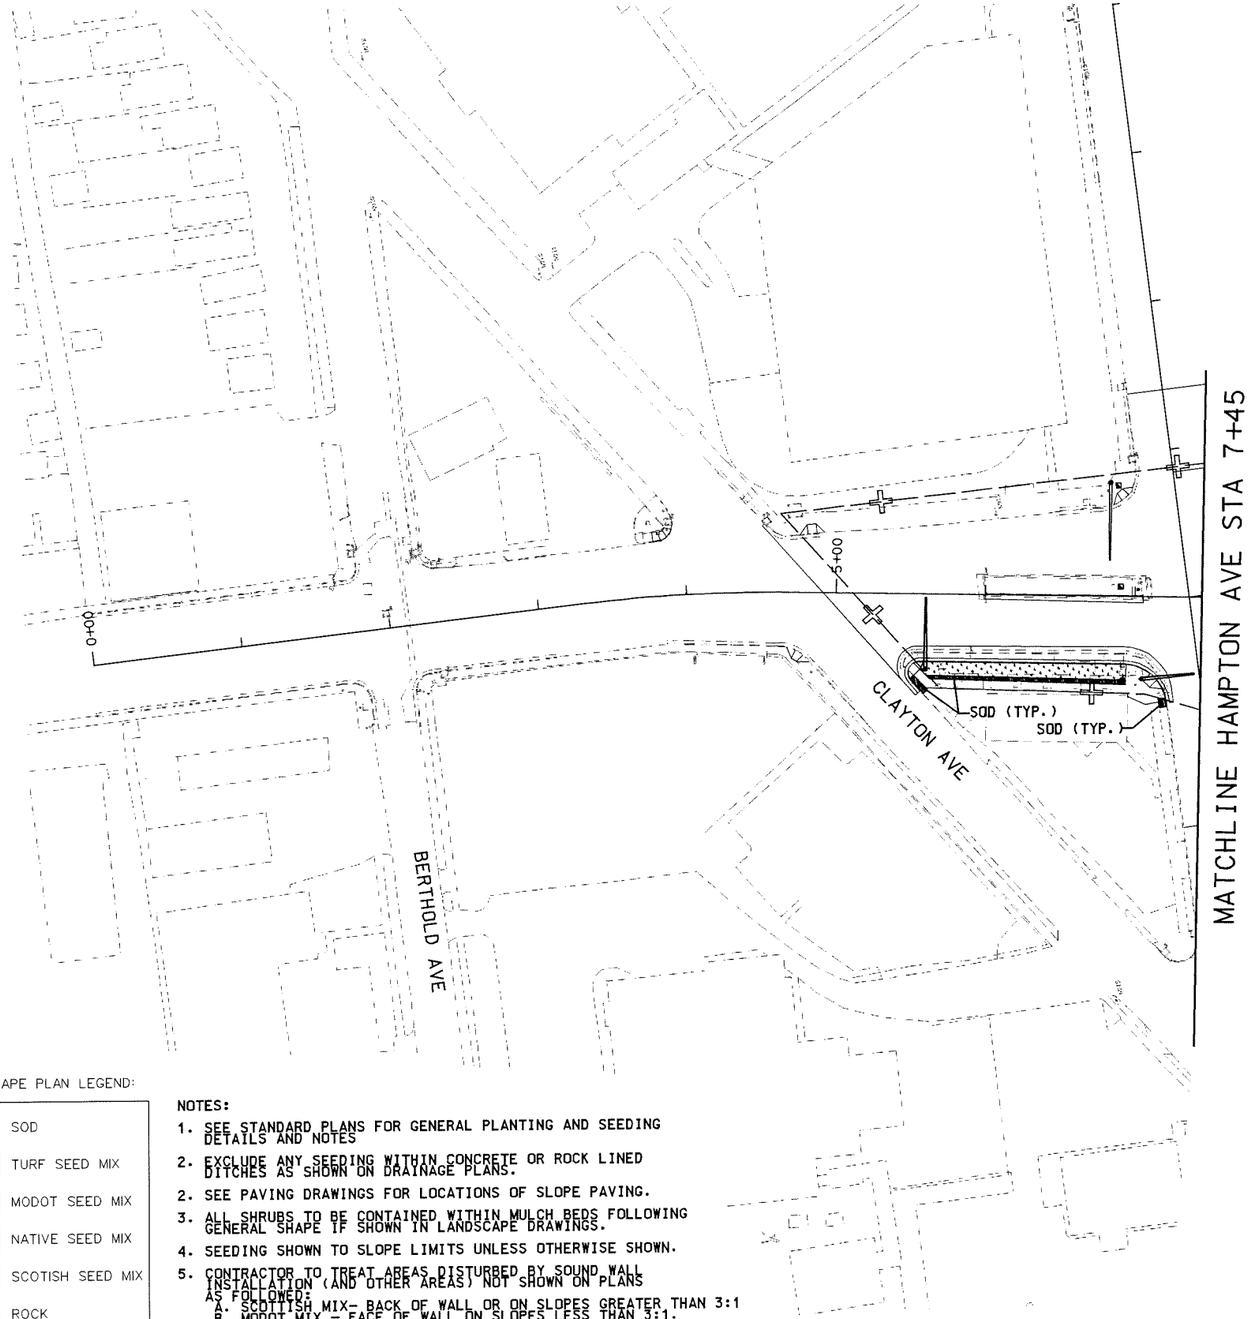

LANDSCAPE PLAN LEGEND:

- SOD
- TURF SEED MIX
- MODOT SEED MIX
- NATIVE SEED MIX
- SCOTISH SEED MIX
- ROCK

NOTES:

1. SEE STANDARD PLANS FOR GENERAL PLANTING AND SEEDING DETAILS AND NOTES
2. EXCLUDE ANY SEEDING WITHIN CONCRETE OR ROCK LINED DITCHES AS SHOWN ON DRAINAGE PLANS.
2. SEE PAVING DRAWINGS FOR LOCATIONS OF SLOPE PAVING.
3. ALL SHRUBS TO BE CONTAINED WITHIN MULCH BEDS FOLLOWING GENERAL SHAPE IF SHOWN IN LANDSCAPE DRAWINGS.
4. SEEDING SHOWN TO SLOPE LIMITS UNLESS OTHERWISE SHOWN.
5. CONTRACTOR TO TREAT AREAS DISTURBED BY SOUND WALL INSTALLATION (AND OTHER AREAS) NOT SHOWN ON PLANS AS FOLLOWED:
   A. SCOTTISH MIX- BACK OF WALL OR ON SLOPES GREATER THAN 3:1
   B. MODOT MIX - FACE OF WALL ON SLOPES LESS THAN 3:1.
   C. ADD EROSION CONTROL BLANKET WITHIN DITCHES.

DESIGNED BY: AT
DRAFTED BY: BQ
CHECKED BY: JC

ISSUE RECORD

NO.	DESCRIPTION	DATE
1	RELEASED FOR CONSTRUCTION	30NOV07
AB	AS-BUILT	14JUN10

PARSONS

Gateway Constructors
Granite • Fred Weber • Millstone Bangert

THE NEW I-64

THE NEW I-64 PROJECT
SEGMENT 3
LANDSCAPE PLAN
HAMPTON AVE / CONCOURSE
STA 0+00 TO STA 7+45

MoDOT

DRAWING NUMBER
LPPL007

AS-BUILT

Pen Table: I-64_HALFSIZEBW-DATE.TBLPlot Driver: 11X17_PDF_AB.PLT
Date Plotted: 7/16/2010
Time Plotted: 2:05:10 PM
File Name: C:\EXPORT\ITEMP\007_LPPL_I100_S3.DGN
User: PARSONS

ROUTE	STATE	DISTRICT
I-64	MO	6
JOB NO.	J6I0978	
COUNTY	STLCO/STLCITY	

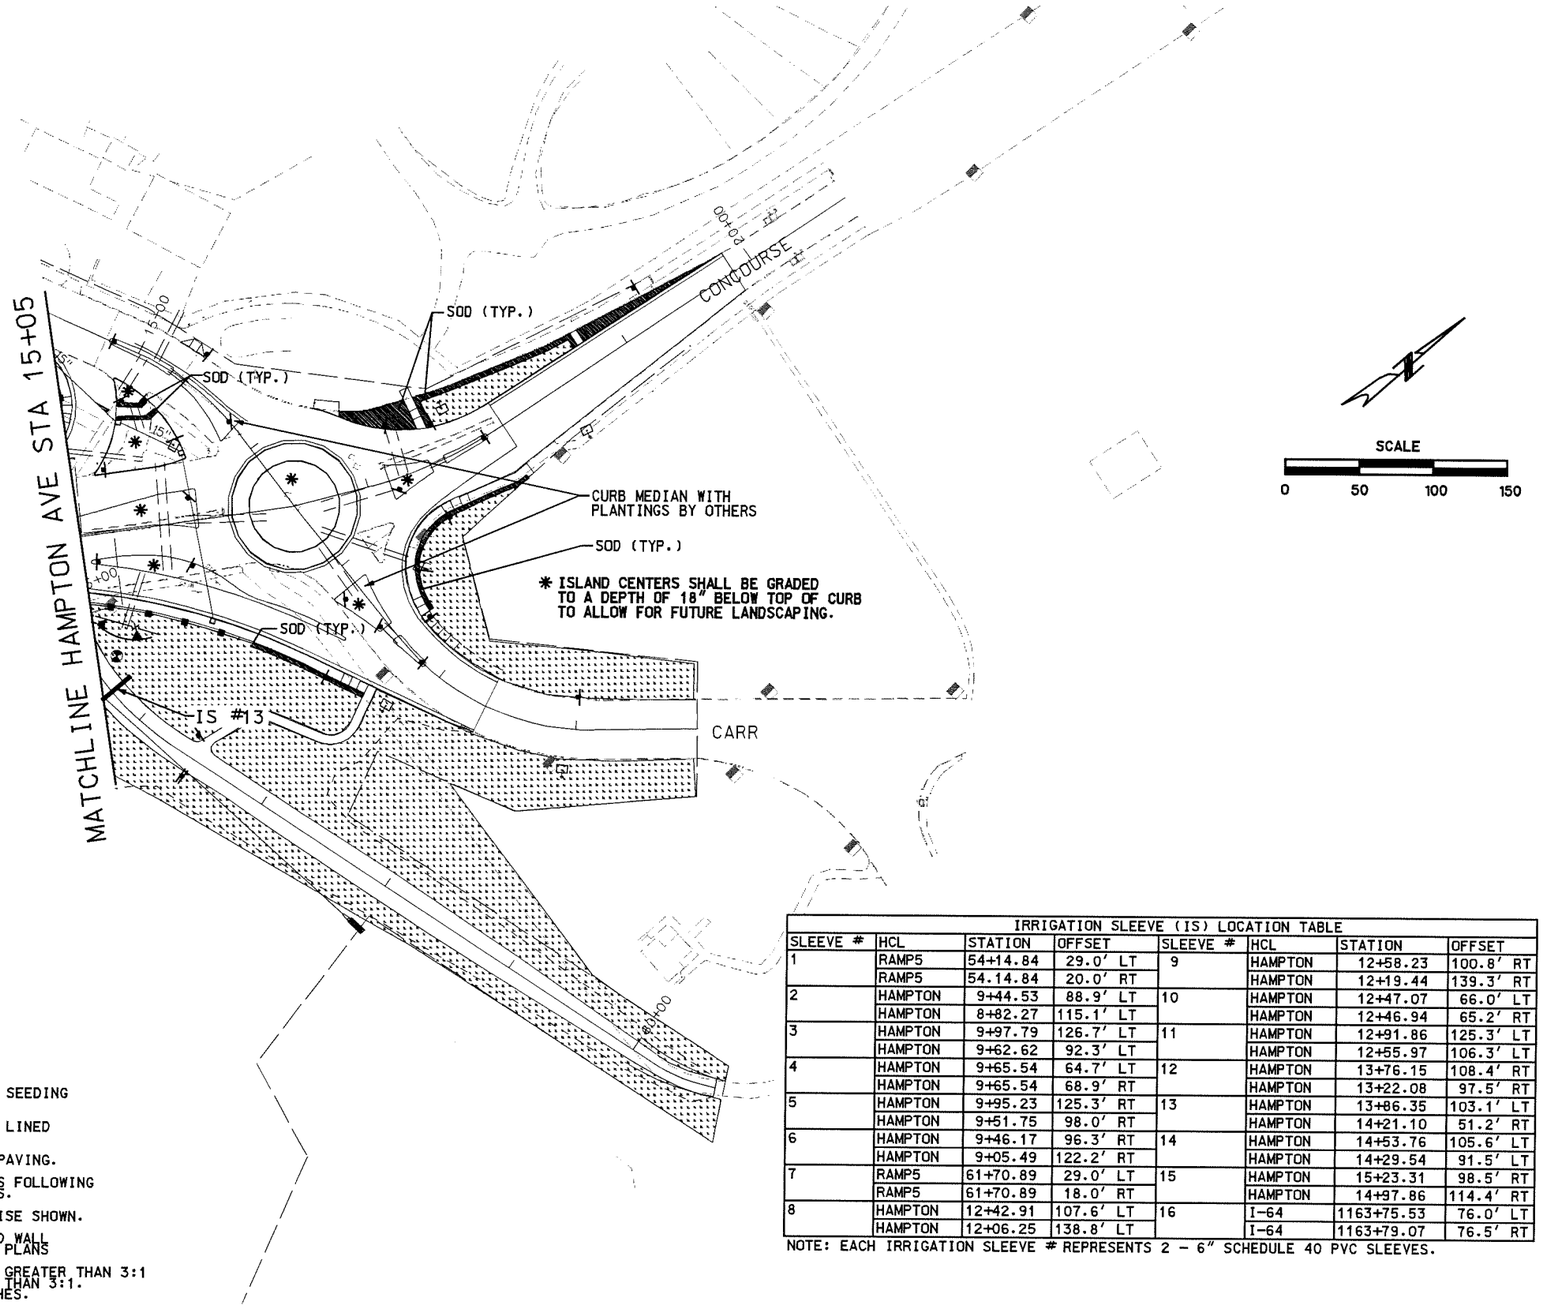

IRRIGATION SLEEVE (IS) LOCATION TABLE							
SLEEVE #	HCL	STATION	OFFSET	SLEEVE #	HCL	STATION	OFFSET
1	RAMP5	54+14.84	29.0' LT	9	HAMPTON	12+58.23	100.8' RT
	RAMP5	54.14.84	20.0' RT		HAMPTON	12+19.44	139.3' RT
2	HAMPTON	9+44.53	88.9' LT	10	HAMPTON	12+47.07	66.0' LT
	HAMPTON	8+82.27	115.1' LT		HAMPTON	12+46.94	65.2' RT
3	HAMPTON	9+97.79	126.7' LT	11	HAMPTON	12+91.86	125.3' LT
	HAMPTON	9+62.62	92.3' LT		HAMPTON	12+55.97	106.3' LT
4	HAMPTON	9+65.54	64.7' LT	12	HAMPTON	13+76.15	108.4' RT
	HAMPTON	9+65.54	68.9' RT		HAMPTON	13+22.08	97.5' RT
5	HAMPTON	9+95.23	125.3' RT	13	HAMPTON	13+86.35	103.1' LT
	HAMPTON	9+51.75	98.0' RT		HAMPTON	14+21.10	51.2' RT
6	HAMPTON	9+46.17	96.3' RT	14	HAMPTON	14+53.76	105.6' LT
	HAMPTON	9+05.49	122.2' RT		HAMPTON	14+29.54	91.5' LT
7	RAMP5	61+70.89	29.0' LT	15	HAMPTON	15+23.31	98.5' RT
	RAMP5	61+70.89	18.0' RT		HAMPTON	14+97.86	114.4' RT
8	HAMPTON	12+42.91	107.6' LT	16	I-64	1163+75.53	76.0' LT
	HAMPTON	12+06.25	138.8' LT		I-64	1163+79.07	76.5' RT

NOTE: EACH IRRIGATION SLEEVE # REPRESENTS 2 - 6" SCHEDULE 40 PVC SLEEVES.

NOTES:

1. SEE STANDARD PLANS FOR GENERAL PLANTING AND SEEDING DETAILS AND NOTES
2. EXCLUDE ANY SEEDING WITHIN CONCRETE OR ROCK LINED DITCHES AS SHOWN ON DRAINAGE PLANS.
2. SEE PAVING DRAWINGS FOR LOCATIONS OF SLOPE PAVING.
3. ALL SHRUBS TO BE CONTAINED WITHIN MULCH BEDS FOLLOWING GENERAL SHAPE IF SHOWN IN LANDSCAPE DRAWINGS.
4. SEEDING SHOWN TO SLOPE LIMITS UNLESS OTHERWISE SHOWN.
5. CONTRACTOR TO TREAT AREAS DISTURBED BY SOUND WALL INSTALLATION (AND OTHER AREAS) NOT SHOWN ON PLANS AS FOLLOWS:
   A. SCOTTISH MIX- BACK OF WALL OR ON SLOPES GREATER THAN 3:1
   B. MODOT MIX - FACE OF WALL ON SLOPES LESS THAN 3:1.
   C. ADD EROSION CONTROL BLANKET WITHIN DITCHES.

LANDSCAPE PLAN LEGEND:

- SOD
- TURF SEED MIX
- MODOT SEED MIX
- NATIVE SEED MIX
- SCOTISH SEED MIX
- ROCK

DESIGNED BY: AT	ISSUE RECORD		
	NO.	DESCRIPTION	DATE
DRAFTED BY: BQ	1	RELEASED FOR CONSTRUCTION	30NOV07
	AB	AS-BUILT FDC-204, FDC-702	14JUN10
CHECKED BY: JC			

PARSONS

Gateway Constructors
Granite • Fred Weber • Millstone Bangert

THE NEW I-64

THE NEW I-64 PROJECT
SEGMENT 3
LANDSCAPE PLAN
HAMPTON AVE / CONCOURSE
STA 15+05 TO POE

MoDOT

DRAWING NUMBER
LPPL008

AS-BUILT

File Name: C:\EXPORT\ITEMP\008_LPPL_I100_S3.DGN
User: PARSONS
Time Plotted: 2:05:17 PM
Date Plotted: 7/16/2010
Pen Table: I-64_HALFSIZEBW-DATE.TBL
Plot Driver: 11X17_PDF_AB.PLT

ROUTE	STATE	DISTRICT
I-64	MO	6
JOB NO.	J6I0978	
COUNTY	STLCO/STLCITY	

IRRIGATION SLEEVE (IS) LOCATION TABLE							
SLEEVE #	HCL	STATION	OFFSET	SLEEVE #	HCL	STATION	OFFSET
1	RAMP5	54+14.84	29.0' LT	9	HAMPTON	12+58.23	100.8' RT
	RAMP5	54.14.84	20.0' RT		HAMPTON	12+19.44	139.3' RT
2	HAMPTON	9+44.53	88.9' LT	10	HAMPTON	12+47.07	66.0' LT
	HAMPTON	8+82.27	115.1' LT		HAMPTON	12+46.94	65.2' RT
3	HAMPTON	9+97.79	126.7' LT	11	HAMPTON	12+91.86	125.3' LT
	HAMPTON	9+62.62	92.3' LT		HAMPTON	12+55.97	106.3' LT
4	HAMPTON	9+65.54	64.7' LT	12	HAMPTON	13+76.15	108.4' RT
	HAMPTON	9+65.54	68.9' RT		HAMPTON	13+22.08	97.5' RT
5	HAMPTON	9+95.23	125.3' RT	13	HAMPTON	13+86.35	103.1' LT
	HAMPTON	9+51.75	98.0' RT		HAMPTON	14+21.10	51.2' RT
6	HAMPTON	9+46.17	96.3' RT	14	HAMPTON	14+53.76	105.6' LT
	HAMPTON	9+05.49	122.2' RT		HAMPTON	14+29.54	91.5' LT
7	RAMP5	61+70.89	29.0' LT	15	HAMPTON	15+23.31	98.5' RT
	RAMP5	61+70.89	18.0' RT		HAMPTON	14+97.86	114.4' RT
8	HAMPTON	12+42.91	107.6' LT	16	I-64	1163+75.53	76.0' LT
	HAMPTON	12+06.25	138.8' LT		I-64	1163+79.07	76.5' RT

NOTE: EACH IRRIGATION SLEEVE # REPRESENTS 2 - 6" SCHEDULE 40 PVC SLEEVES.

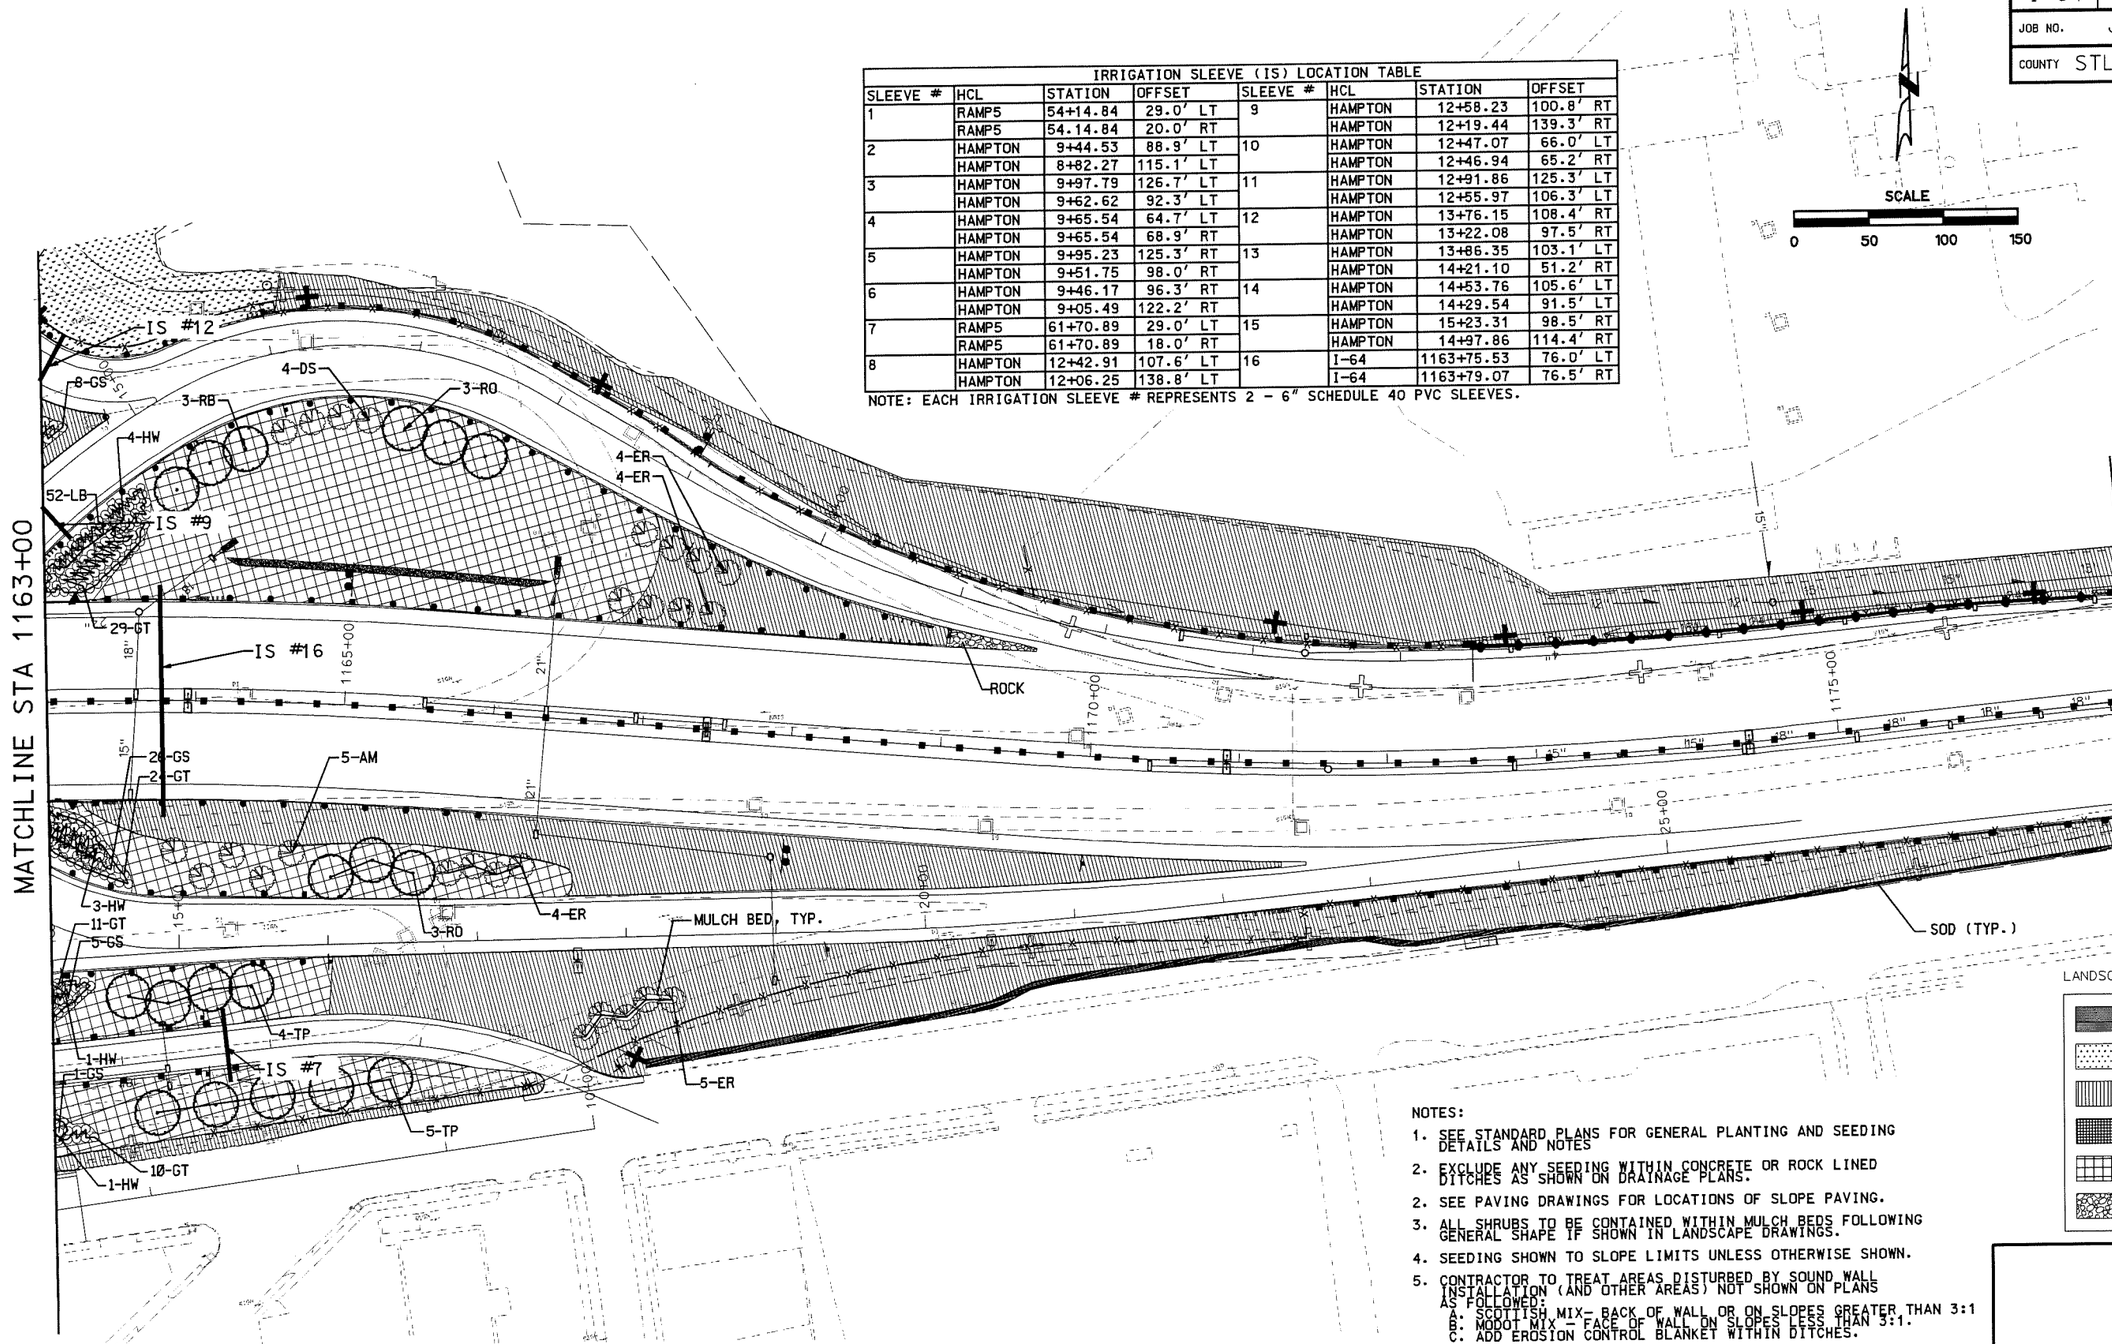

LANDSCAPE PLAN LEGEND:

- SOD
- TURF SEED MIX
- MODOT SEED MIX
- NATIVE SEED MIX
- SCOTISH SEED MIX
- ROCK

NOTES:

1. SEE STANDARD PLANS FOR GENERAL PLANTING AND SEEDING DETAILS AND NOTES
2. EXCLUDE ANY SEEDING WITHIN CONCRETE OR ROCK LINED DITCHES AS SHOWN ON DRAINAGE PLANS.
2. SEE PAVING DRAWINGS FOR LOCATIONS OF SLOPE PAVING.
3. ALL SHRUBS TO BE CONTAINED WITHIN MULCH BEDS FOLLOWING GENERAL SHAPE IF SHOWN IN LANDSCAPE DRAWINGS.
4. SEEDING SHOWN TO SLOPE LIMITS UNLESS OTHERWISE SHOWN.
5. CONTRACTOR TO TREAT AREAS DISTURBED BY SOUND WALL INSTALLATION (AND OTHER AREAS) NOT SHOWN ON PLANS AS FOLLOWED:
   A. SCOTTISH MIX- BACK OF WALL OR ON SLOPES GREATER THAN 3:1
   B. MODOT MIX - FACE OF WALL ON SLOPES LESS THAN 3:1.
   C. ADD EROSION CONTROL BLANKET WITHIN DITCHES.

AS-BUILT

DESIGNED BY: AT	ISSUE RECORD		
	NO.	DESCRIPTION	DATE
DRAFTED BY: BQ	1	RELEASED FOR CONSTRUCTION	30NOV07
	AB	AS-BUILT FDC-204	14JUN10
CHECKED BY: JC			

PARSONS

Gateway Constructors
Granite • Fred Weber • Millstone Bangert

THE NEW I-64

THE NEW I-64 PROJECT
SEGMENT 3
LANDSCAPE PLAN
I-64
STA 1163+00 TO STA 1177+00

MoDOT

DRAWING NUMBER
LPPL009

File Name: C:\EXPORT\ITEMP\009_LPPL_I100_S3.DGN
User: PARSONS
Time Plotted: 2:05:27 PM
Date Plotted: 7/16/2010
Pen Table: I-64_HALFSIZEBW-DATE.TBL
Plot Driver: 11X17_PDF_AB.PLT

ROUTE	STATE	DISTRICT
I-64	MO	6
JOB NO.	J6I0978	
COUNTY	STLCO/STLCITY	

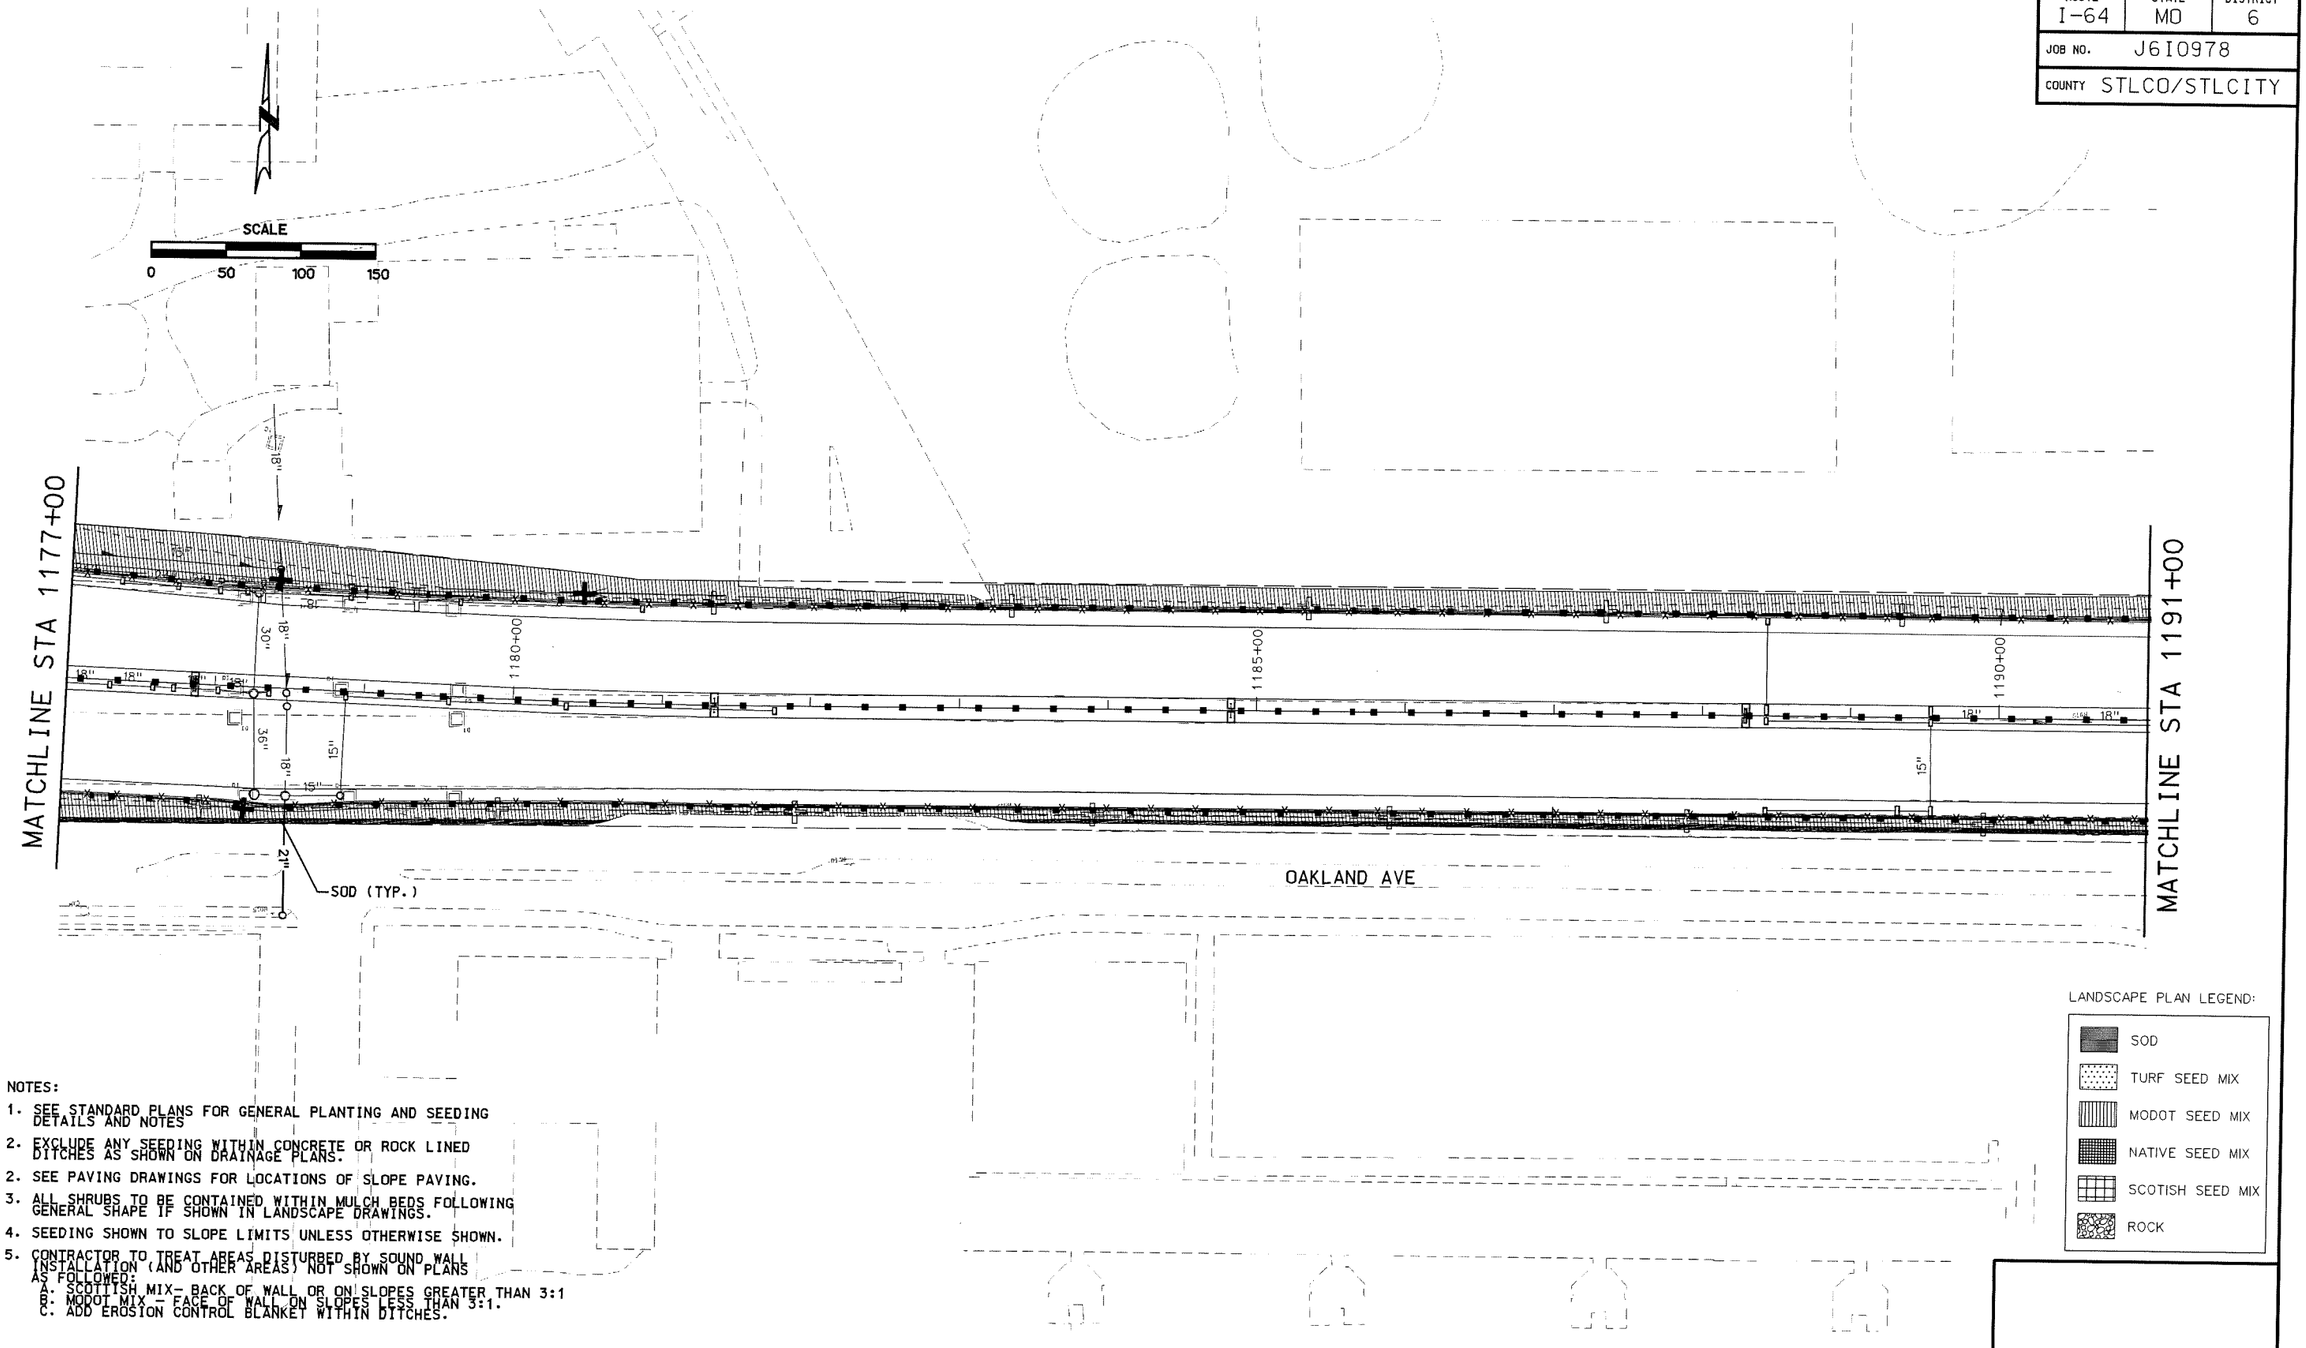

LANDSCAPE PLAN LEGEND:

- SOD
- TURF SEED MIX
- MODOT SEED MIX
- NATIVE SEED MIX
- SCOTISH SEED MIX
- ROCK

NOTES:

1. SEE STANDARD PLANS FOR GENERAL PLANTING AND SEEDING DETAILS AND NOTES
2. EXCLUDE ANY SEEDING WITHIN CONCRETE OR ROCK LINED DITCHES AS SHOWN ON DRAINAGE PLANS.
2. SEE PAVING DRAWINGS FOR LOCATIONS OF SLOPE PAVING.
3. ALL SHRUBS TO BE CONTAINED WITHIN MULCH BEDS FOLLOWING GENERAL SHAPE IF SHOWN IN LANDSCAPE DRAWINGS.
4. SEEDING SHOWN TO SLOPE LIMITS UNLESS OTHERWISE SHOWN.
5. CONTRACTOR TO TREAT AREAS DISTURBED BY SOUND WALL INSTALLATION (AND OTHER AREAS) NOT SHOWN ON PLANS AS FOLLOWED:
   A. SCOTTISH MIX- BACK OF WALL OR ON SLOPES GREATER THAN 3:1
   B. MODOT MIX - FACE OF WALL ON SLOPES LESS THAN 3:1.
   C. ADD EROSION CONTROL BLANKET WITHIN DITCHES.

DESIGNED BY: AT	ISSUE RECORD		
	NO.	DESCRIPTION	DATE
DRAFTED BY: BQ	1	RELEASED FOR CONSTRUCTION	30NOV07
	AB	AS-BUILT	14JUN10
CHECKED BY: JC			

PARSONS

Gateway Constructors
Granite • Fred Weber • Millstone Bangert

THE NEW I-64

THE NEW I-64 PROJECT
SEGMENT 3
LANDSCAPE PLAN
I-64/40
STA 1177+00.00 TO STA 1191+00.00

MoDOT

DRAWING NUMBER
LPPL010

AS-BUILT

File Name: C:\EXPORT\TEMP\010_LPPL_I100_S3.DGN
User: PARSONS
Time Plotted: 2:05:37 PM
Data Plotted: 7/16/2010
Pen Table: I-64_HALFSIZEBW-DATE.TBL
Plot Driver: 11X17_PDF_AB.PLT

ROUTE	STATE	DISTRICT
I-64	MO	6
JOB NO.	J6I0978	
COUNTY	STLCO/STLCITY	

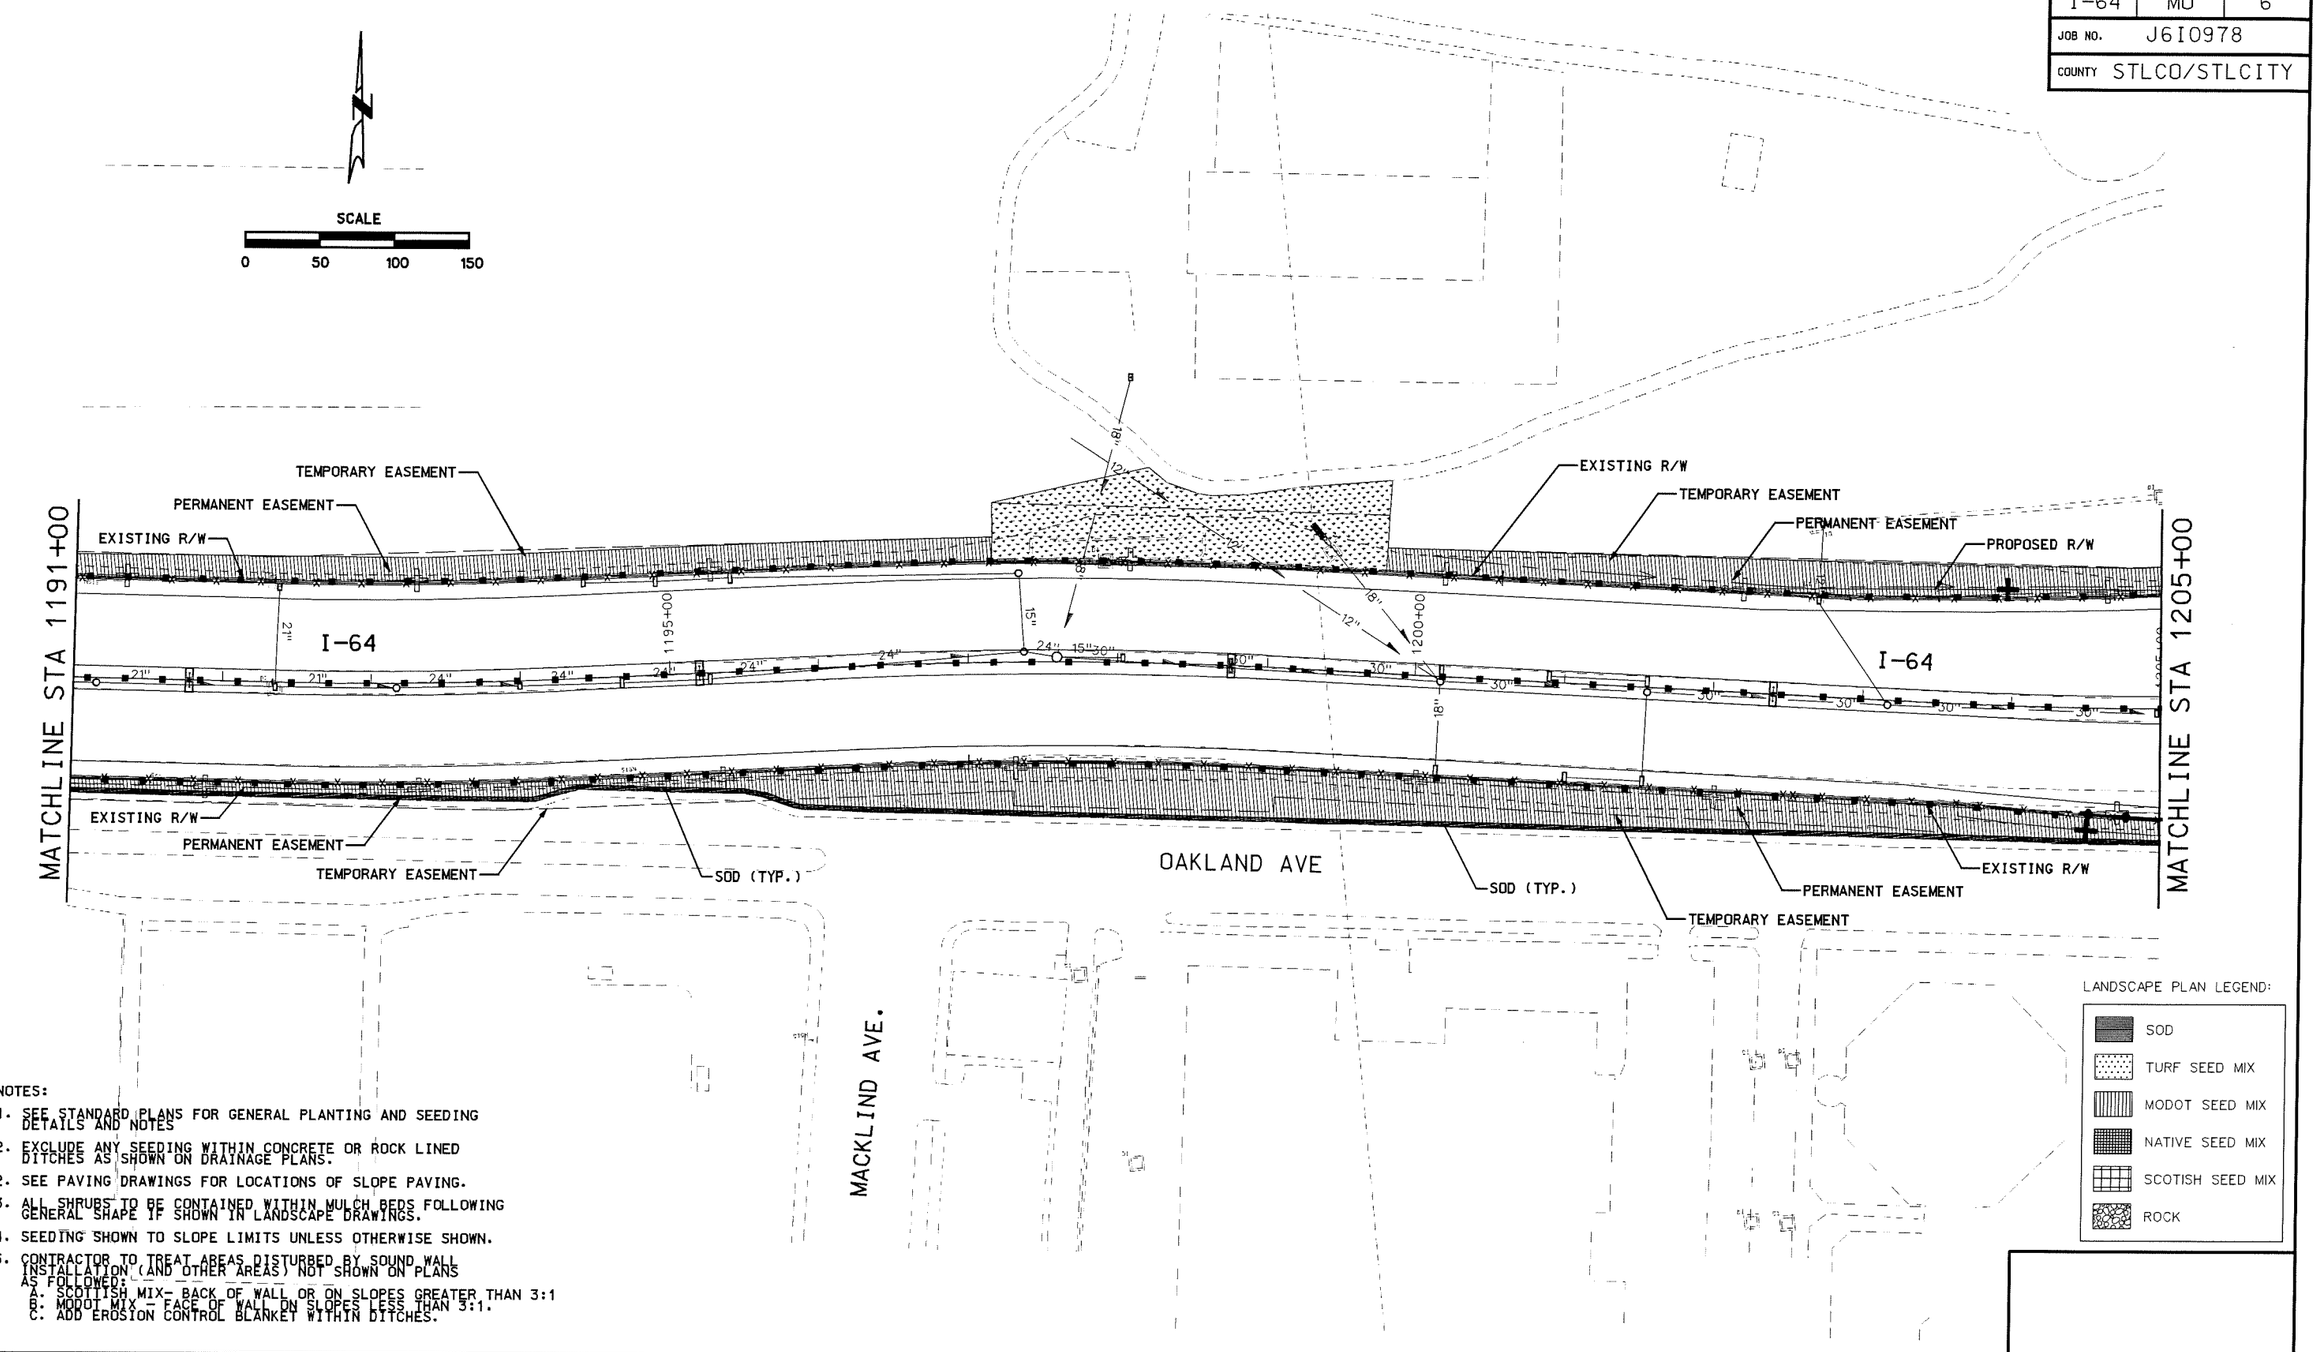

NOTES:

1. SEE STANDARD PLANS FOR GENERAL PLANTING AND SEEDING DETAILS AND NOTES
2. EXCLUDE ANY SEEDING WITHIN CONCRETE OR ROCK LINED DITCHES AS SHOWN ON DRAINAGE PLANS.
2. SEE PAVING DRAWINGS FOR LOCATIONS OF SLOPE PAVING.
3. ALL SHRUBS TO BE CONTAINED WITHIN MULCH BEDS FOLLOWING GENERAL SHAPE IF SHOWN IN LANDSCAPE DRAWINGS.
4. SEEDING SHOWN TO SLOPE LIMITS UNLESS OTHERWISE SHOWN.
5. CONTRACTOR TO TREAT AREAS DISTURBED BY SOUND WALL INSTALLATION (AND OTHER AREAS) NOT SHOWN ON PLANS AS FOLLOWED:
   A. SCOTTISH MIX- BACK OF WALL OR ON SLOPES GREATER THAN 3:1
   B. MODOT MIX - FACE OF WALL ON SLOPES LESS THAN 3:1.
   C. ADD EROSION CONTROL BLANKET WITHIN DITCHES.

LANDSCAPE PLAN LEGEND:

- SOD
- TURF SEED MIX
- MODOT SEED MIX
- NATIVE SEED MIX
- SCOTISH SEED MIX
- ROCK

DESIGNED BY:	AT
DRAFTED BY:	BQ
CHECKED BY:	JC

ISSUE RECORD

NO.	DESCRIPTION	DATE
1	RELEASED FOR CONSTRUCTION	30NOV07
AB	AS-BUILT	14JUN10

PARSONS

Gateway Constructors
Granite • Fred Weber • Millstone Bangert

THE NEW I-64

THE NEW I-64 PROJECT
SEGMENT 3
LANDSCAPE PLAN
I-64/40
STA 1191+00.00 TO STA 1205+00.00

MoDOT

DRAWING NUMBER
LPPL011

AS-BUILT

Pen Table: I-64_HALFSIZEBW-DATE.TBL|Plot Driver: 11X17_PDF_AB.PLT
Date Plotted: 7/16/2010
Time Plotted: 2:05:42 PM
File Name: C:\EXPORT\TEMP\011_LPPL_1100_S3.DGN
User: PARSONS

ROUTE	STATE	DISTRICT
I-64	MO	6
JOB NO.	J6I0978	
COUNTY	STLCO/STLCITY	

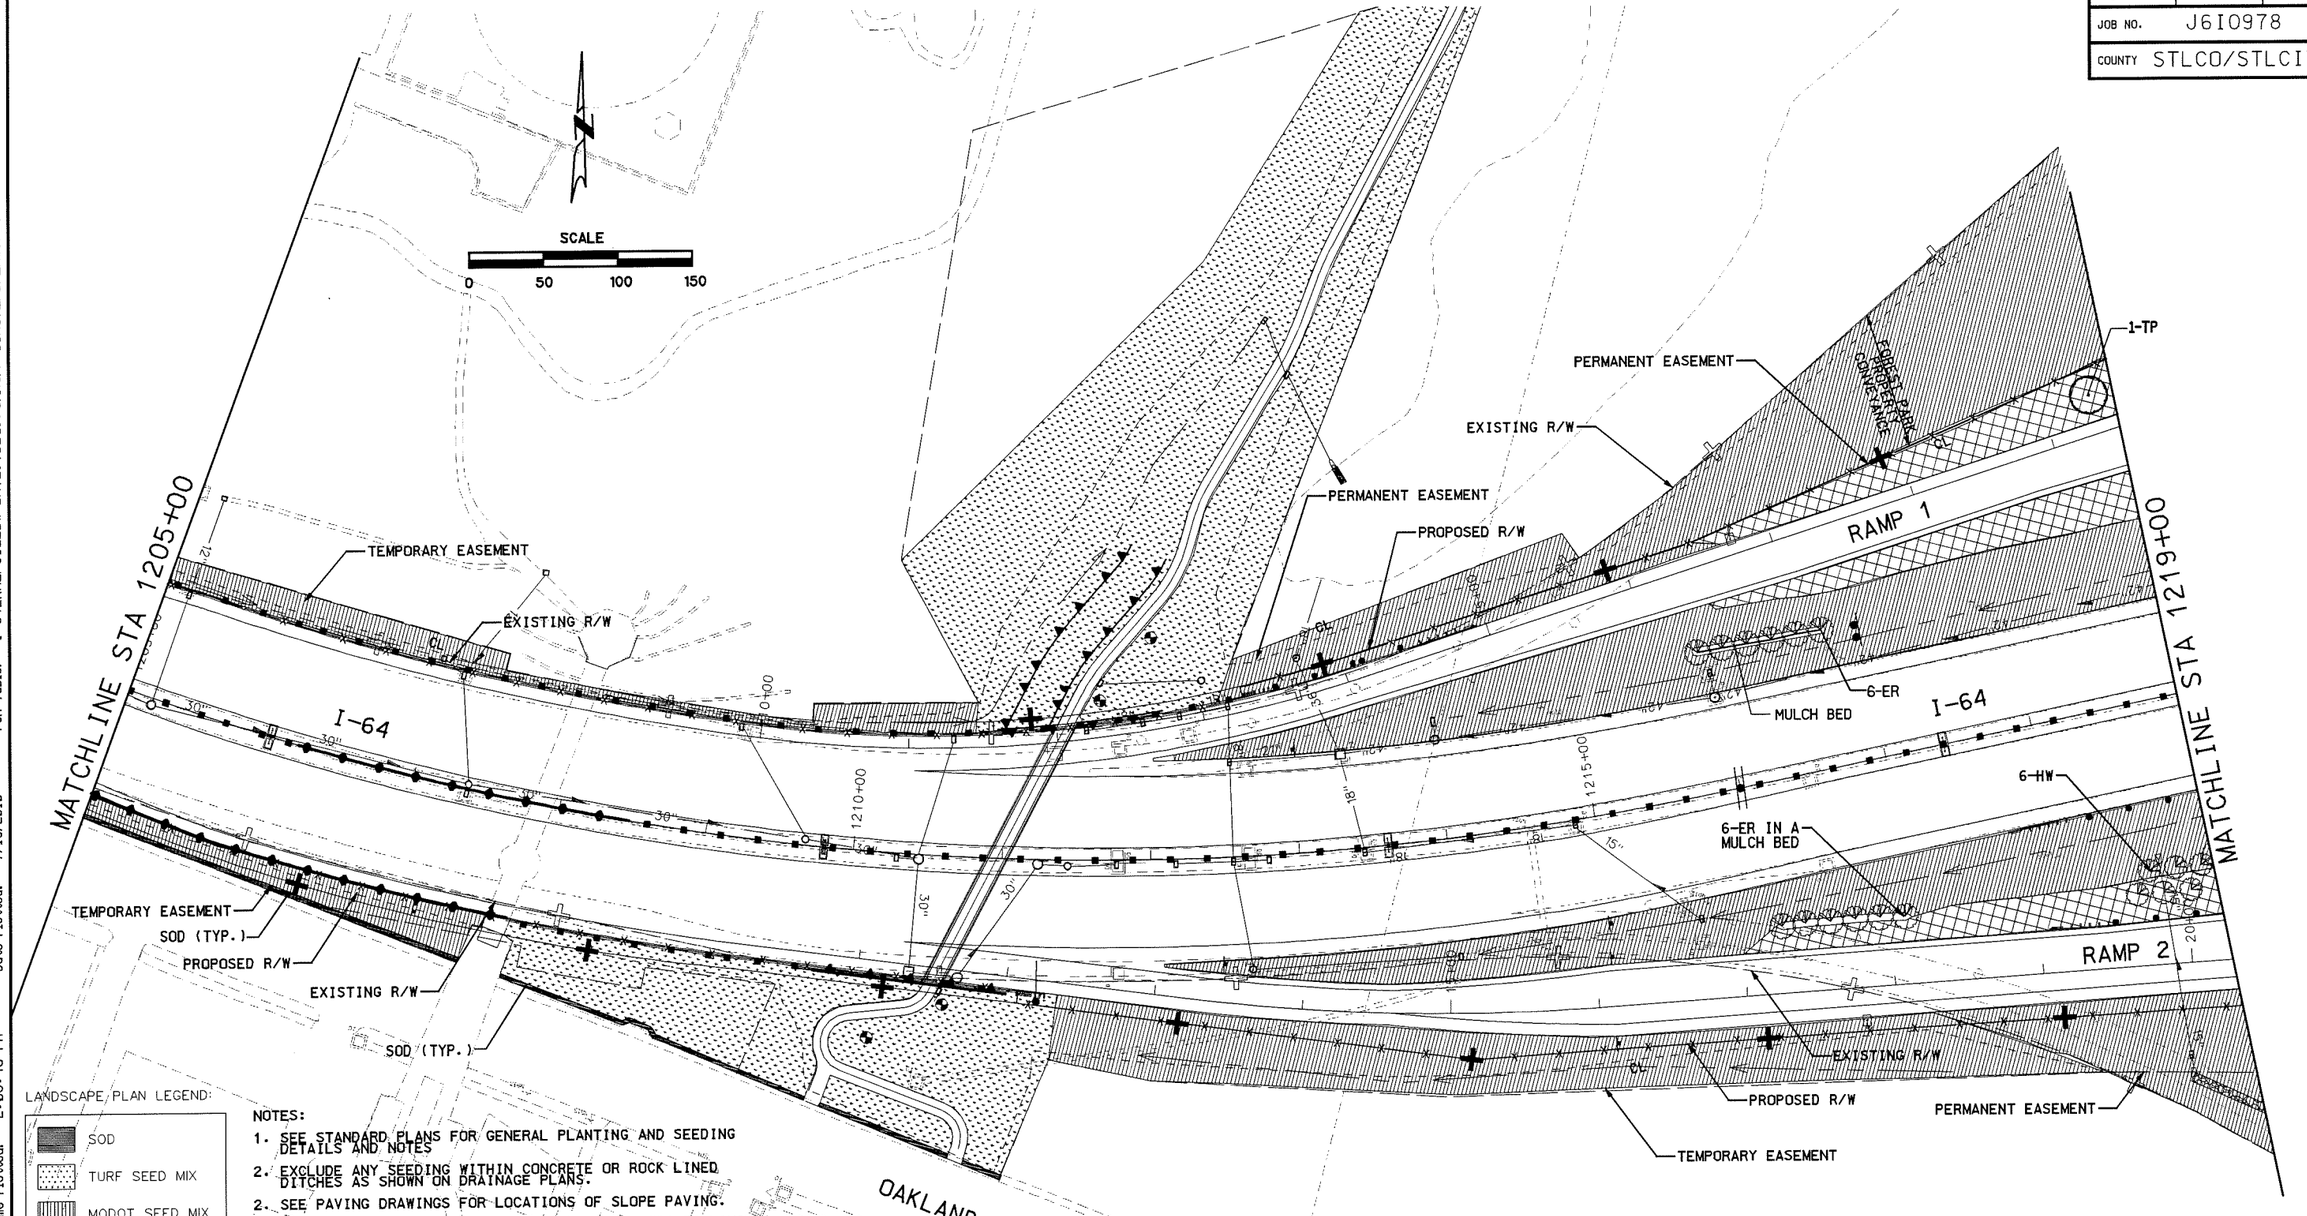

LANDSCAPE PLAN LEGEND:

- SOD
- TURF SEED MIX
- MODOT SEED MIX
- NATIVE SEED MIX
- SCOTISH SEED MIX
- ROCK

NOTES:

1. SEE STANDARD PLANS FOR GENERAL PLANTING AND SEEDING DETAILS AND NOTES
2. EXCLUDE ANY SEEDING WITHIN CONCRETE OR ROCK LINED DITCHES AS SHOWN ON DRAINAGE PLANS.
2. SEE PAVING DRAWINGS FOR LOCATIONS OF SLOPE PAVING.
3. ALL SHRUBS TO BE CONTAINED WITHIN MULCH BEDS FOLLOWING GENERAL SHAPE IF SHOWN IN LANDSCAPE DRAWINGS.
4. SEEDING SHOWN TO SLOPE LIMITS UNLESS OTHERWISE SHOWN.
5. CONTRACTOR TO TREAT AREAS DISTURBED BY SOUND WALL INSTALLATION (AND OTHER AREAS) NOT SHOWN ON PLANS AS FOLLOWED:
   A. SCOTTISH MIX- BACK OF WALL OR ON SLOPES GREATER THAN 3:1
   B. MODOT MIX - FACE OF WALL ON SLOPES LESS THAN 3:1.
   C. ADD EROSION CONTROL BLANKET WITHIN DITCHES.

DESIGNED BY:	AT
DRAFTED BY:	BQ
CHECKED BY:	JC

ISSUE RECORD

NO.	DESCRIPTION	DATE
1	RELEASED FOR CONSTRUCTION	30NOV07
AB	AS-BUILT	14JUN10

PARSONS

Gateway Constructors
Granite • Fred Weber • Millstone Bangert

THE NEW I-64

THE NEW I-64 PROJECT
SEGMENT 3
LANDSCAPE PLAN
I-64
STA 1205+00 TO STA 1219+00

MoDOT

DRAWING NUMBER
LPPL012

AS-BUILT

File Name: C:\EXPORT\ITEMP\012_LPPL_I100_S3.DGN
User: PARSONS
Time Plotted: 2:05:48 PM
Date Plotted: 7/16/2010
Pen Table: I-64_HALFSIZEBW-DATE.TBL
Plot Driver: 11X17_PDF_AB.PLT

ROUTE	STATE	DISTRICT
I-64	MO	6
JOB NO.	J6I0978	
COUNTY	STLCO/STLCITY	

MATCHLINE KINGSHIGHWAY BLVD. STA 12+00

KINGSHIGHWAY ENHANCEMENT AREA, REFER TO ALL LPDT SHEETS FOR PLANTING INFO

FOR TYPICAL TREE LAYOUT OF KINGSHIGHWAY BETTERMENT TREES, SEE 3/LPPL017

FOR TYP. PLANTING INFO ON THIS AREA SEE 1/LPPL016

1-RM
1-RO
1-RM

3-FOR PEDESTRIAN LIGHT HANGING POT PLANTING DETAIL SEE 7/LPDT001

FOR PLANTING INFO ON THIS ISLAND SEE 3/LPPL016

FOR PLANTING INFO ON THIS ISLAND SEE 2/LPPL016

FOR TYP. PLANTING INFO ON THIS AREA SEE 1/LPPL016

KEEP ROWS OF TREES 15'-0" FROM EDGE OF RAMPS, TYP

1-TP
5-DS
7-TP

EXISTING R/W

RAMP 1
RAMP 3
RAMP 4
RAMP 2

6-TP @ 30' O.C.

MATCHLINE STA 1219+00

10+00
15+00
20+00
1220+00
1225+00
1230+00

11-AH @ 11' O.C.
12-HW @ 15' O.C.
13-PL
40-GS
36-GS
8-PL
42-GS
15-PL
6-HW

I-64

KINGSHIGHWAY BLVD

5-TP @ 30' O.C.
6-RO @ 30' O.C.
8-RO
3-RO @ 27.5' O.C.

PROPOSED R/W
PERMANENT EASEMENT
EXISTING R/W
CL

KINGSHIGHWAY ENHANCEMENT AREA, REFER TO ALL LPDT SHEETS FOR PLANTING INFO

KEEP ROWS OF TREES 10'-0" FROM SIDEWALKS, 15'-0" FROM EDGE OF RAMPS, TYP

SOD (TYP.)

WALL S3-G

MATCHLINE KINGSHIGHWAY BLVD. STA 20+00

SCALE
0 50 100 150

LANDSCAPE PLAN LEGEND:
- SOD
- TURF SEED MIX
- MODOT SEED MIX
- NATIVE SEED MIX
- SCOTISH SEED MIX
- ROCK

NOTES:
1. SEE STANDARD PLANS FOR GENERAL PLANTING AND SEEDING DETAILS AND NOTES
2. EXCLUDE ANY SEEDING WITHIN CONCRETE OR ROCK LINED DITCHES AS SHOWN ON DRAINAGE PLANS.
2. SEE PAVING DRAWINGS FOR LOCATIONS OF SLOPE PAVING.
3. ALL SHRUBS TO BE CONTAINED WITHIN MULCH BEDS FOLLOWING GENERAL SHAPE IF SHOWN IN LANDSCAPE DRAWINGS.
4. SEEDING SHOWN TO SLOPE LIMITS UNLESS OTHERWISE SHOWN.
5. CONTRACTOR TO TREAT AREAS DISTURBED BY SOUND WALL INSTALLATION (AND OTHER AREAS) NOT SHOWN ON PLANS AS FOLLOWED:
   A. SCOTTISH MIX- BACK OF WALL OR ON SLOPES GREATER THAN 3:1
   B. MODOT MIX - FACE OF WALL ON SLOPES LESS THAN 3:1.
   C. ADD EROSION CONTROL BLANKET WITHIN DITCHES.

DESIGNED BY:	AT
DRAFTED BY:	BQ
CHECKED BY:	JC

ISSUE RECORD

NO.	DESCRIPTION	DATE
1	RELEASED FOR CONSTRUCTION	30NOV07
AB	AS-BUILT	14JUN10

PARSONS

Gateway Constructors
Granite • Fred Weber • Millstone Bangert

THE NEW I-64

THE NEW I-64 PROJECT
SEGMENT 3
LANDSCAPE PLAN
I-64
STA 1219+00 TO STA 1232+00

MoDOT

DRAWING NUMBER
LPPL013

AS-BUILT

File Name: C:\EXPORT\TEMP\013_LPPL_I100_S3.DGN
User: PARSONS
Time Plotted: 2:06:00 PM
Date Plotted: 7/16/2010
Pen Table: I-64_HALFSIZEBW-DATE.TBLPlot Driver: 11X17_PDF_AB.PLT

ROUTE	STATE	DISTRICT
I-64	MO	6
JOB NO.	J6I0978	
COUNTY	STLCO/STLCITY	

SCALE
0 50 100 150

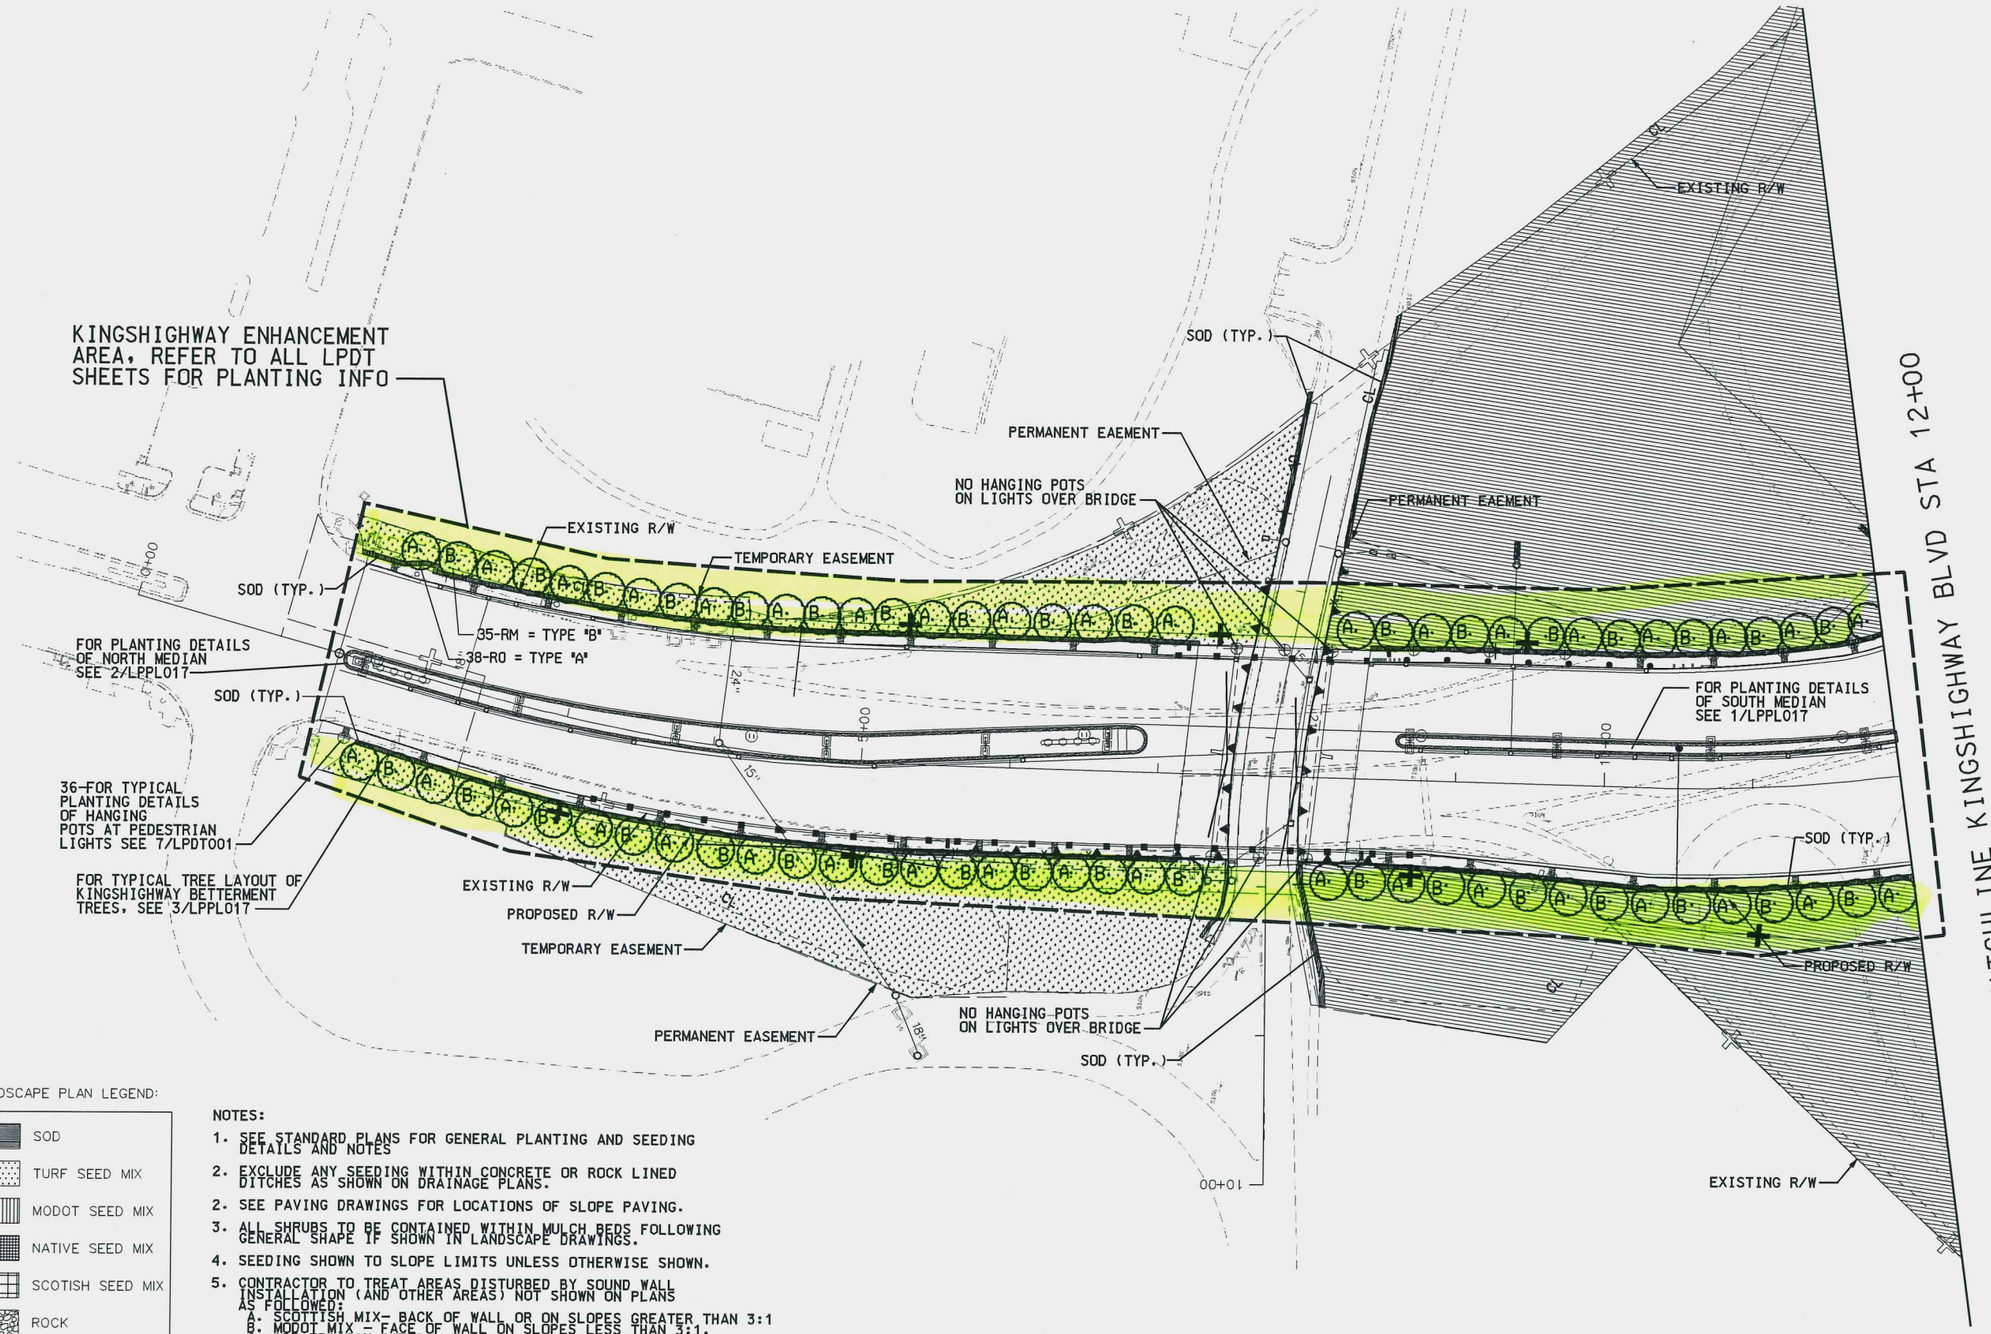

LANDSCAPE PLAN LEGEND:

- SOD
- TURF SEED MIX
- MODOT SEED MIX
- NATIVE SEED MIX
- SCOTISH SEED MIX
- ROCK

NOTES:

1. SEE STANDARD PLANS FOR GENERAL PLANTING AND SEEDING DETAILS AND NOTES
2. EXCLUDE ANY SEEDING WITHIN CONCRETE OR ROCK LINED DITCHES AS SHOWN ON DRAINAGE PLANS.
2. SEE PAVING DRAWINGS FOR LOCATIONS OF SLOPE PAVING.
3. ALL SHRUBS TO BE CONTAINED WITHIN MULCH BEDS FOLLOWING GENERAL SHAPE IF SHOWN IN LANDSCAPE DRAWINGS.
4. SEEDING SHOWN TO SLOPE LIMITS UNLESS OTHERWISE SHOWN.
5. CONTRACTOR TO TREAT AREAS DISTURBED BY SOUND WALL INSTALLATION (AND OTHER AREAS) NOT SHOWN ON PLANS AS FOLLOWED:
   A. SCOTTISH MIX- BACK OF WALL OR ON SLOPES GREATER THAN 3:1
   B. MODOT MIX - FACE OF WALL ON SLOPES LESS THAN 3:1.
   C. ADD EROSION CONTROL BLANKET WITHIN DITCHES.

DESIGNED BY:	AT
DRAFTED BY:	BQ
CHECKED BY:	JC

ISSUE RECORD

NO.	DESCRIPTION	DATE
1	RELEASED FOR CONSTRUCTION	30NOV07
AB	AS-BUILT	14JUN10

PARSONS

Gateway Constructors
Granite • Fred Weber • Millstone Bangert

THE NEW I-64

THE NEW I-64 PROJECT
SEGMENT 3
LANDSCAPE PLAN
KINGSHIGHWAY BLVD
STA 0+00 TO STA 12+00

MoDOT

DRAWING NUMBER
LPPL014

AS-BUILT

File Name: C:\EXPORT\ITEMP\014_LPPL_1100_S3.DGN
User: PARSONS
Time Plotted: 2:06:16 PM
Date Plotted: 7/16/2010
Pen Table: I-64_HALFSIZEBW-DATE.TBL
Plot Driver: 11X17_PDF_AB.PLT

ROUTE	STATE	DISTRICT
I-64	MO	6
JOB NO.	J6I0978	
COUNTY	STLCO/STLCITY	

NOTES:

1. SEE STANDARD PLANS FOR GENERAL PLANTING AND SEEDING DETAILS AND NOTES
2. EXCLUDE ANY SEEDING WITHIN CONCRETE OR ROCK LINED DITCHES AS SHOWN ON DRAINAGE PLANS.
2. SEE PAVING DRAWINGS FOR LOCATIONS OF SLOPE PAVING.
3. ALL SHRUBS TO BE CONTAINED WITHIN MULCH BEDS FOLLOWING GENERAL SHAPE IF SHOWN IN LANDSCAPE DRAWINGS.
4. SEEDING SHOWN TO SLOPE LIMITS UNLESS OTHERWISE SHOWN.
5. CONTRACTOR TO TREAT AREAS DISTURBED BY SOUND WALL INSTALLATION (AND OTHER AREAS) NOT SHOWN ON PLANS AS FOLLOWED:
   A. SCOTTISH MIX- BACK OF WALL OR ON SLOPES GREATER THAN 3:1
   B. MODOT MIX - FACE OF WALL ON SLOPES LESS THAN 3:1.
   C. ADD EROSION CONTROL BLANKET WITHIN DITCHES.

DESIGNED BY:	AT
DRAFTED BY:	BQ
CHECKED BY:	JC

ISSUE RECORD

NO.	DESCRIPTION	DATE
1	RELEASED FOR CONSTRUCTION	30NOV07
AB	AS-BUILT	14JUN10

PARSONS

Gateway Constructors
Granite • Fred Weber • Millstone Bangert

THE NEW I-64

THE NEW I-64 PROJECT
SEGMENT 3
LANDSCAPE PLAN
KINGSHIGHWAY BLVD
STA 20+00 TO POE

MoDOT

DRAWING NUMBER
LPPL015

AS-BUILT

File Name: C:\EXPORT\ITEMP\015_LPPL_I100_S3.DGN
User: PARSONS
Time Plotted: 2:06:28 PM
Date Plotted: 7/16/2010
Pen Table: I-64_HALFSIZEBW-DATE.TBLPlot Driver: 11X17_PDF_AB.PLT