EXHIBIT E – AS-BUILT PLAN

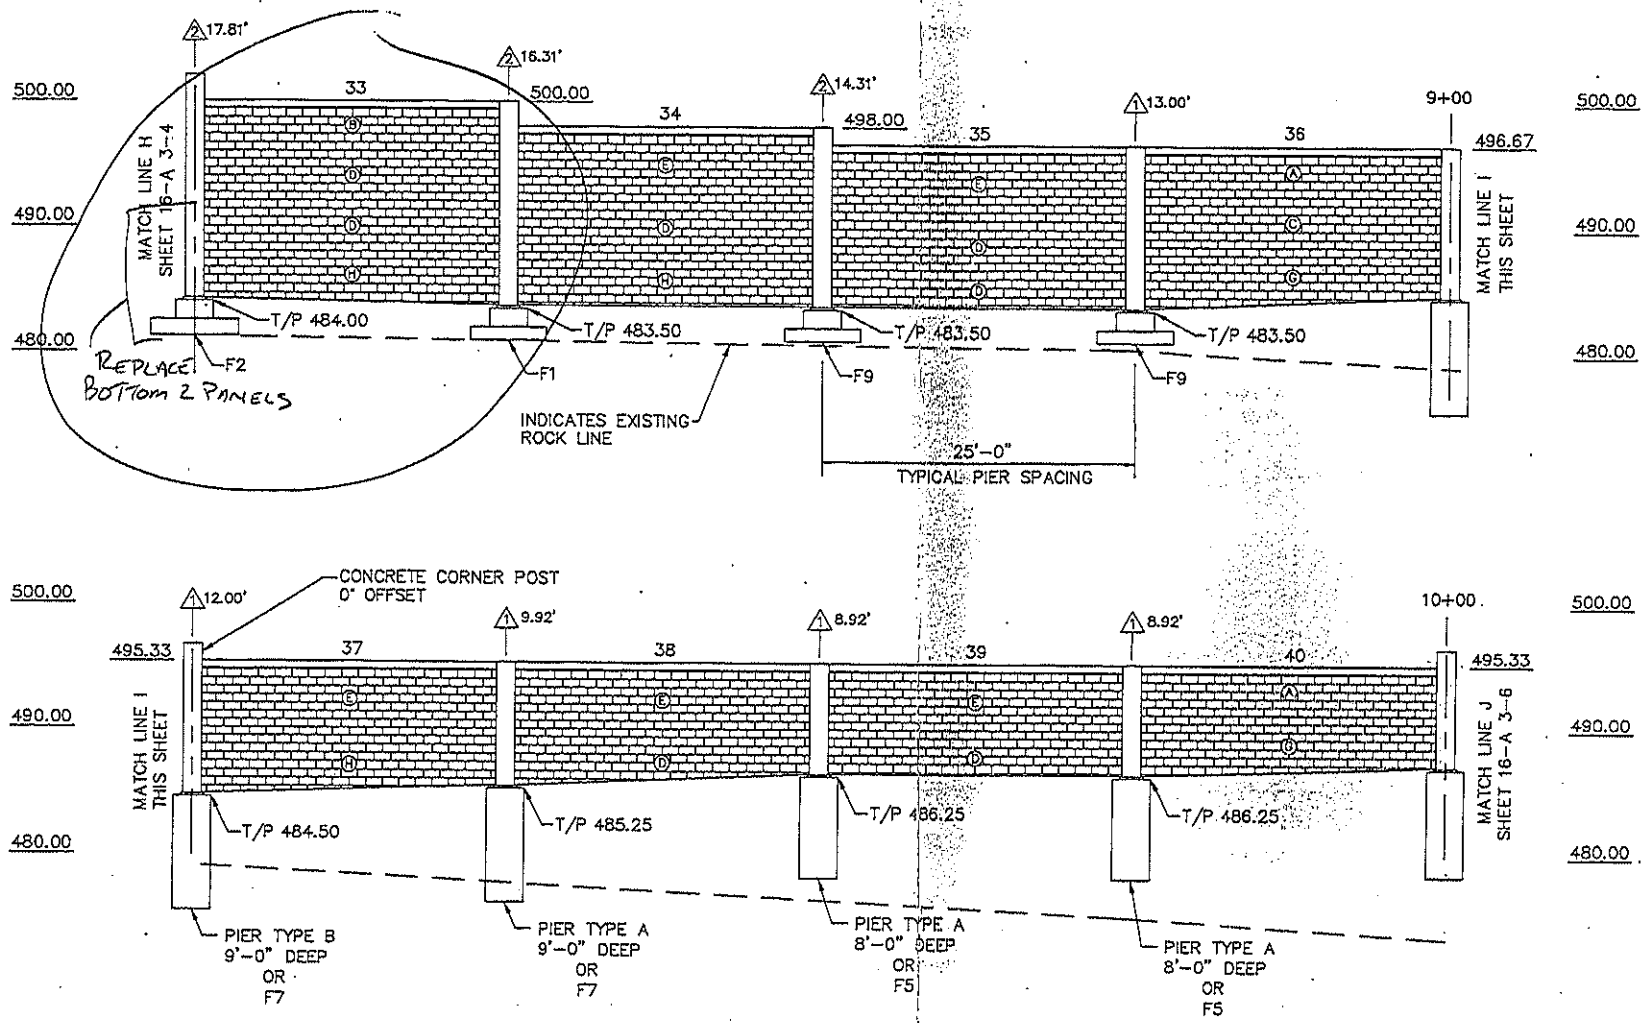

ELEVATION VIEW – SOUNDWALL – "16–A"

GRAPHIC SCALE

10' 5' 0 10'

NOTES:

1. SEE DETAIL 1/S1–1 FOR ELEVATION VIEW REFERENCES & 1/S1–2 FOR PANEL TYPE.
2. ALL PANELS & POSTS REINFORCING FOR WALL 16–A SHALL BE STANDARD UNCOATED REINFORCING.
3. ROCK LOCATION IS ESTIMATED. DISCREPANCIES EXIST BETWEEN CONTRACTOR'S SURVEYED GRADES & SOIL BORING DATA.

MoDOT JOB NO. J6I1203B

REVISIONS

STATE OF MISSOURI
TONI M. McDONOUGH
E-27511
REGISTERED PROFESSIONAL ENGINEER

DATE: 3-13-01
EXP: 12-31-02

ELEVATION VIEW - SOUNDWALL "16-A"

McCANN CONCRETE PRODUCTS
8709 ROUTE 159
DORSEY, ILLINOIS 62021
PHONE: (618) 377-3888

McDonough-Whitlow
Consulting Engineers
138 East Wood Street
Hillsboro, IL 62049
Phone: 217.532.9233
Fax: 217.532.6300

DESIGNED BY G.W.W.	JOB NO. 00–055
DRAWN BY J.L.M.	SHEET NO. 16–A
CHECKED BY T.M.M.	3–5
DATE 3–13–01	